


August & Josephine Piazza.

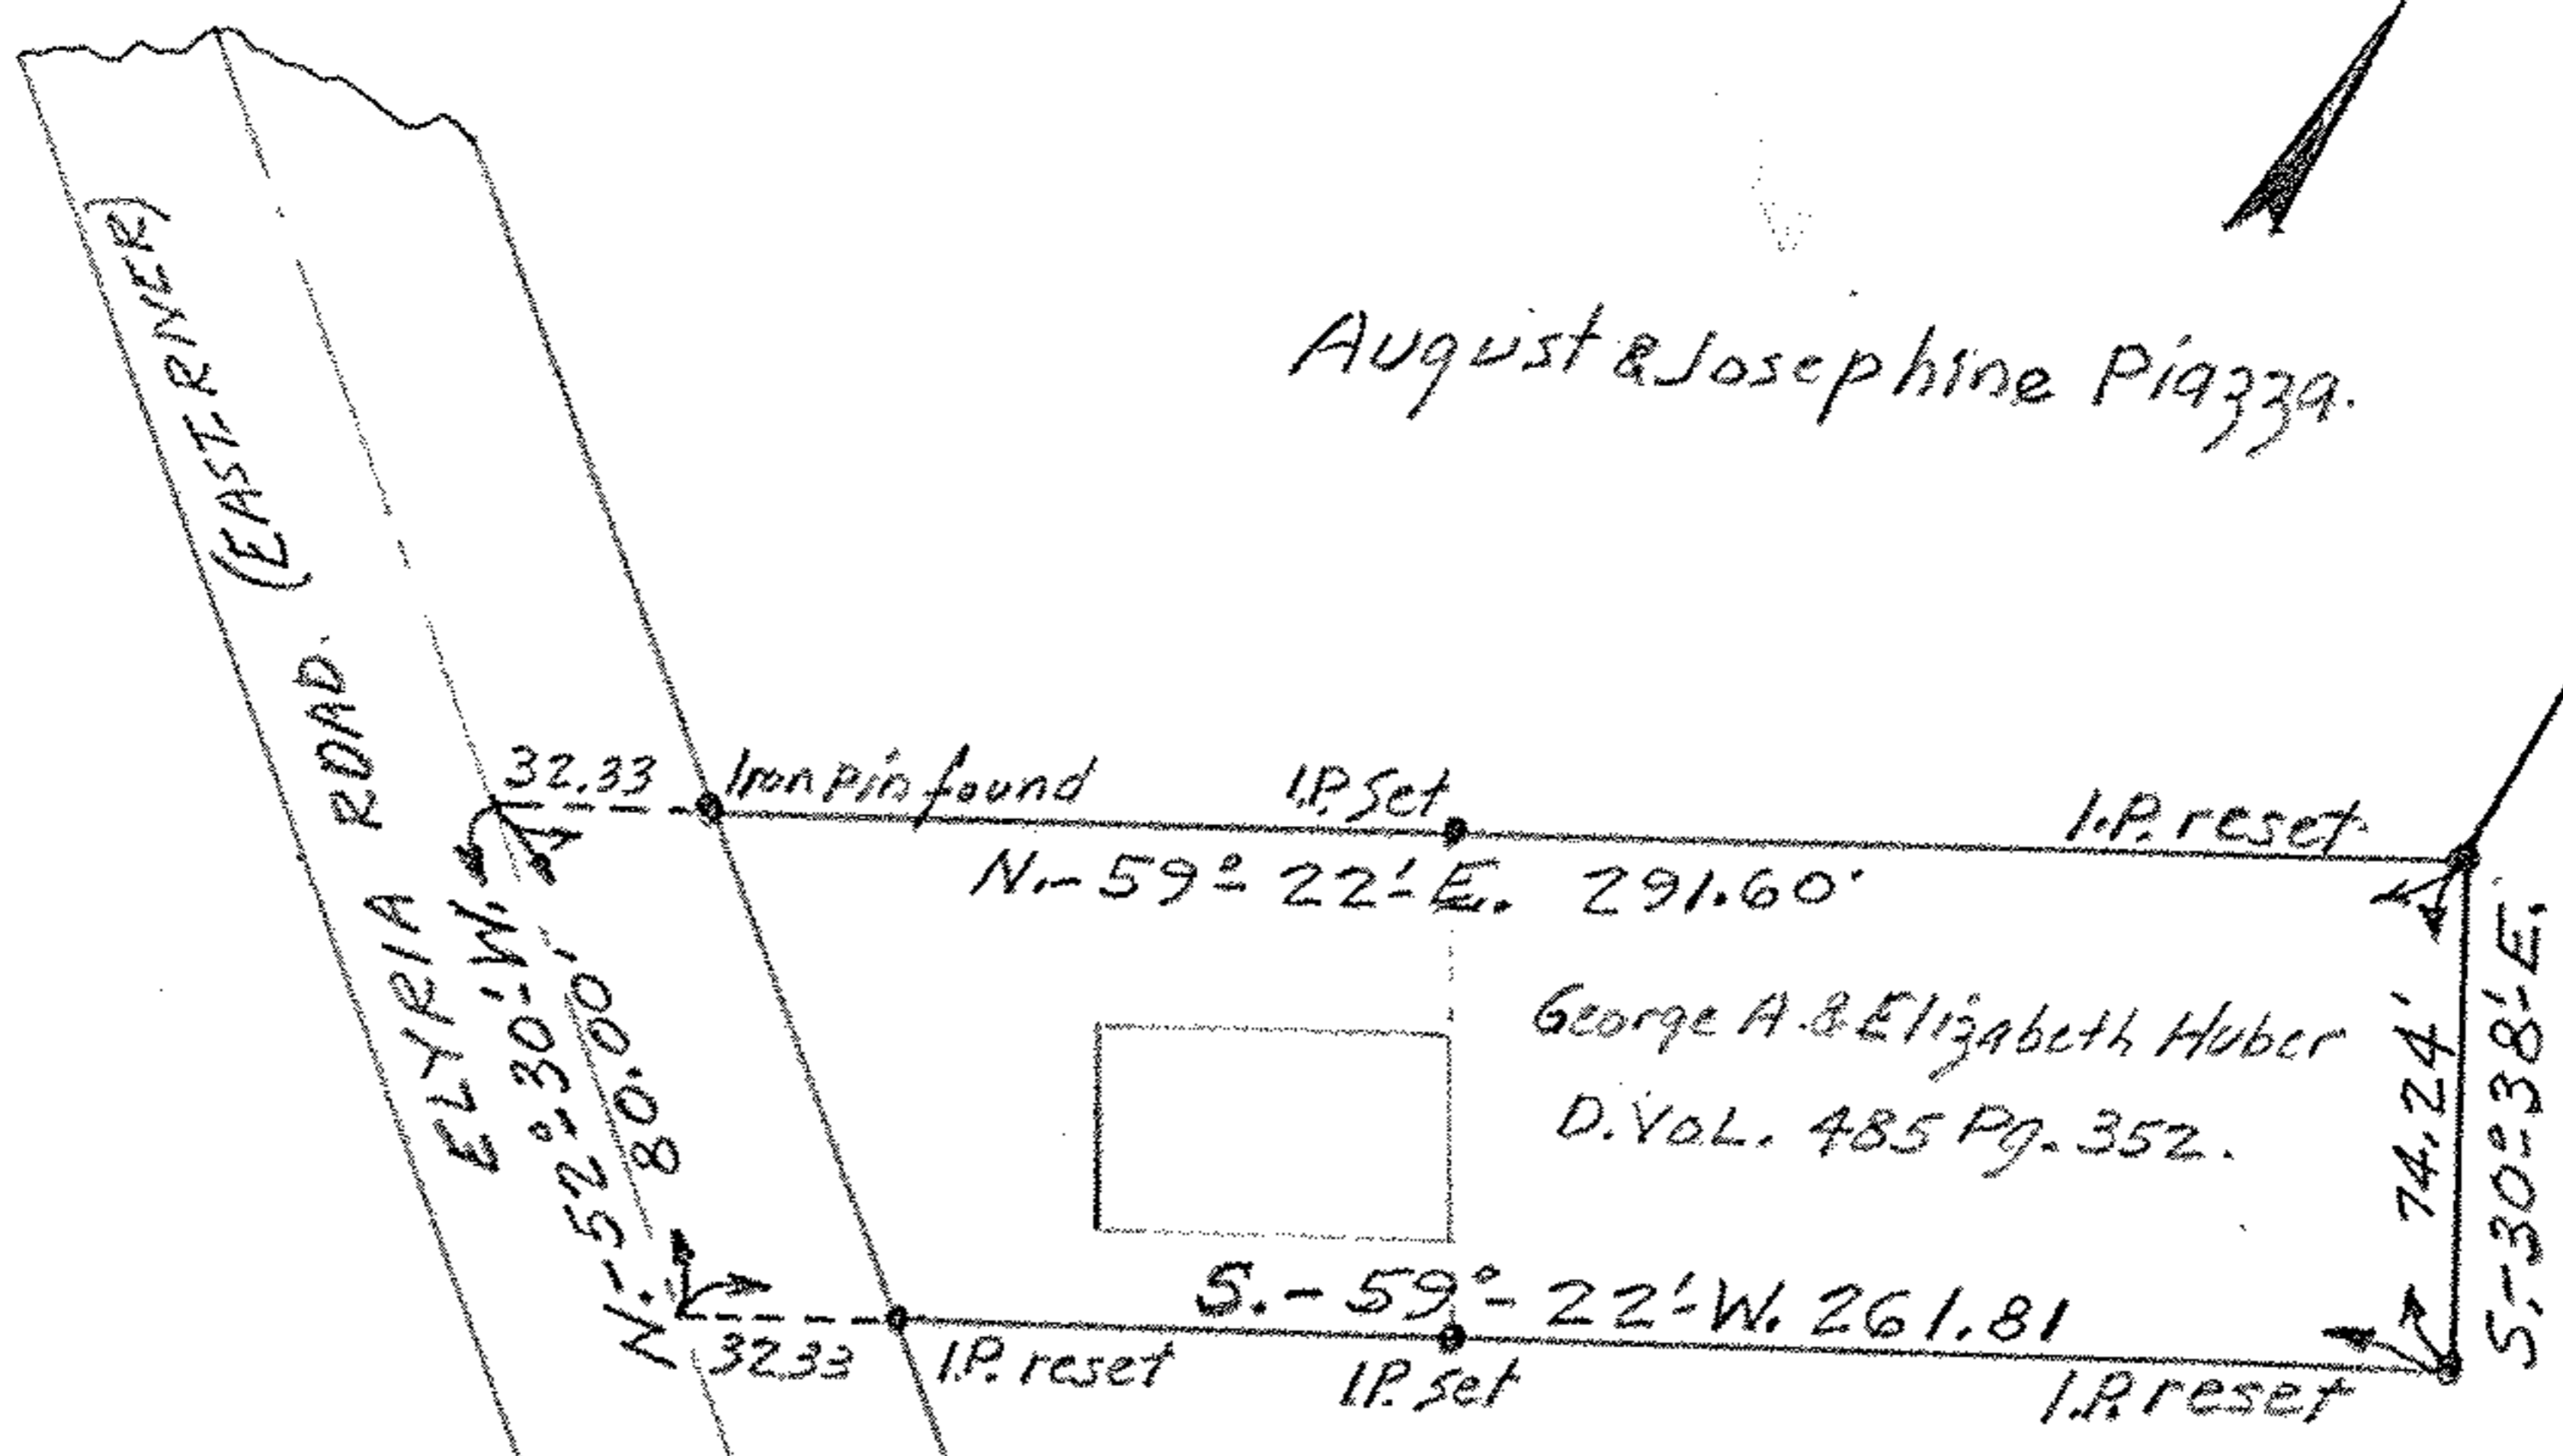

Michael & Antonia Campagna.

MAP OF SURVEY FOR
 George A. & Elizabeth Huber
 O.L.B. BURRELL & DAY TRACT
 ELYRIA TWP. LORAIN CO. OHIO
 Scale 1" = 60 FT. JULY 13-1951
 Original survey by G.T. Biggs - 1946
 Resurveyed by C.E. Penfound Reg. Surveyor

ELYRIA ROAD (EAST RIVER)
 ELYRIA ROAD
 SHEFFIELD
 LAKE 475.20'

