


Louis & Helen Chervenka  
 12 Vol 292 PG 361 June 10-1938



BLACK RIVER

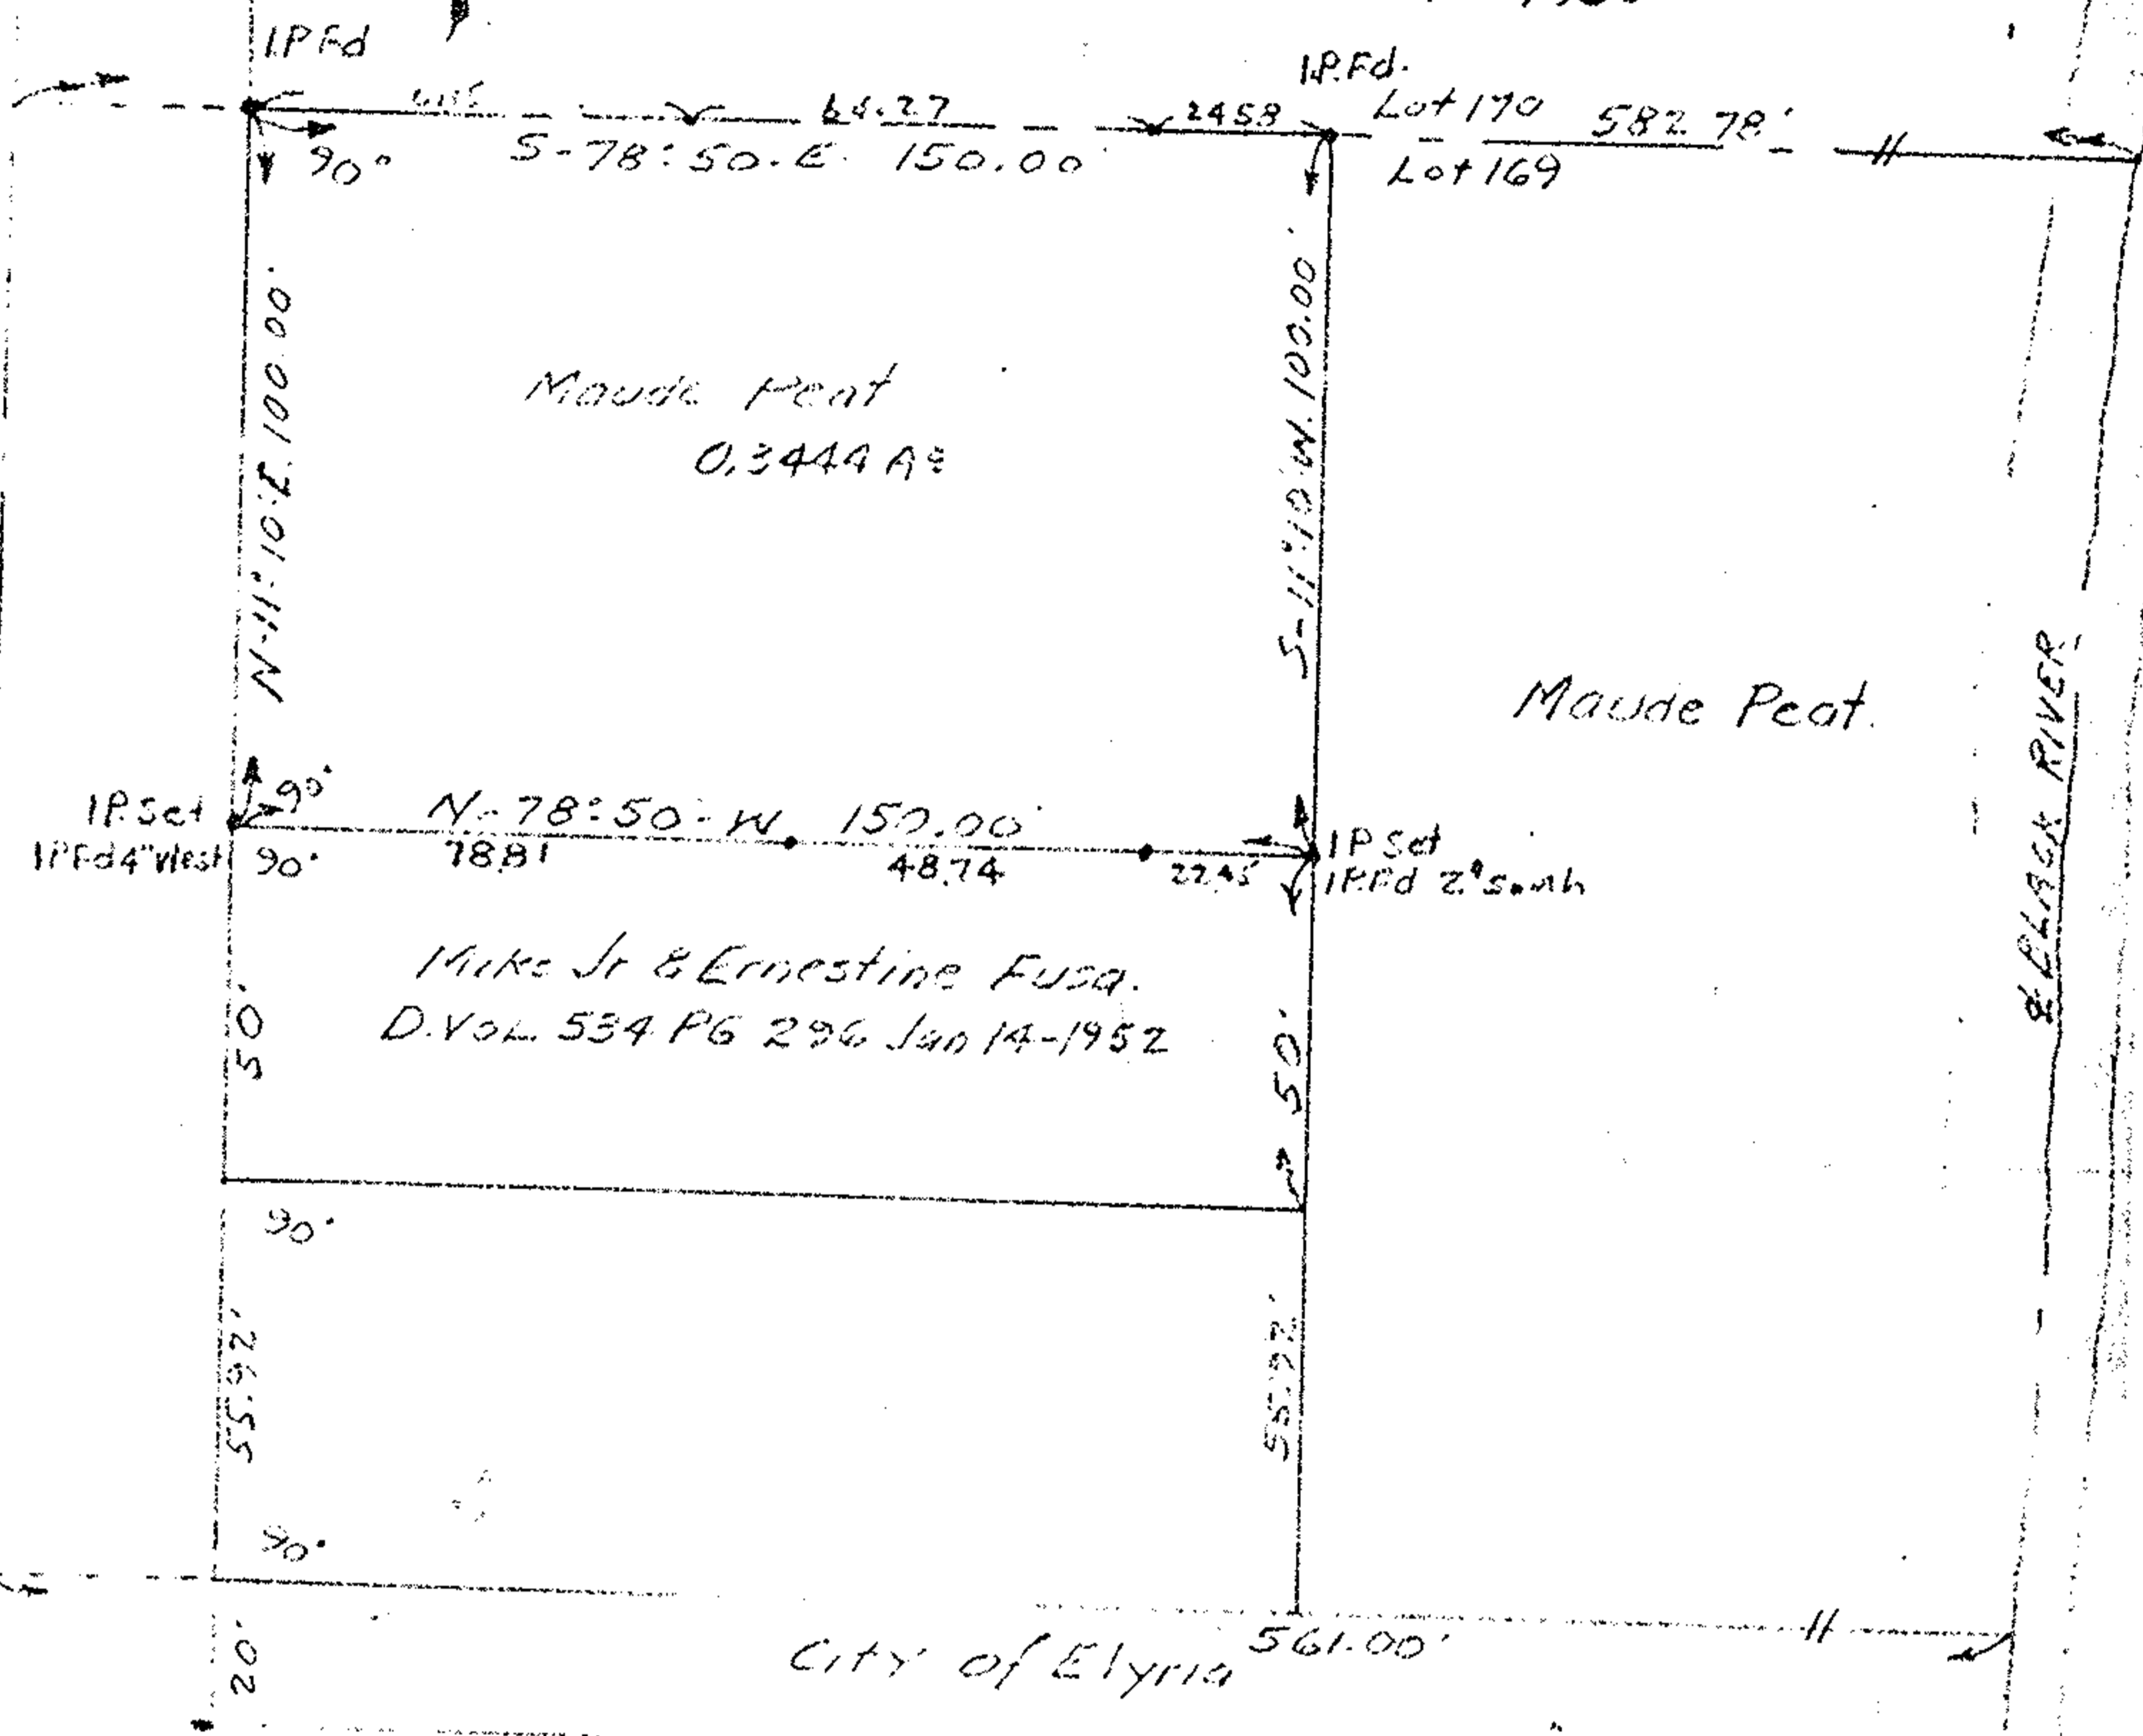

MAP OF SURVEY FOR  
 MAUDE PEAT  
 ORIGINAL ELYRIA TWP LOT NO 169 WEST OF RIVER  
 ELYRIA CITY - LORAIN COUNTY OHIO  
 SCALE 1" = 40' APRIL-11-1953  
 G.E. Penfound Registered Surveyor