




1" = 30'

FRANK R. HOJNINEZ
VOL 1083 PG 800

COLORADO AVE. aka S.R. 611-80'

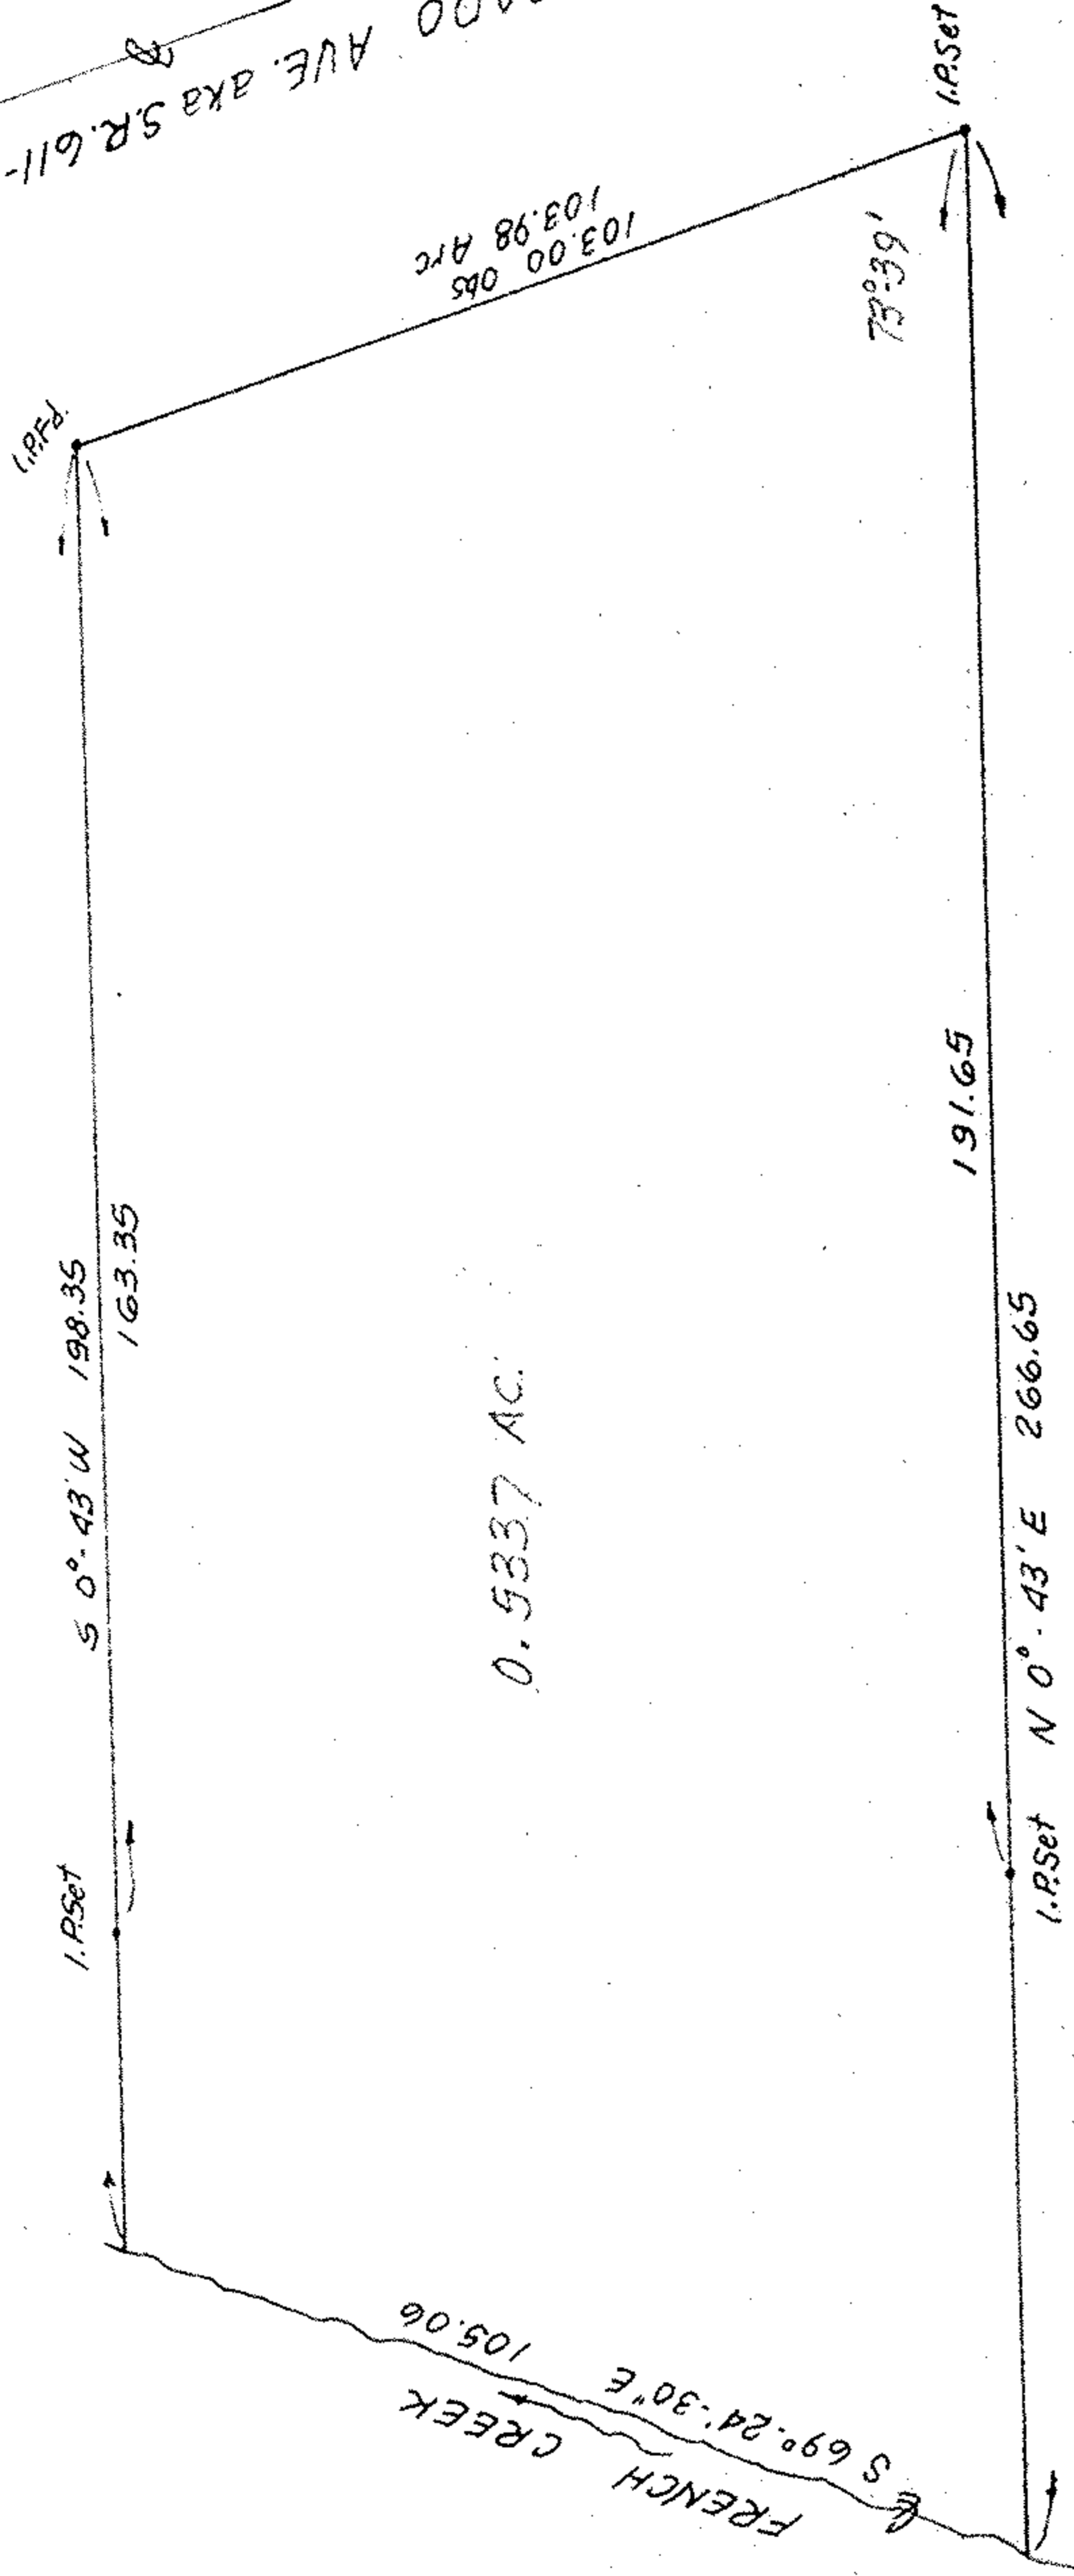

S 0° 43' W 198.35
163.35

0.5337 AC.

191.65

N 0° 43' E 266.65

73°39'

FRENCH CREEK
S 69° 24' 30" E 105.06

VOL 1013
PG 416

MAEBELLE McCALLIE et al
VOL 1013 PG 415

THIS IS A PLAT OF SURVEY:
FOR JOE DZIERZYK
McGLINCHY & ASSOCIATES INC.
SEPT. 1983 #838046

P.R. # 03-00-007-102-014
PART of ORIG. SHEFFIELD TWP. LOT 7
LORAIN COUNTY, OHIO

TAX MAP PG 03-00-007-A