
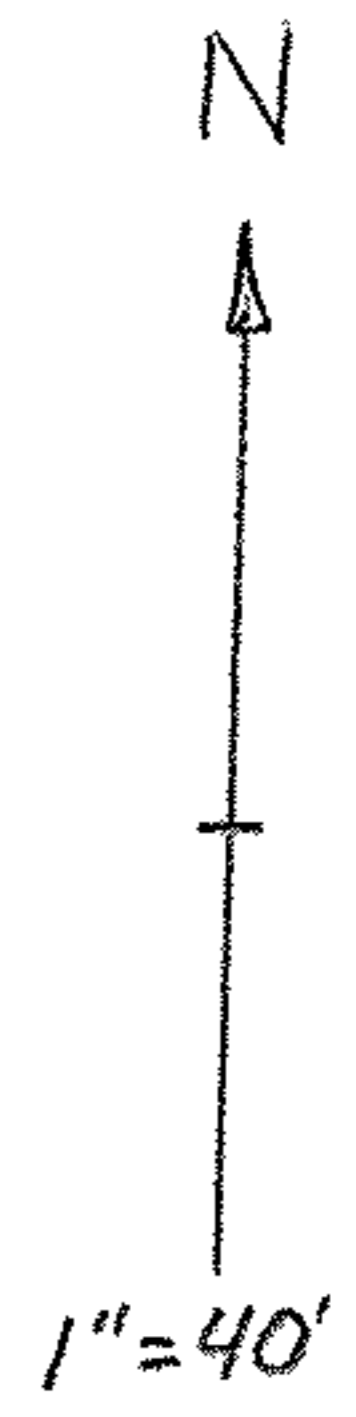


- I. P. Set
- I. P. Found

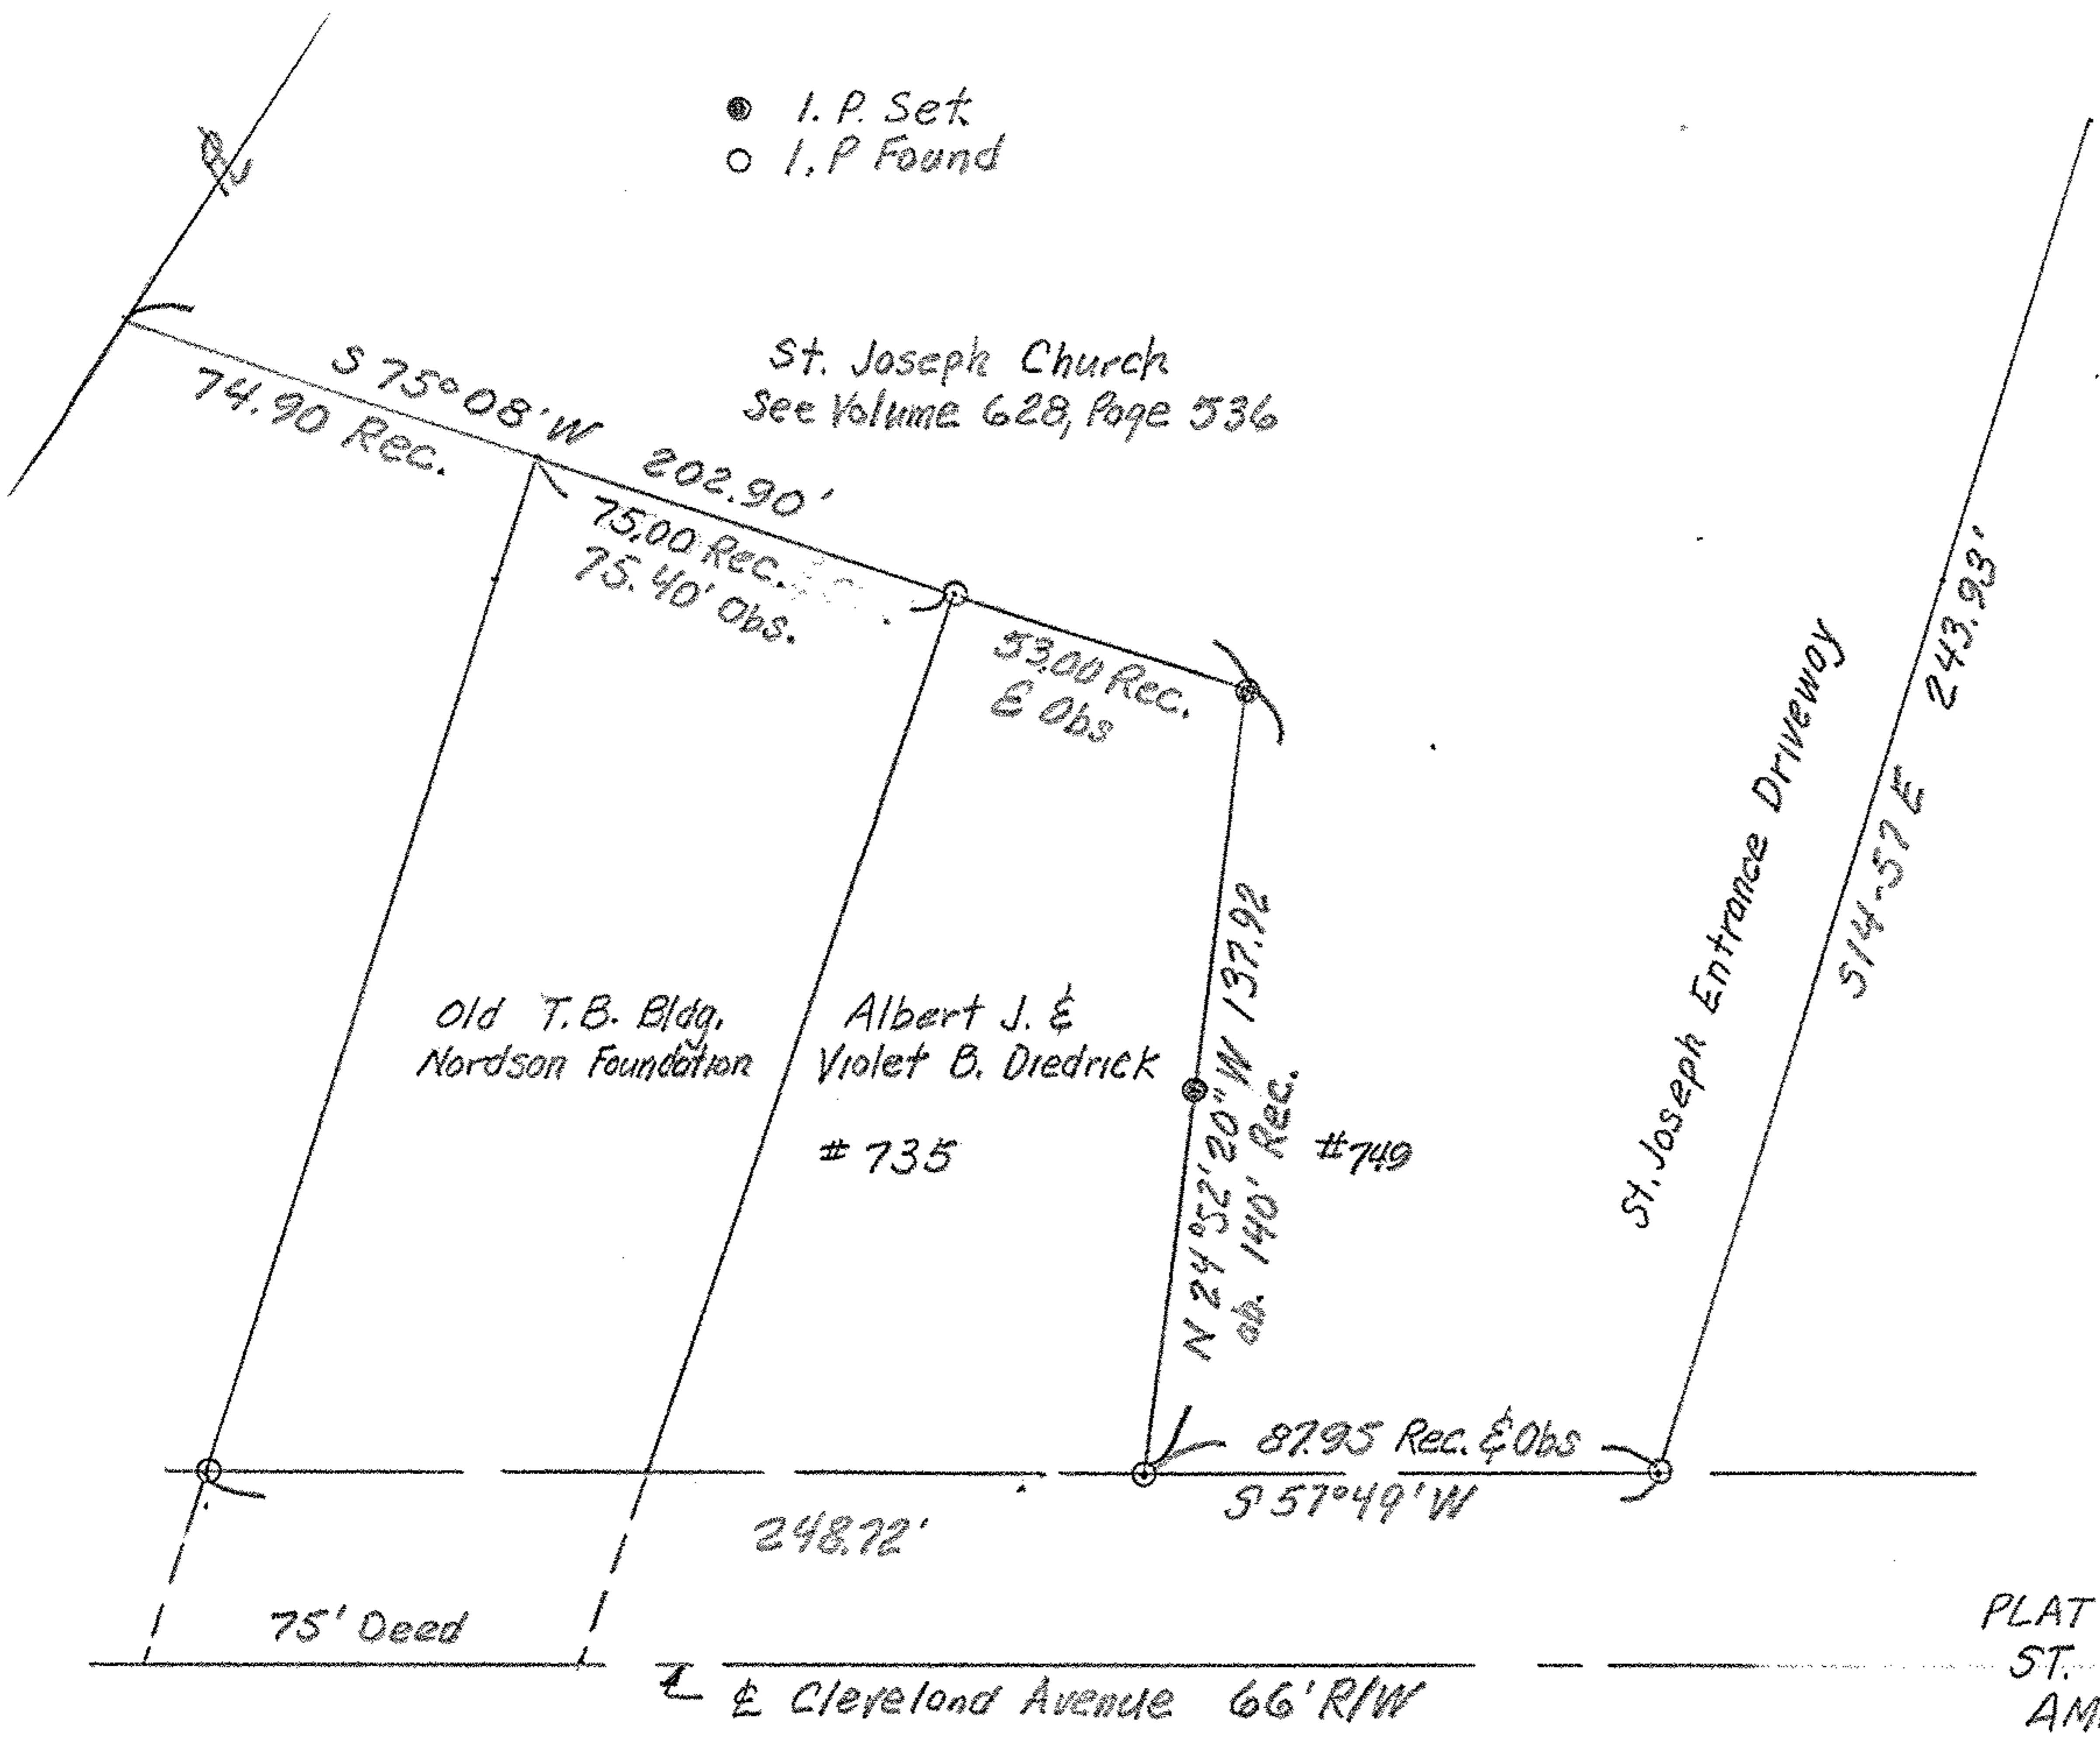

PLAT OF SURVEY FOR
ST. JOSEPH CHURCH
AMHERST, OHIO

MCGLINCHY & ASSOCIATES
AMHERST OH. Oct. 1989