


Amherst Exempted Village Board of Education
 Vol. 513 Page 215 Feb. 23, 1951

O.L. 23
 I.P. Found O.L. 38

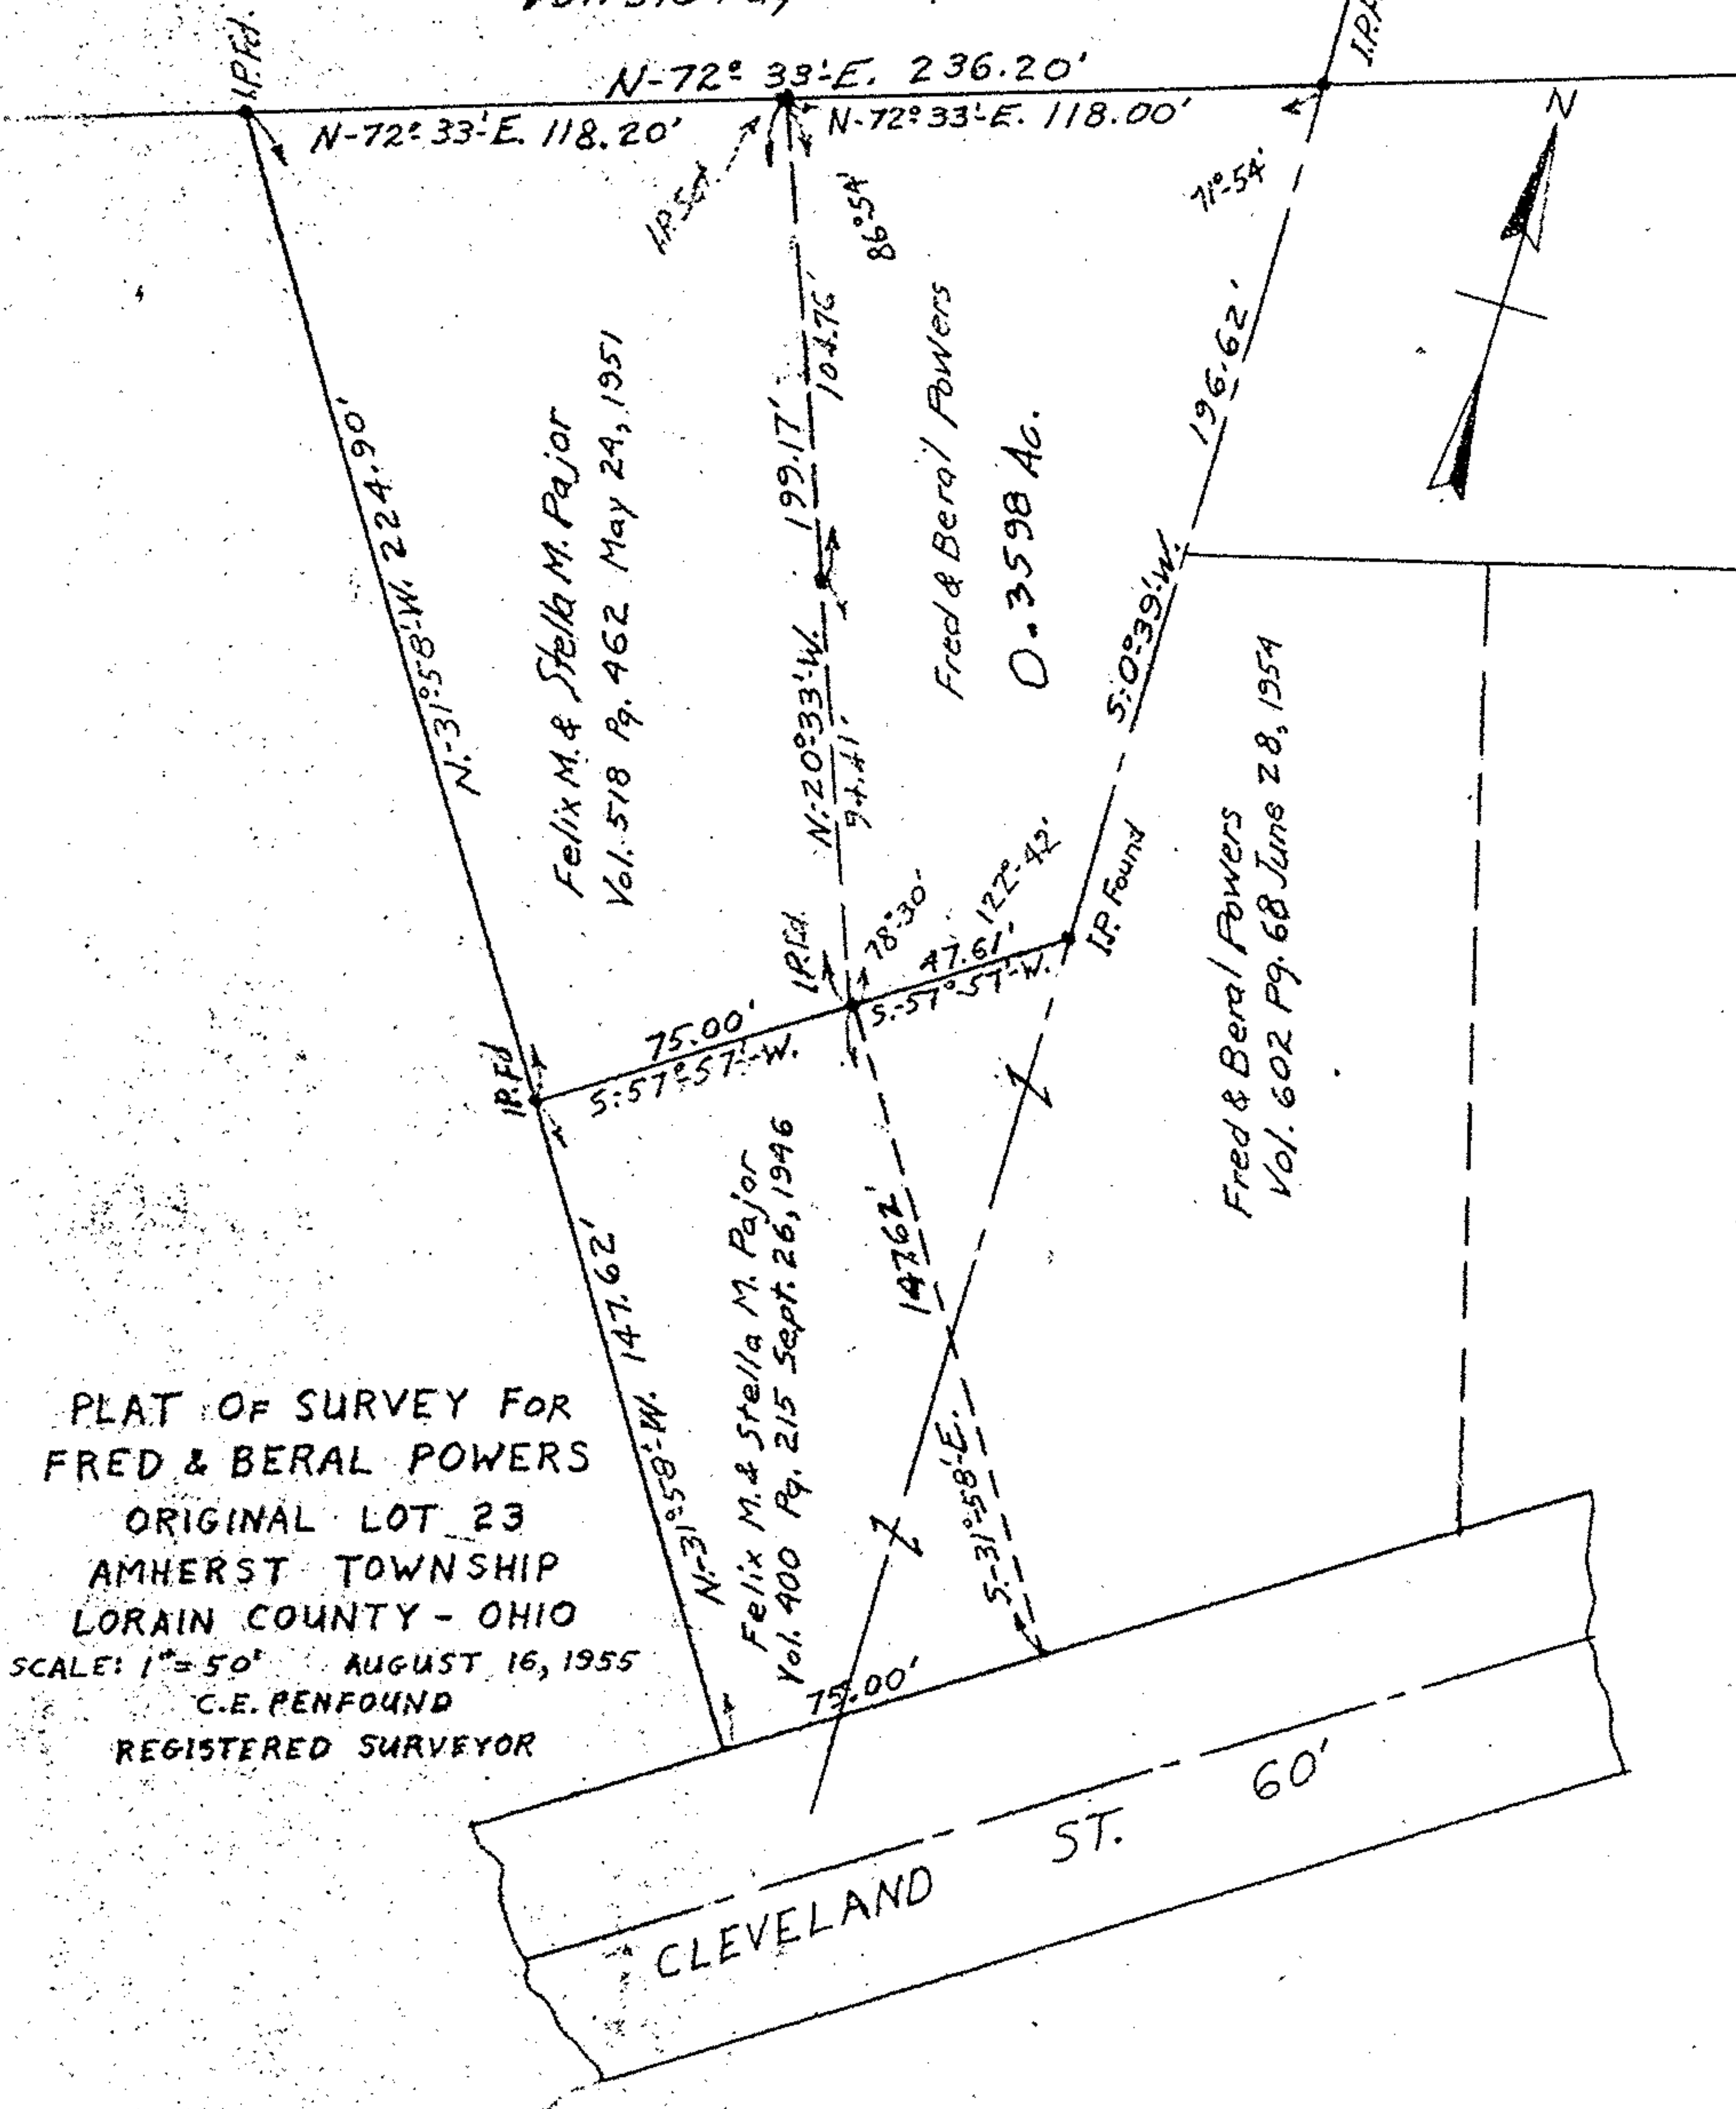

PLAT OF SURVEY FOR
 FRED & BERAL POWERS
 ORIGINAL LOT 23
 AMHERST TOWNSHIP
 LORAIN COUNTY - OHIO
 SCALE: 1" = 50' AUGUST 16, 1955
 C.E. PENFOUND
 REGISTERED SURVEYOR

CLEVELAND ST. 60'