


PROPOSED SPLIT

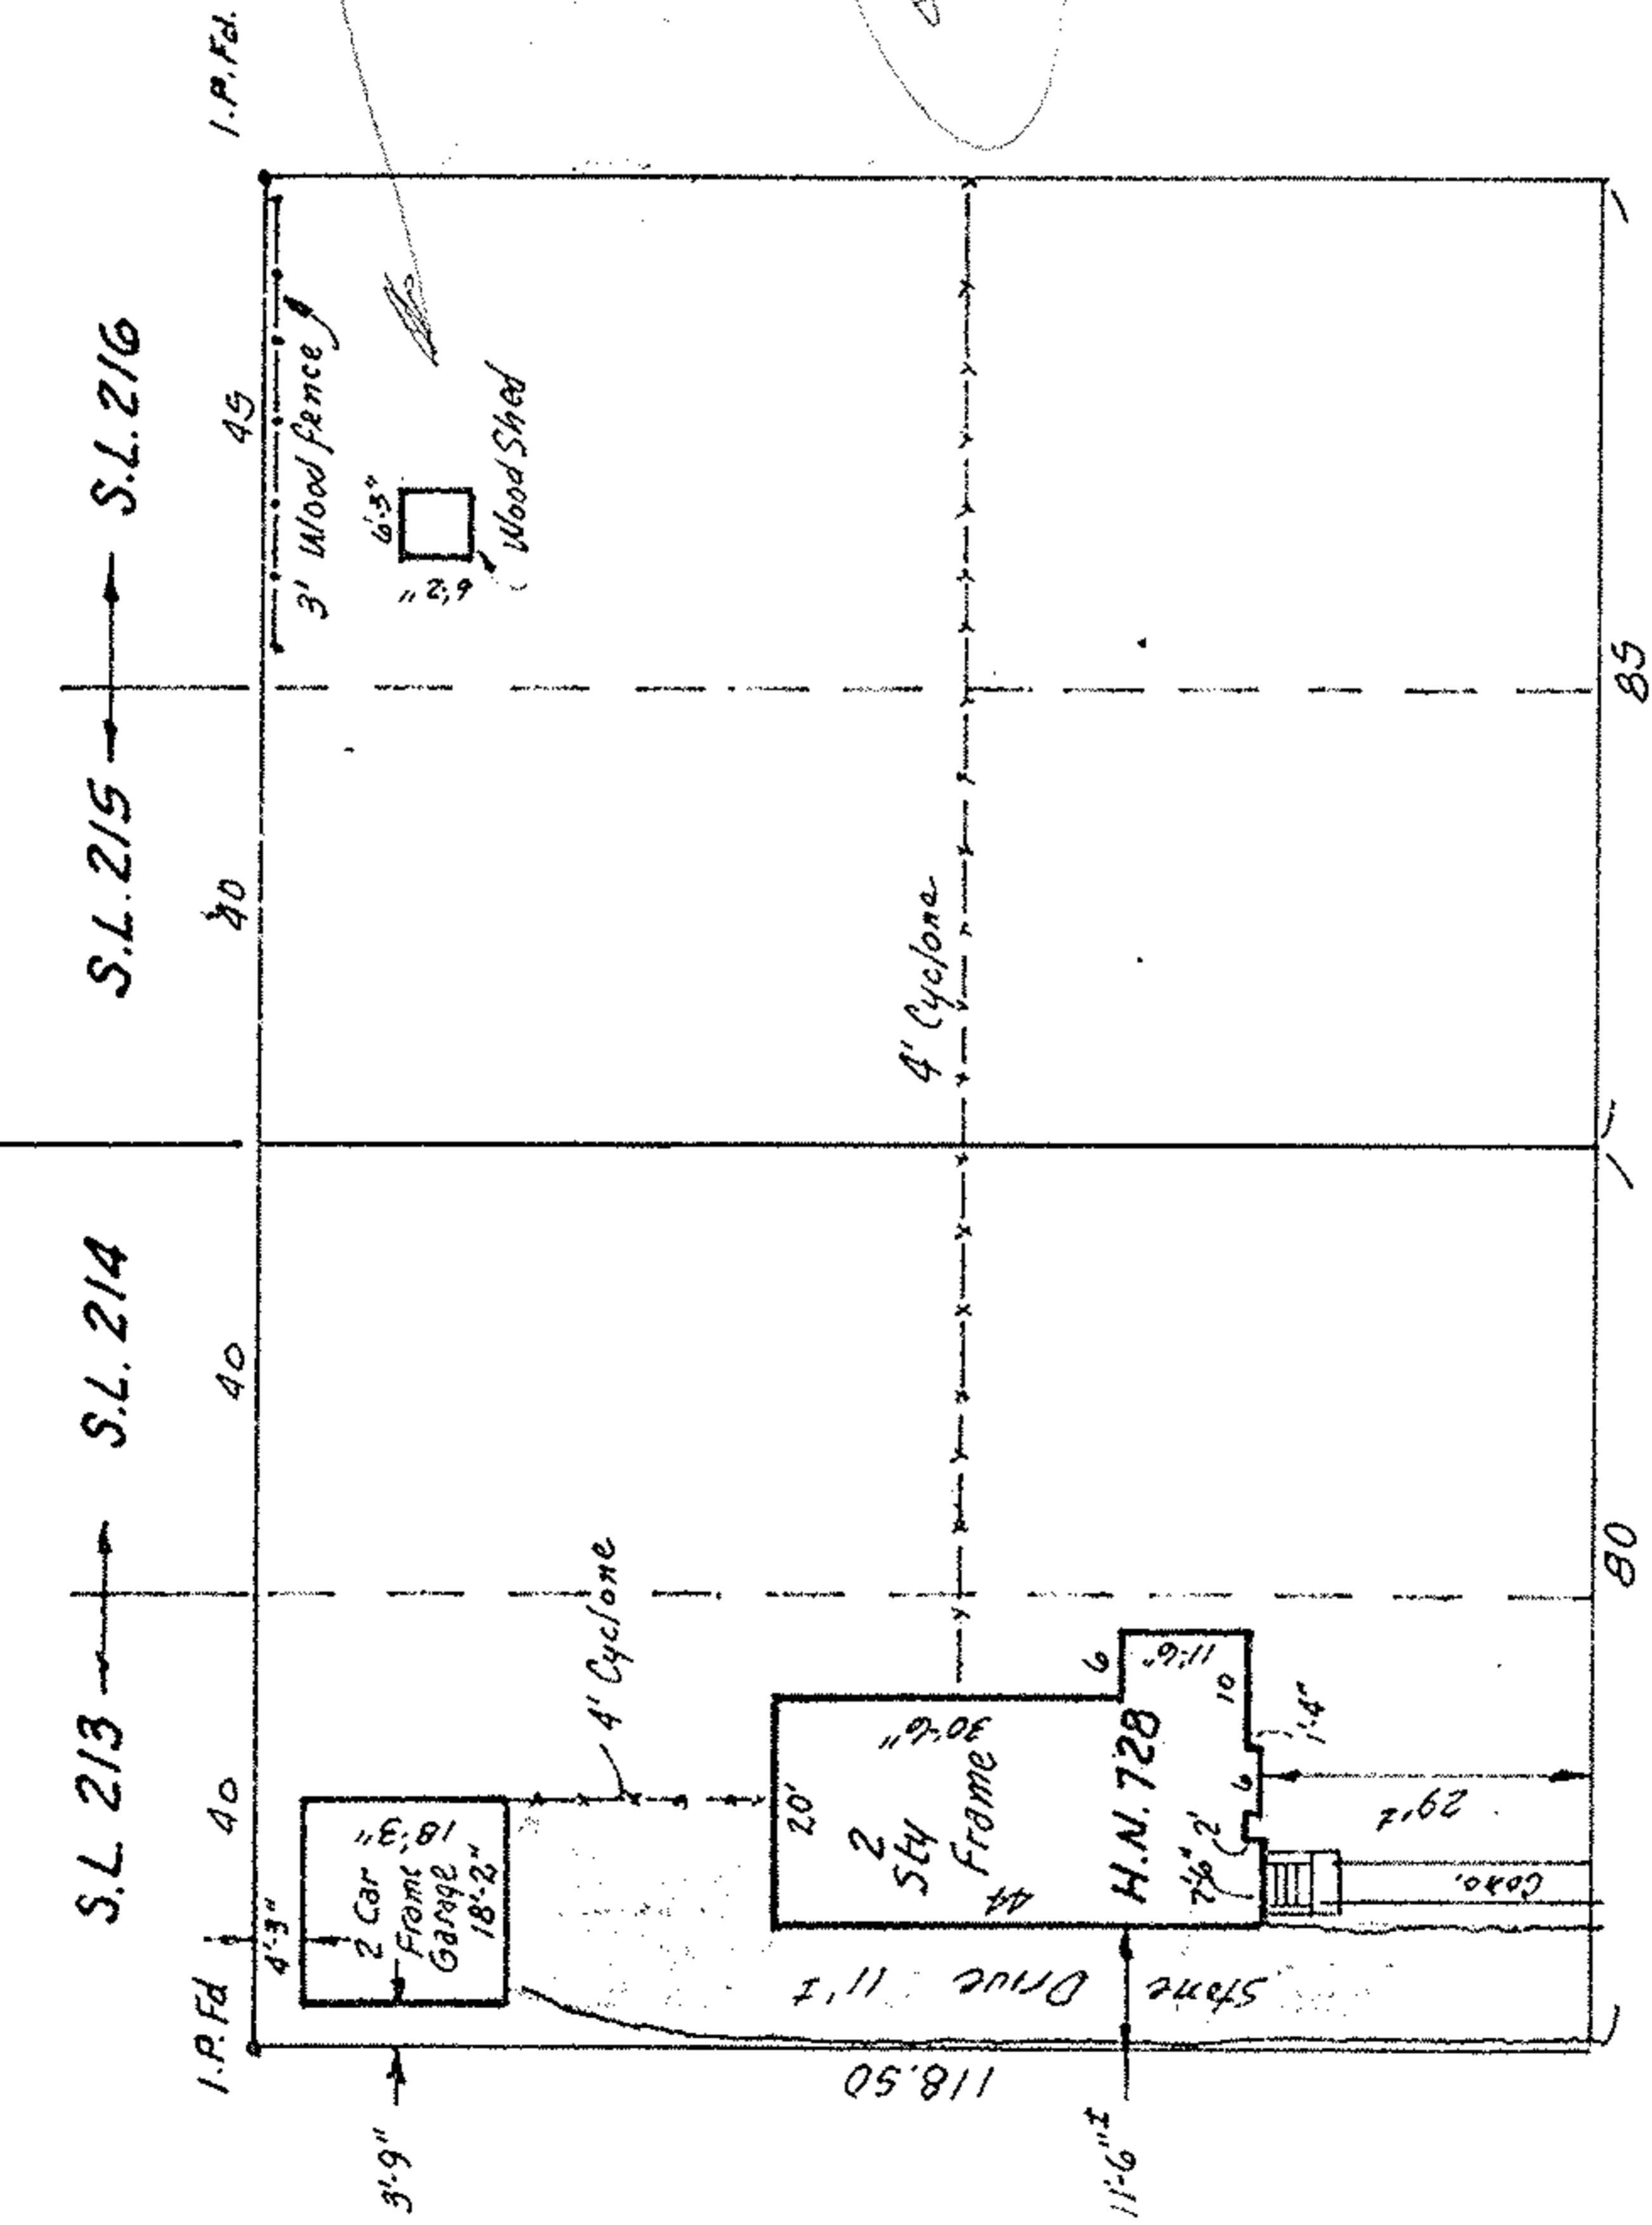

1" = 30'

Wood shed is gone - 10/28-76

4' CYCLONE FENCE gone

ROBERTS AVE. 50'

PROPOSED SPLIT OF  
 SUBLOTS # 213, 214, 215 & 216 OF LAKE  
 BREEZE ALLOTMENT - PLAT VOL. 10, PG 21  
 PART OF ORIG. SHEFFIELD TWP. LOT 42  
 NOW IN CITY OF SHEFFIELD LAKE, OHIO

MCGLINCHY & ASSOCIATES  
 OCT. 25, 1976

# 761354