


BREESE  
VOL 1160 PG 374  
P.R. # 11-00-016-000-013

MAP of SURVEY FOR  
C. & R. FAULKENBURG-PARTNERSHIP  
PROPOSED PARCEL SPLIT  
P.R. # 11-00-016-000-062

TAX MAP PAGE 11-00-016 B

PART of ORIGINAL EATON TWP LOT 16  
LORAIN COUNTY, OHIO

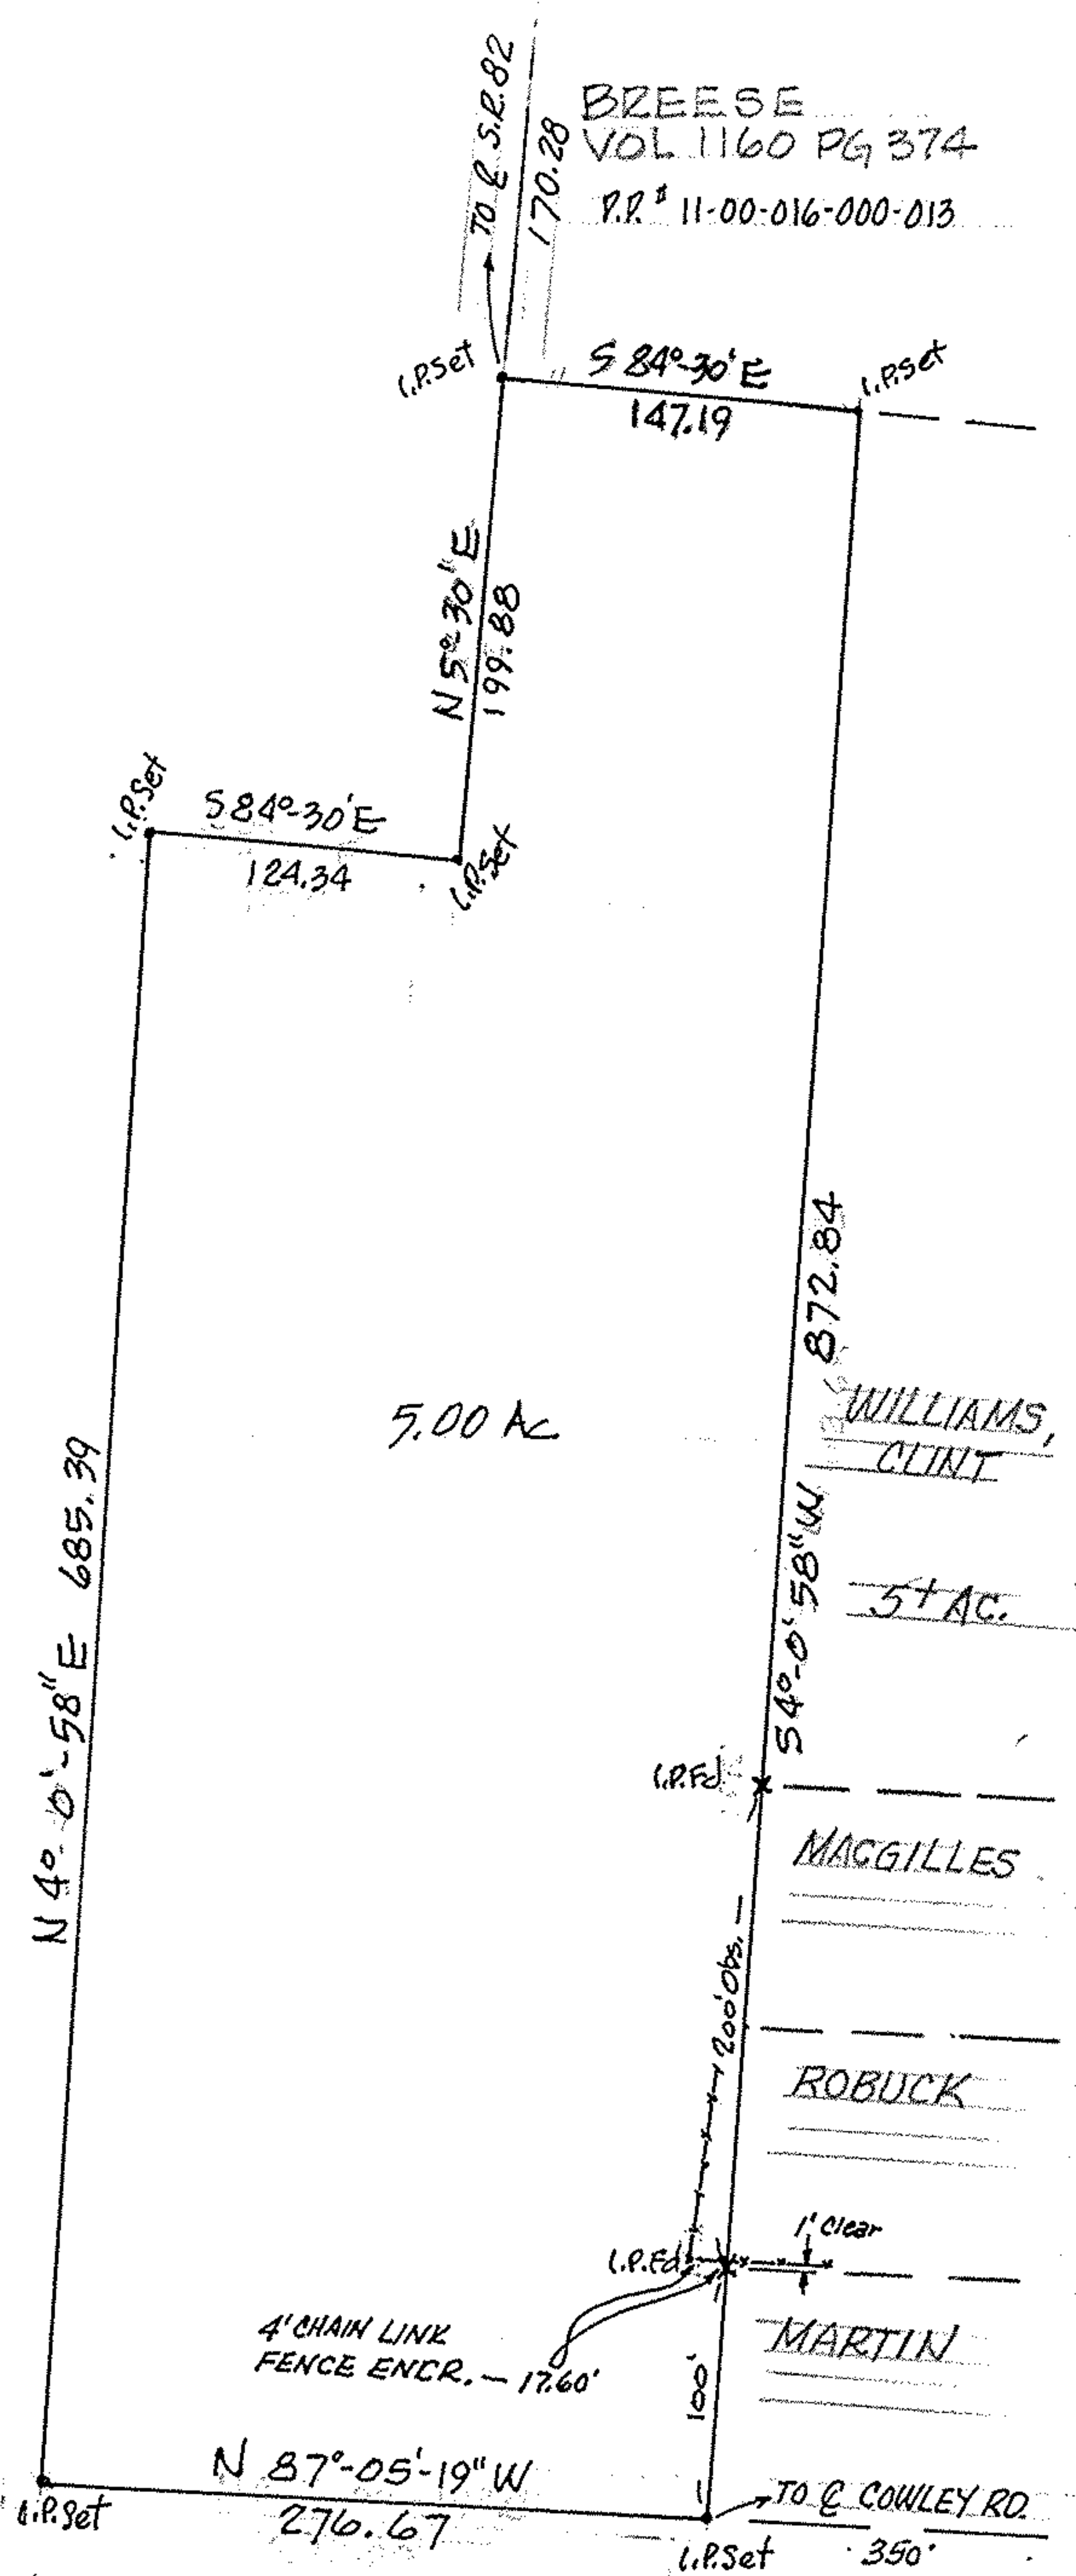

McGLINCHY & ASSOCIATES INC.  
REGISTERED SURVEYORS & ENGINEERS  
OCT 1983 838071