

WAKEMAN-LAGRANGE-RICHFIELD ROAD (S.R. 303)

N 89°43' E 955.80'

262.45'

~~262.45'~~
251.35'

~~430.90'~~
442.00'

I.P. Pd. IN MON. BOX

DUE NORTH 663.90'

WEST PARCEL
4.00 AC.

DUE SOUTH 663.90'

EAST PARCEL
4.00 AC.
3.83 AC.

REMAINDER PARCEL
6.567 AC.
2.74
3.827

House & Barn

WHITEHEAD ROAD - 60'

663.90
270.00
393.90

2.74 AC.

262.45'

~~262.45'~~ 251.35'

430.90'
442.00'

S 89°43' W 955.80'

PP # 15-00-058-000-023


PP # 15-00-058-000-022

MAP of PROPOSED PARCEL SPLIT

PREPARED FOR ROBERT M. DINSMOOR
PART OF ORIGINAL LAGRANGE TWP. LOT No. 58
TOWNSHIP of LAGRANGE, LORAIN COUNTY, OHIO

262.45
21.10
251.35

442
430.90
11.1

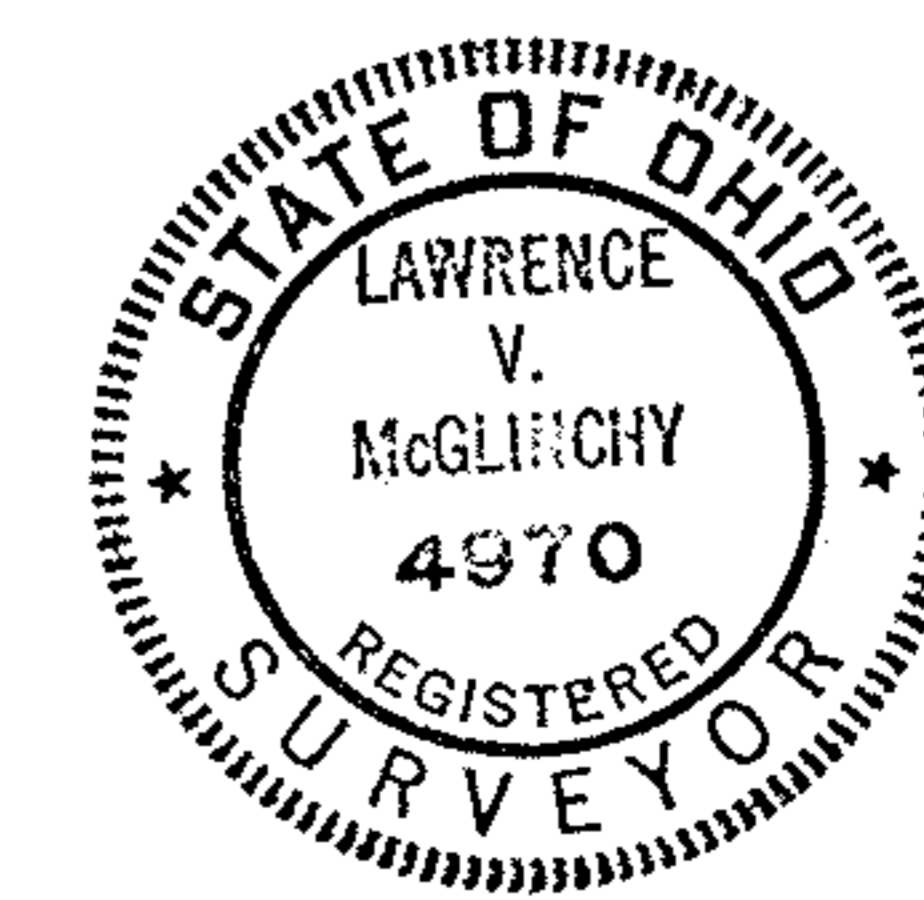

SCALE: 1"=50'

REF: TX.MP. 15-E

McGLINCHY and ASSOCIATES INC.
PROFESSIONAL ENGINEER & SURVEYORS
110 1/2 MIDDLE AVE. ELYRIA OHIO
JUNE, 1985 #858748