

Samuel & Mary Mungeon  
D. Vol. 233 PG 310 Jan. 20-1928

CORPORATION LINE VILLAGE OF OBERLIN



Ella Johnson  
D. Vol. 331 PG. 645 Dec. 28-1943


Charlie Johnson  
D. Vol. 480 PG. 17 July-1949

John Thomas  
D. Vol. 469 PG. 576 July 16-1949

Ed. Lewis  
0.3281A<sub>s</sub>

George M. Harvey  
D. Vol. 438 PG. 503 May 11-1948

Robert & Hattie S. Wynn  
1.000A<sub>s</sub>

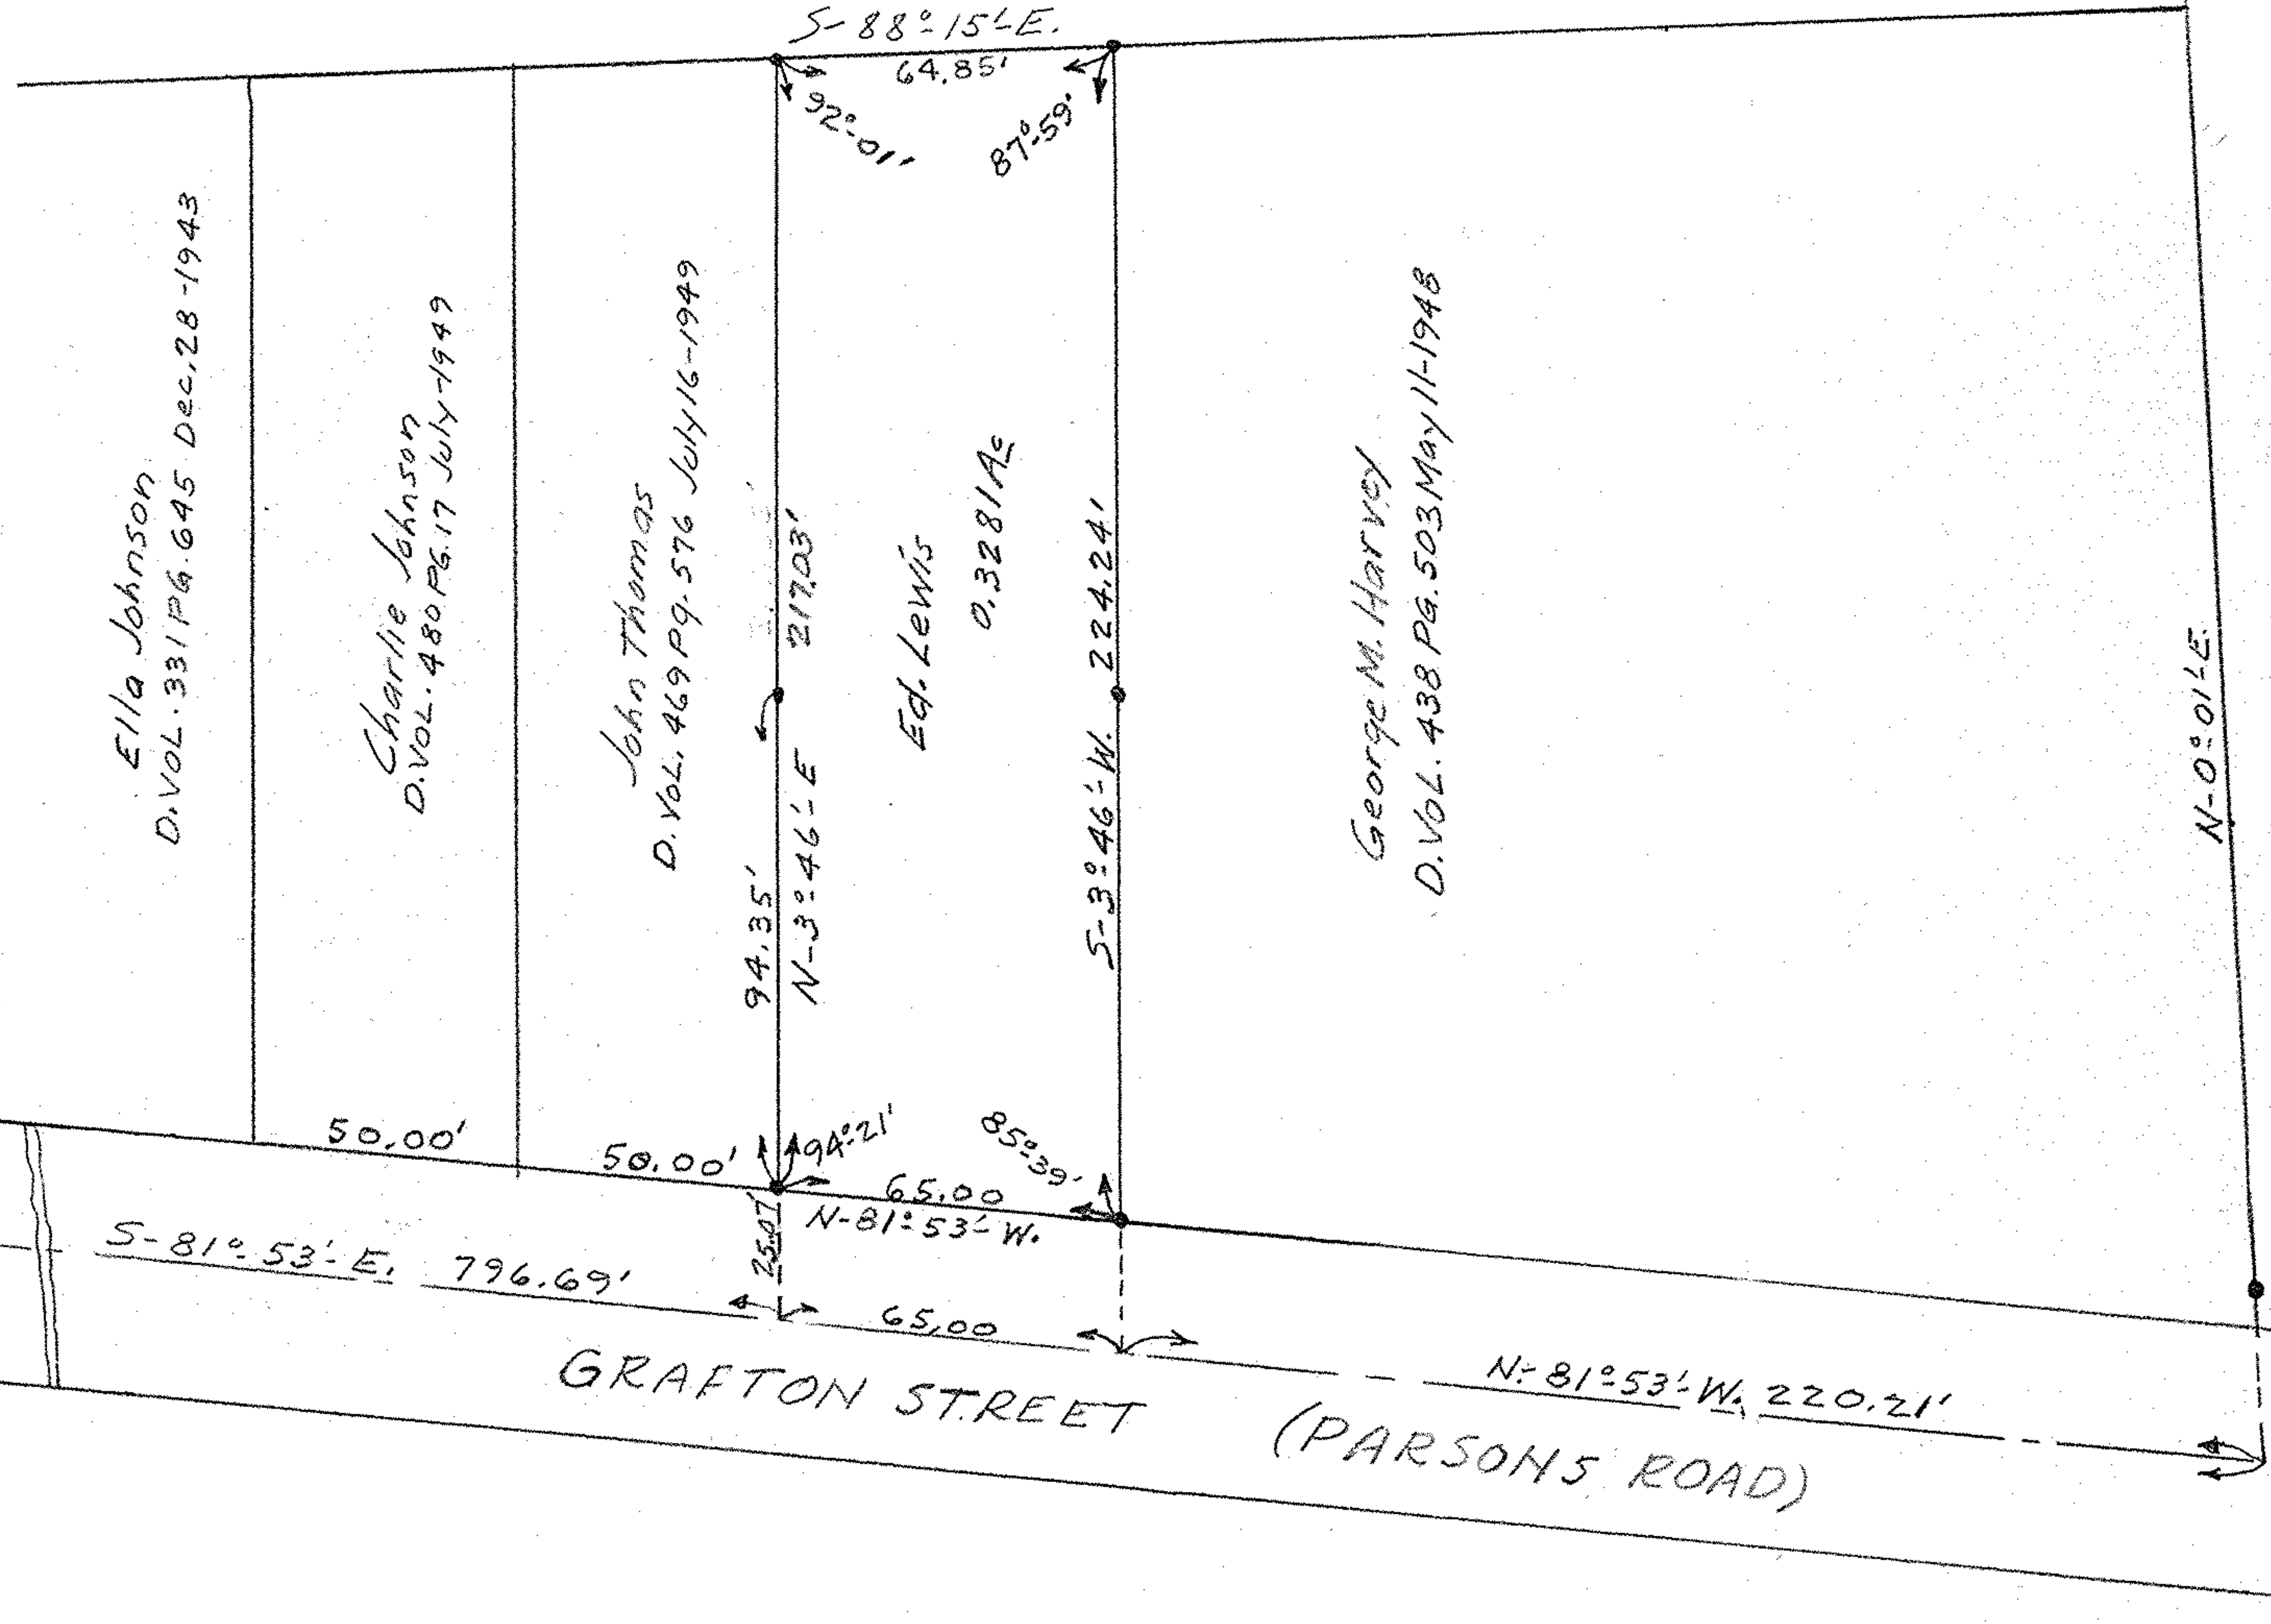

GRAFTON STREET  
(PARSONS ROAD)

MAP OF SURVEY FOR  
Ed. Lewis  
O.L. 97 RUSSIA TWP. LORAIN CO.  
Scale 1"=40 FT. JUNE-16-1951  
C.E. Penfound Registered Surveyor.