



SOUTH PROFESSOR STREET 60 FT.
208.29

Iron Pin Found.

VINE STREET 49.50 FT.

128.00' Deed 129.15' Meas.

728.08' Rec. 728.48' Meas.

4.72'

85.00' Deed & Meas.

44.15' Meas.

52' Deed & Meas.


60.00' Rec. & Meas.

William H. Clark
D. Vol. 92 Pg. 472
Mar. 29-1952

Harry Terrell &
Thelma R. Worcester
D. Vol. 267 Pg. 506 June 13-1934

J. Carl & Florence C. Zimmerman
Deed Volume 215
Pg. 619 Jan. 23-1926

Maynard C. & Sarah K. Davidson.

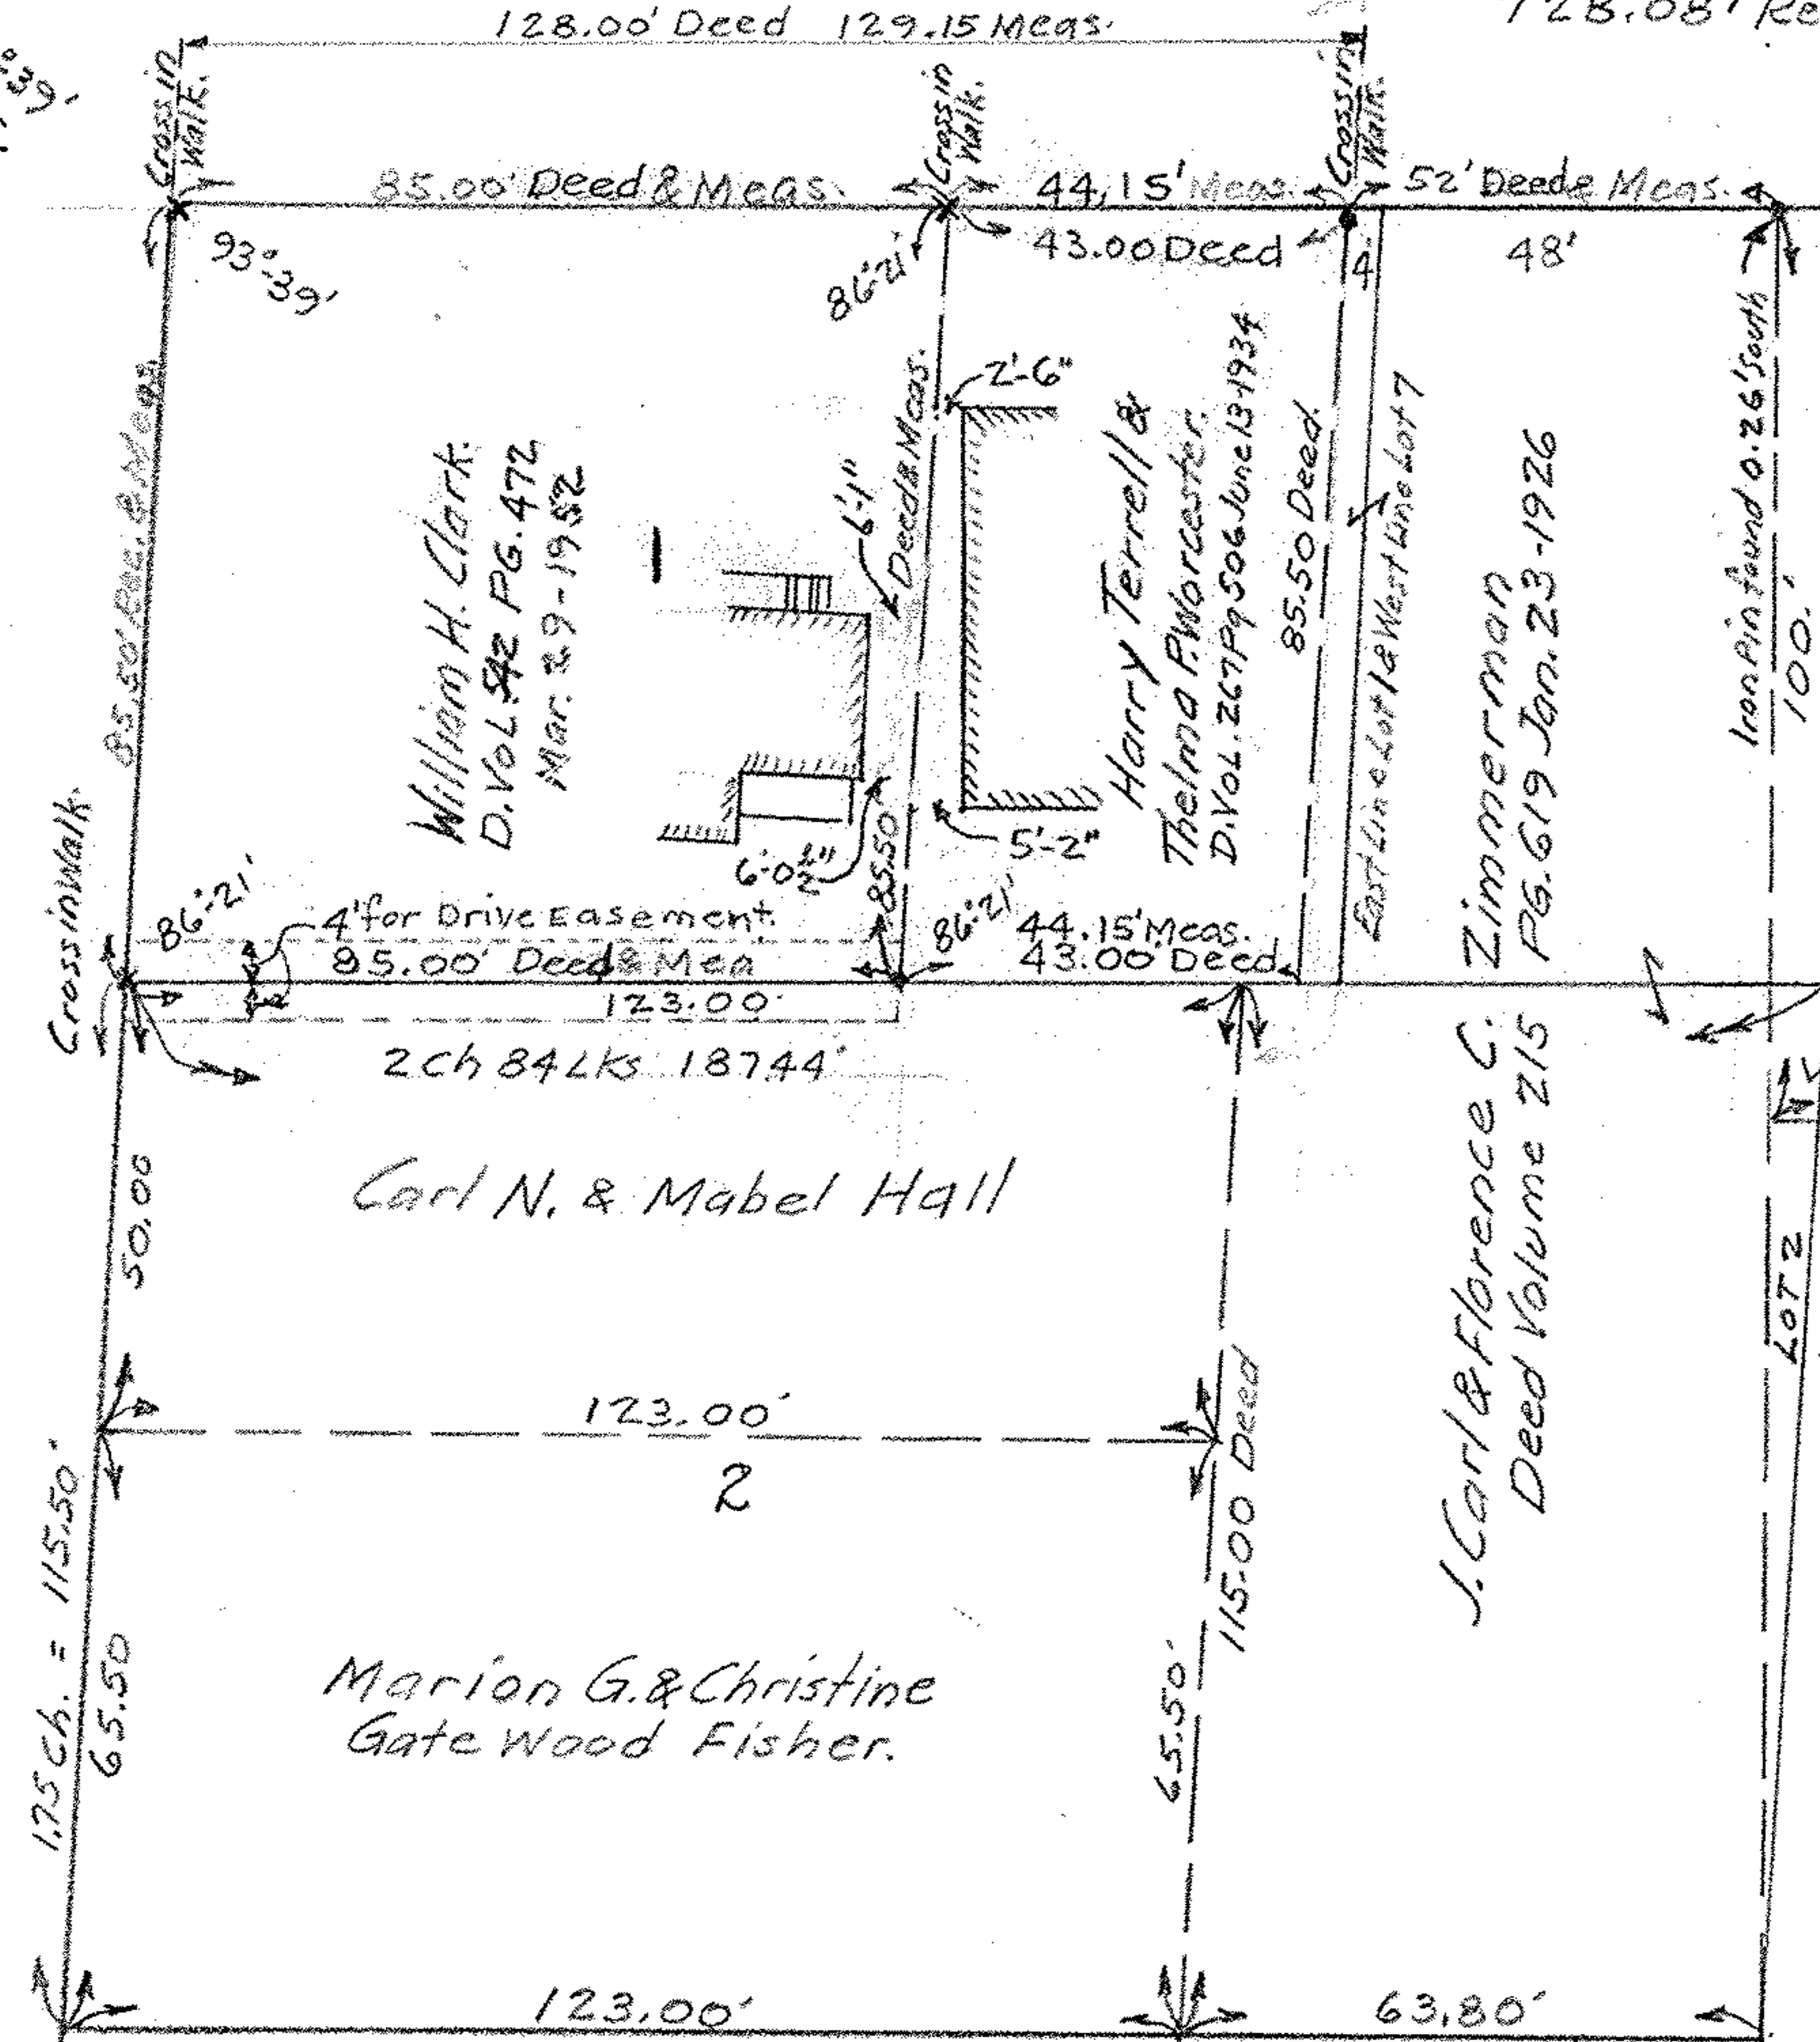

Carl N. & Mabel Hall

Marion G. & Christine
Gate Wood Fisher.

Village of Oberlin
Wright Memorial Park.

MAP OF SURVEY FOR
William H. Clark.
LOT 1-SWIFTS SUBDN. VOL 3 PG 8
VILLAGE OF OBERLIN
O.L. 85 RUSSIA. TOWNSHIP.
LORAIN COUNTY OHIO
Scale 1"=30' JULY 5-1952
C.E. Penfound Registered Surveyor.