

ACCESS ROAD 50' R/W

RR SPIKE SET
S 1° 04' 33" W
430.25'
RR SPIKE SET
30.00'
RR SPIKE SET

S 88° 38' 02" E
53.79'
RR SPIKE SET
35° 03' 22"
I.P. SET

R = 919.49', Δ = 17° 24' 59", L = 279.50', D = 6° 11' 03"
CHD BRG. N 46° 25' 20" E
278.42'

HENDERSON DRIVE 66' R/W

100' EASEMENT

I.P. SET
102° 12' 23"

217.44'
N 31° 22' 11" W

1.5955 Ac.


297.76'
317.32'

EAST 21ST STREET
60' R/W

103.00'
N 88° 31' 27" W

I.P. SET
122° 50' 50"
RR SPIKE SET

WEST LINE B & O RR
SL. 16
WORTHY S. STREATOR,
TRUSTEE'S ADD.
VOL. 4 PG. 28

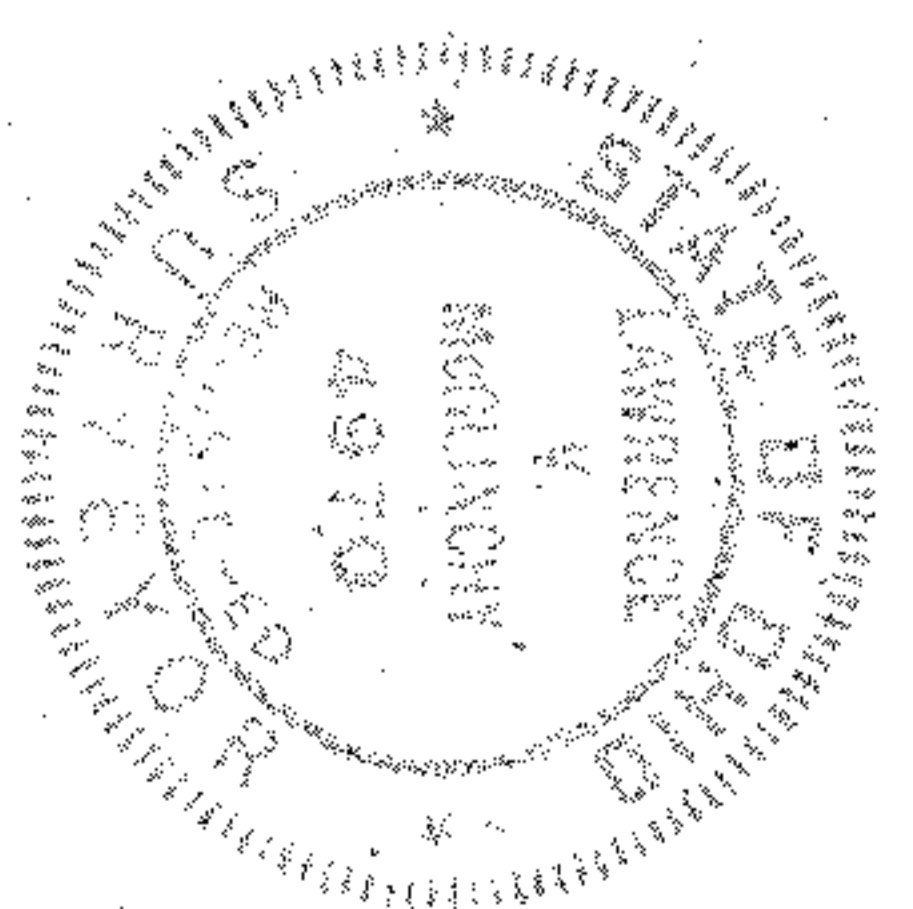

FOR EASEMENT DESCRIPTION SEE DEED
VOL. 297 PG. 609, LORAIN COUNTY DEED
RECORDS (BALTIMORE & OHIO R.R. CO. TO
LORAIN COUNTY BOARD OF COMMISSIONERS)

SCALE 1" = 30'
DATE JUNE, 1973
JOB NO. 443
NEHE & ASSOCIATES
PROFESSIONAL ENGINEERS
CIVIL
ELYRIA, OHIO
SANITARY
DRAWN: APC
CHECKED:
APPROVED:
F.B. & PG.

MAP OF SURVEY PREPARED FOR
OHIO EDISON COMPANY - AKRON

SHEET 1 OF 1