




OL.73
OL.74

OL.68
OL.67

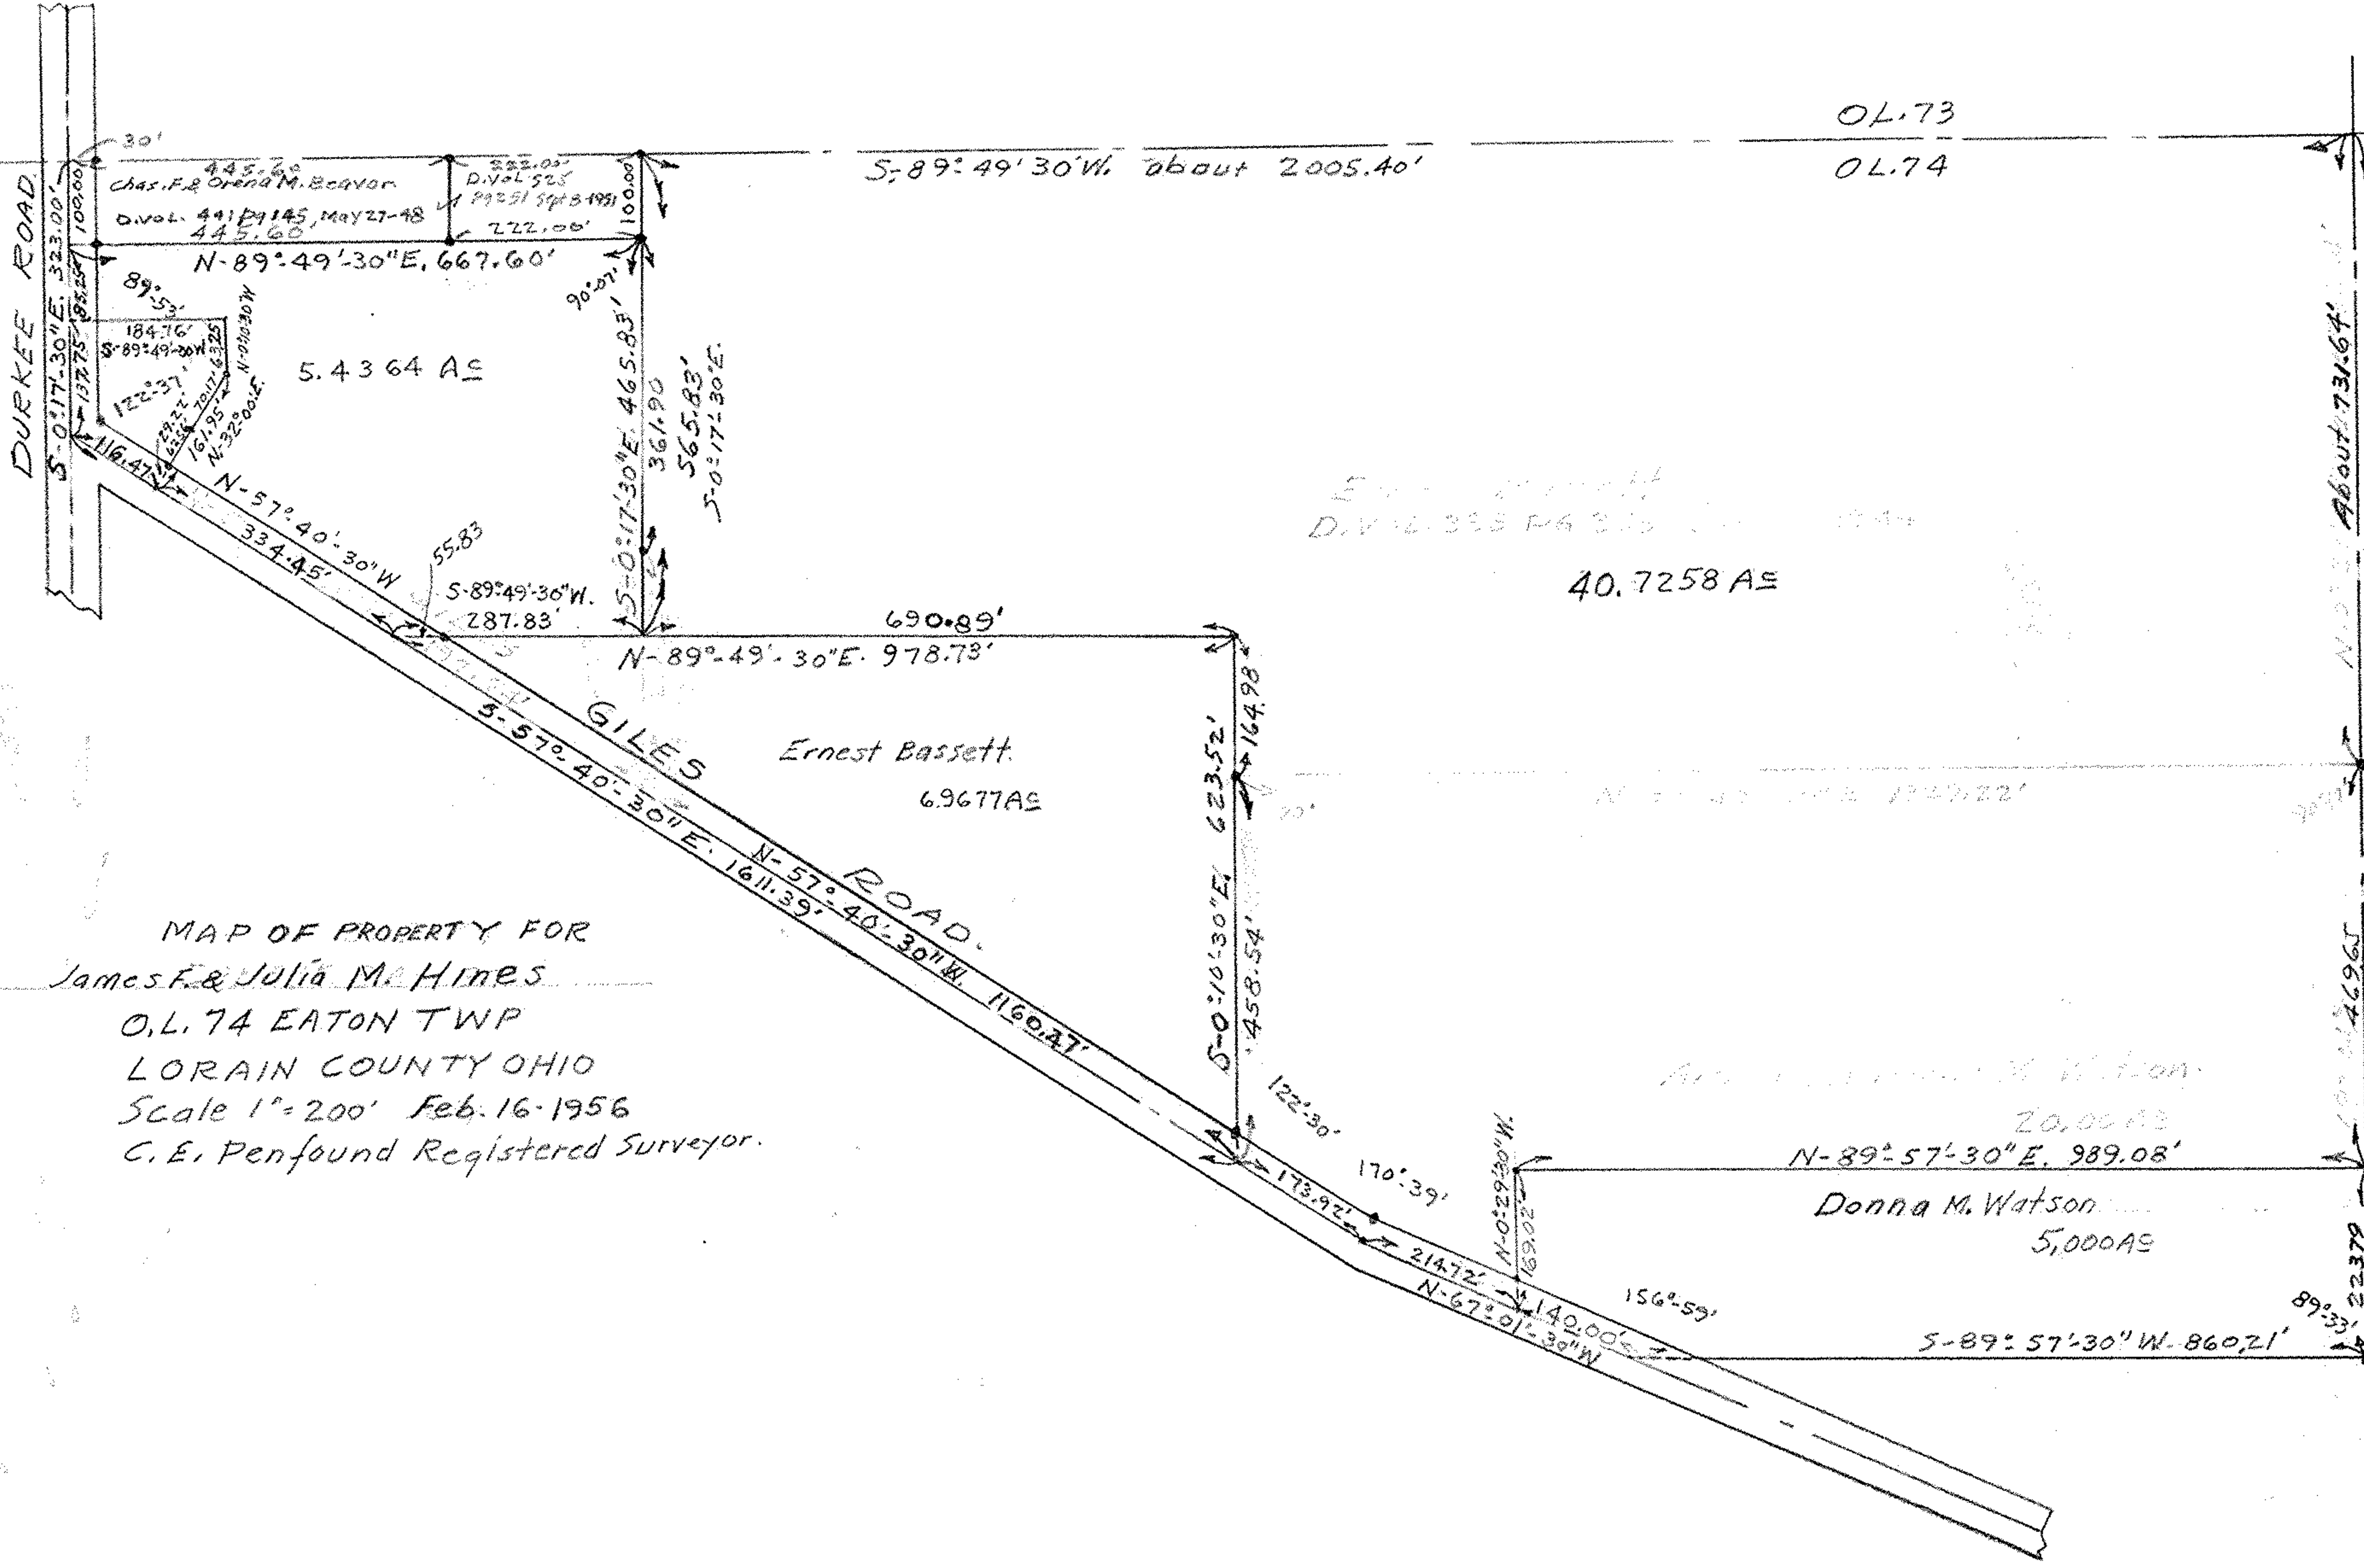

MAP OF PROPERTY FOR
James F. & Julia M. Hines
O.L. 74 EATON TWP
LORAIN COUNTY OHIO
Scale 1"=200' Feb. 16, 1956
C. E. Penfound Registered Surveyor.