

O.L. 2
O.L. 19


Henry S. Rockwood Oct. 7, 1834 D. Vol. 8 Pg. 11.

April 7, 1840
D. Vol. 8 Pg. 112

LAGRANGE
D. Vol. 32 Pg. 31
May 5, 1870

TWP. CEMETERY
D. Vol. 88 Pg. 335
July 1902

4.206 Acres

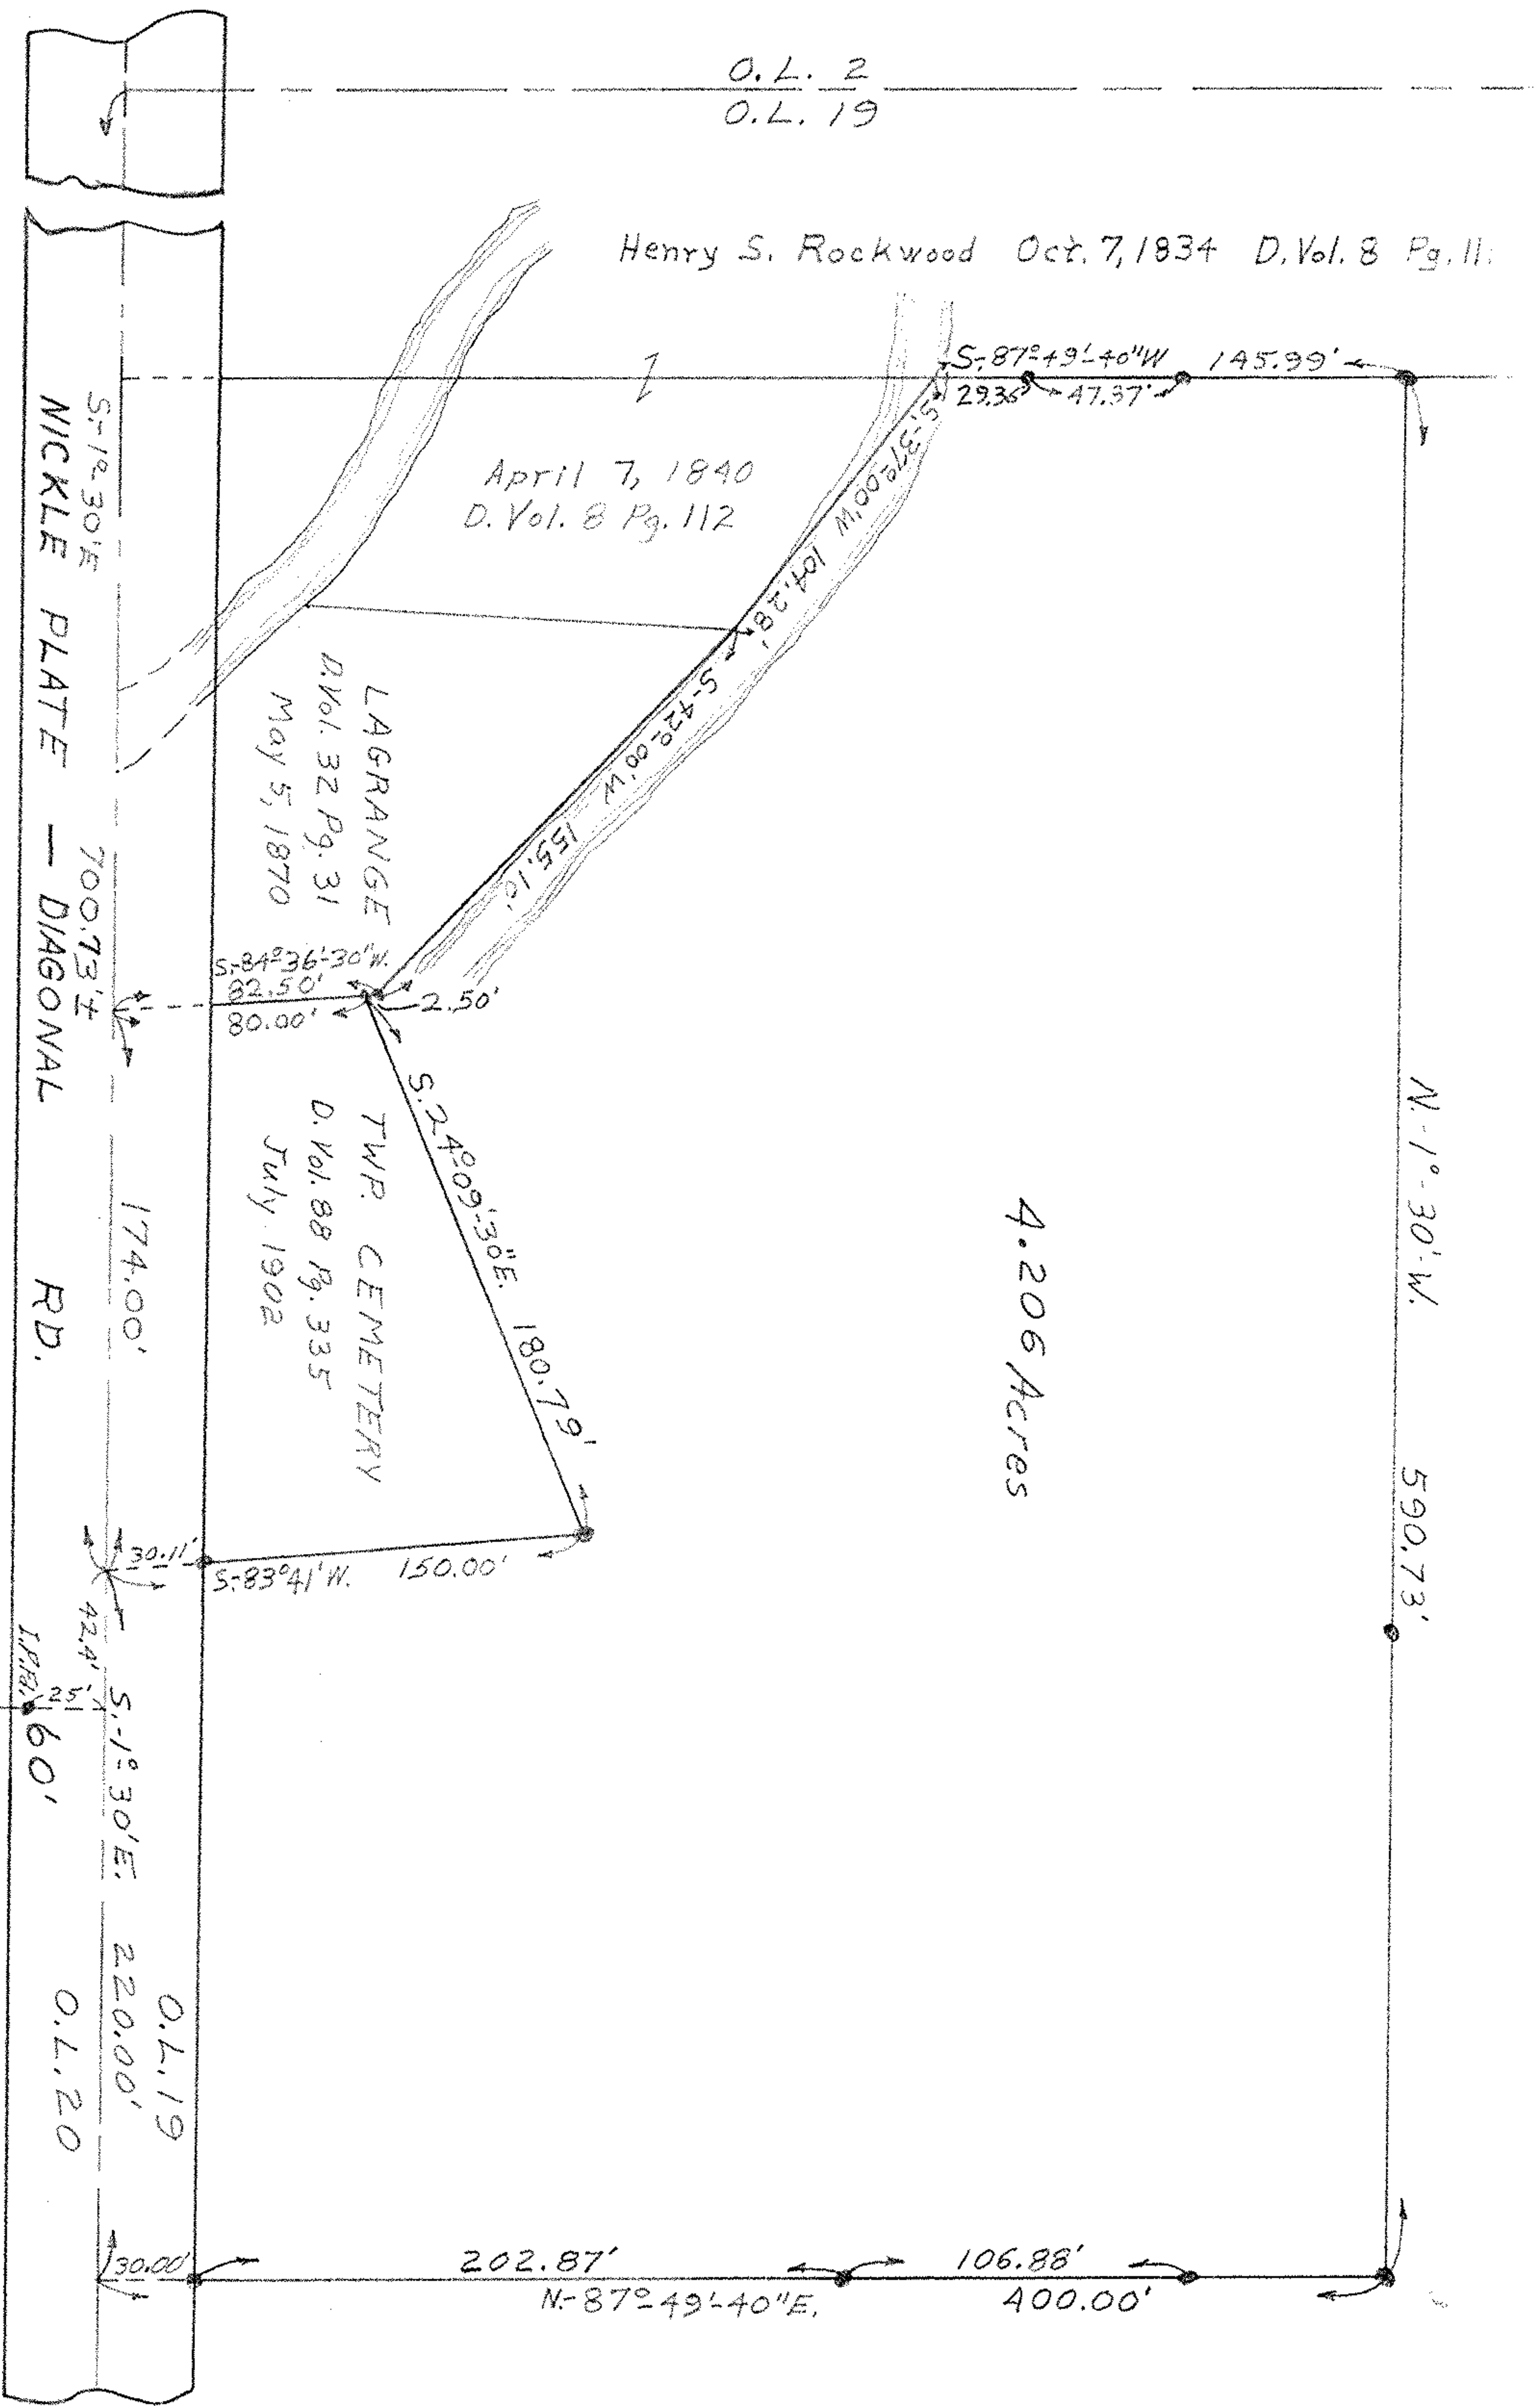

Note: Iron pins found or set show thus: ●

PLAT OF SURVEY FOR FRED SMITH

ORIGINAL LOT 19 - LAGRANGE TWP.

LORAIN COUNTY - OHIO

SCALE: 1"=60'

APRIL 29, 1957