


$\mathcal{L}$  NORTH CENTRAL DRIVE - 50'

**LEGEND**  
 ● = IRON PIN FOUND  
 ○ = IRON PIN SET

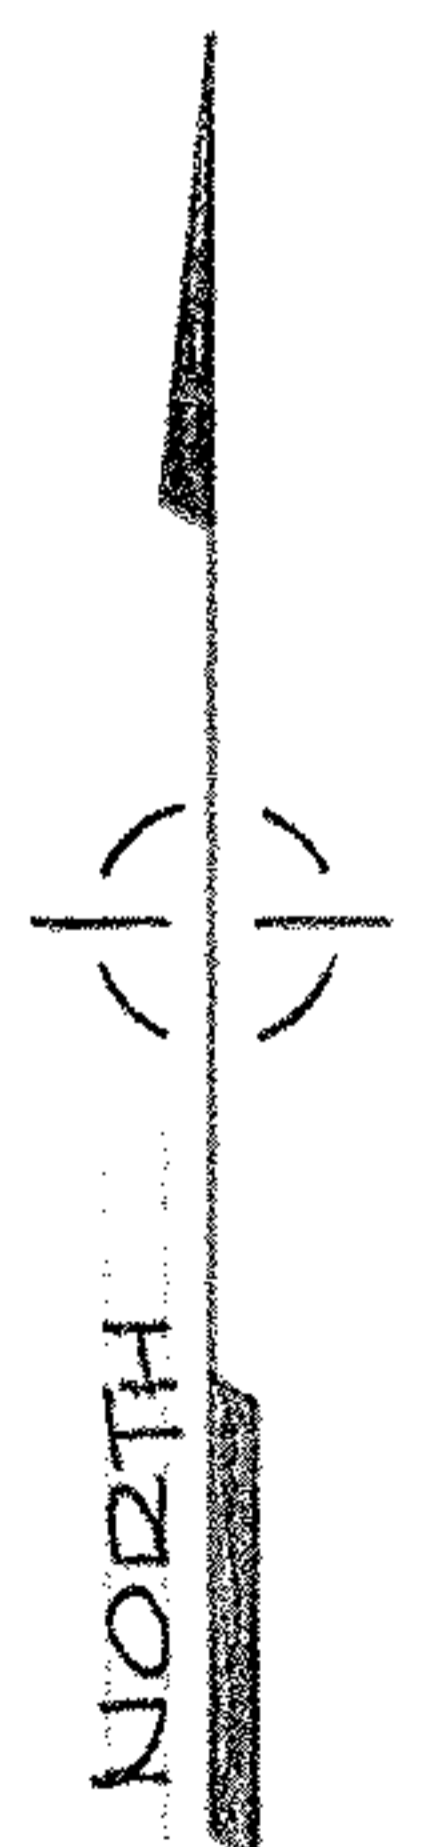

**MAP of PROPERTY SURVEY & BUILDING LOCATION**

SCALE: 1"=10'

SUBLOT No. 2 in CENTRAL PARK SUBDIVISION - PLAT VOL. 70, PAGE 3  
 PART of ORIGINAL BLACK RIVER TOWNSHIP LOT 6, TRACT 1  
 CITY of LORAIN LORAIN COUNTY OHIO

McGLINCHY and ASSOCIATES INC.  
 PROFESSIONAL ENGINEER and SURVEYORS  
 110 1/2 MIDDLE AVE. ELYRIA, OHIO  
 JUNE, 1981 #816819