


LEGEND

- INDICATES 1/2" IRON PIN SET
- ☆— INDICATES RAILROAD SPIKE FOUND
- INDICATES PK NAIL SET

SURVEY
FOR
MELVIN PIPPERT

PART BROWNHELM TOWNSHIP ORIGINAL LOT 30
CITY OF VERMILION LORAIN COUNTY, OHIO
APRIL 1997 SCALE 1"=80'

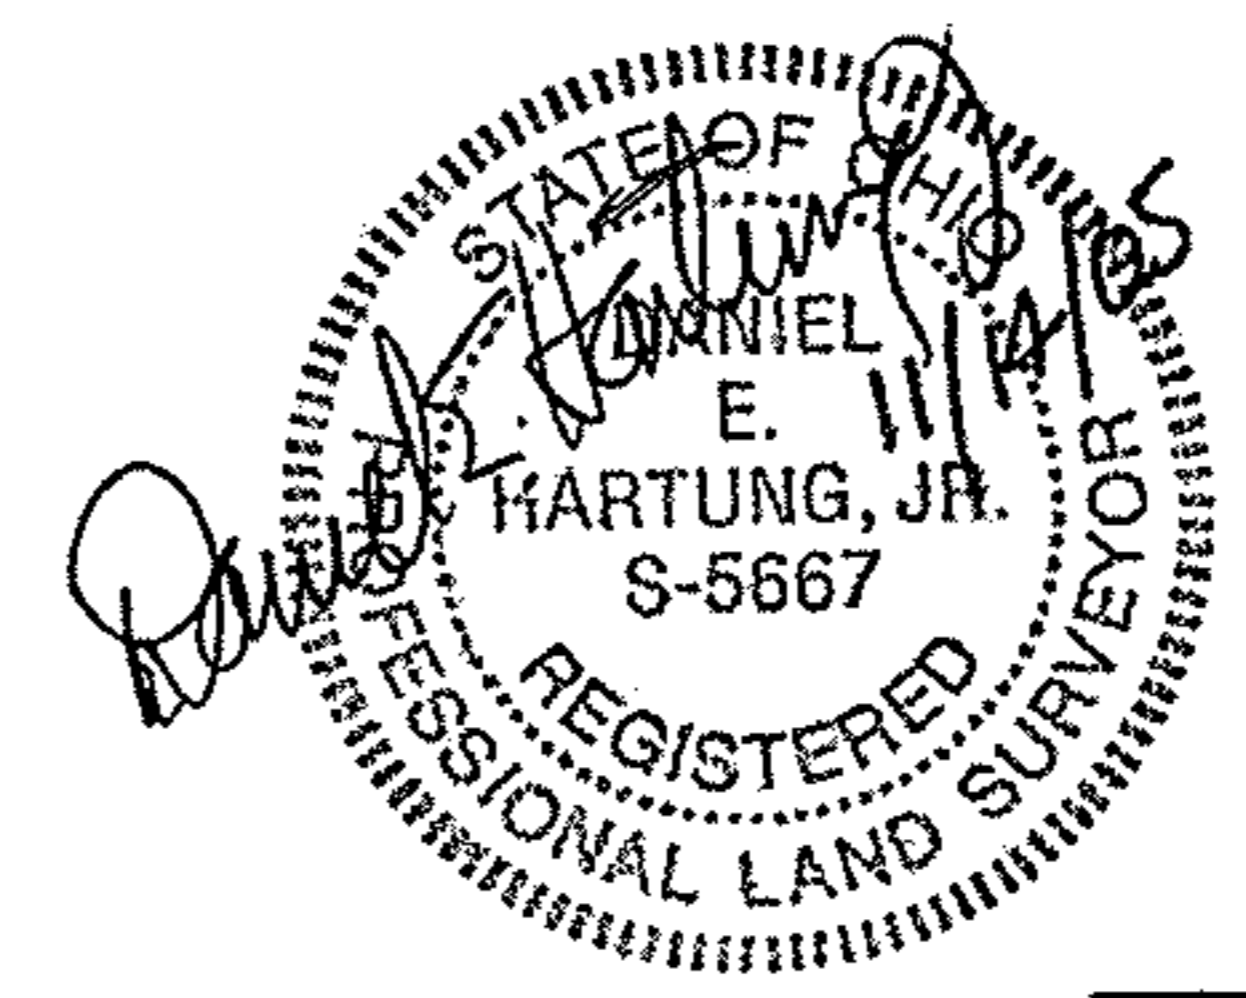

I HEREBY CERTIFY THE WITHIN
TO BE A TRUE REPRESENTATION
OF A SURVEY MADE BY ME.

Daniel E. Hartung, Jr.
DANIEL E. HARTUNG, JR., PE, PS

HARTUNG & ASSOCIATES
ENGINEERS & SURVEYORS

P.O. BOX 426, 421 WILLIAMS ST., HURON, OH 44839-0426
(419) 433-4321 FAX(419) 433-7879

DANIEL E. HARTUNG JR., PE, PS