
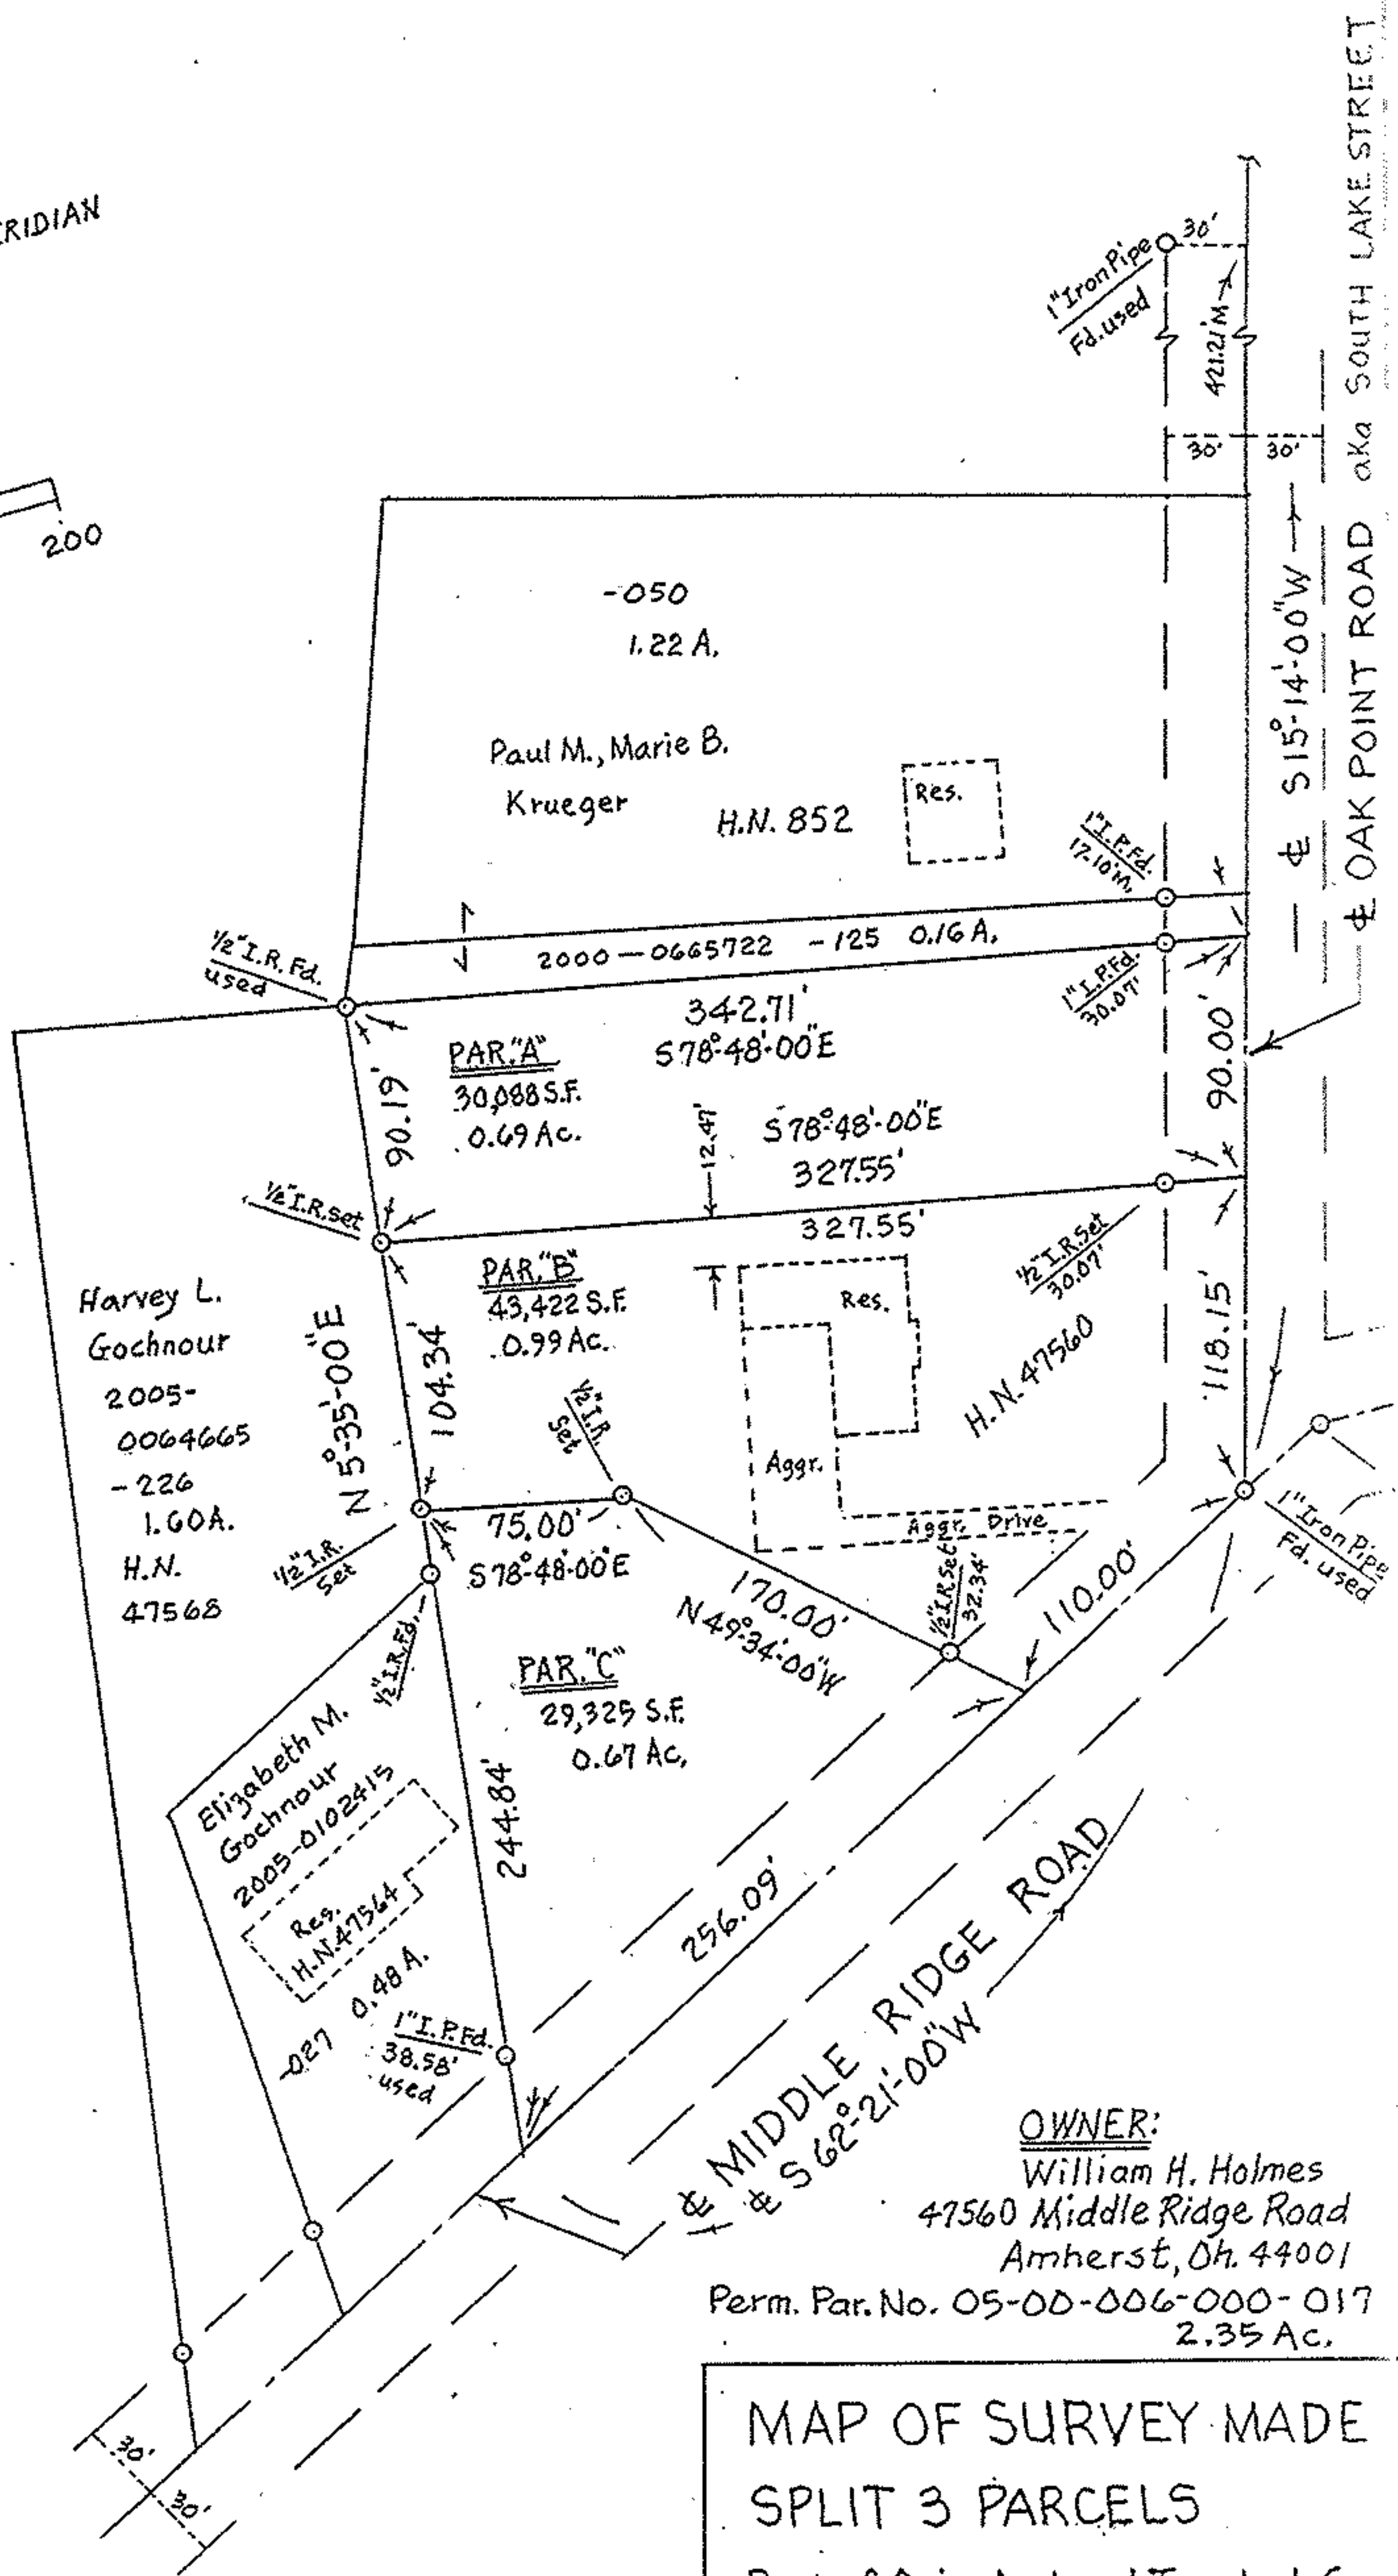


NORTH

ASSUMED MERIDIAN

SCALE  
1"=100'

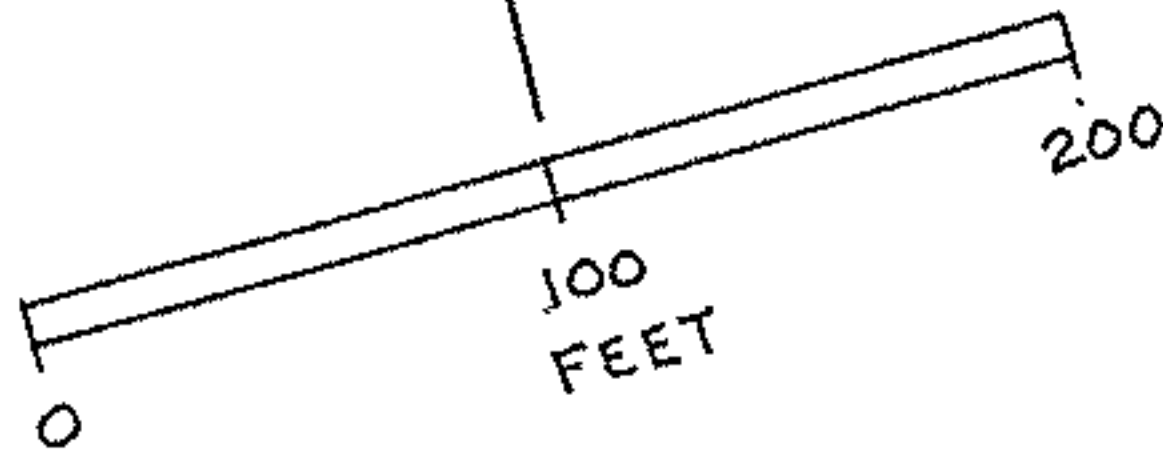

No 02215

APPROVED  
LORAIN CO.  
ENR DEPT

DATE: 8-31-06

5-00-006-A

BY JHATFIELD

# 06-02215

OWNER:  
William H. Holmes  
47560 Middle Ridge Road  
Amherst, Oh. 44001  
Perm. Par. No. 05-00-006-000-017  
2.35 Ac.

MAP OF SURVEY MADE  
SPLIT 3 PARCELS  
Part of Orig. Amherst Twp. Lot 6,  
Amherst, Lorain Co., Ohio  
May 10, 2006

Charles P. Waryu May 10, 2006  
CHARLES P. WARYU  
Registered Surveyor No. 5029