



-018  
Gladys I. Giese  
Doc. 05-0061847

1" pipe  
IPF  
S89°45'10"E 60.00'

IPS S89°45'10"E 200.00' IPS

Plat of Survey  
for  
**Tom & Theresa Giese**

Grafton Twp. O.L. 13  
Lorain Co. Ohio

Carlson Surveys  
August 11, 2005

1469.22'd.  
1469.41'm. 1469.41'


Rem. -013  
43.53 ac.  
by Auditor

N00°24'12"E  
1409.41'

6.471 ACRES

Thomas E. Guyer, Jr.  
-015  
Doc. 99-0613078

IPF= Iron Pin Found as noted  
IPS= Iron Pin Set  
5/8" re-bar with cap stamped Carlson

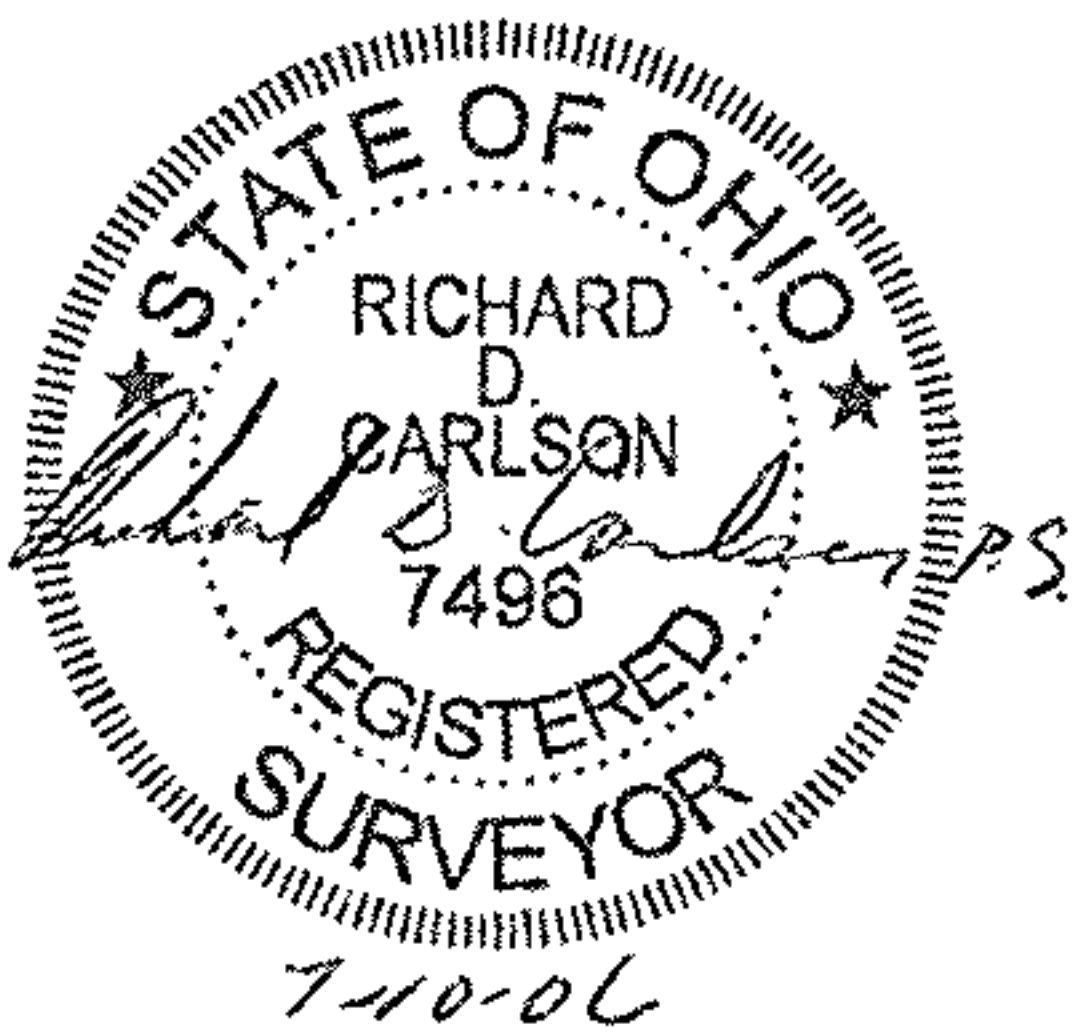

Island Rd. 60'

33.00' c/1  
IPS

5/8" re-bar  
33.00' c/1  
IPF

1771.66' 200.00'  
MON N89°45'10"W N89°45'10"W  
1971.66'm 1972.10'd

Grafton Eastern Rd. 66'

GRAPHIC SCALE

1"=200'



No 02235

10-12-04

16-B

J Hatfield

# 06-02235