


- ☒ Monument Box
- ✕ Iron Pin Set
- Iron Pin Found

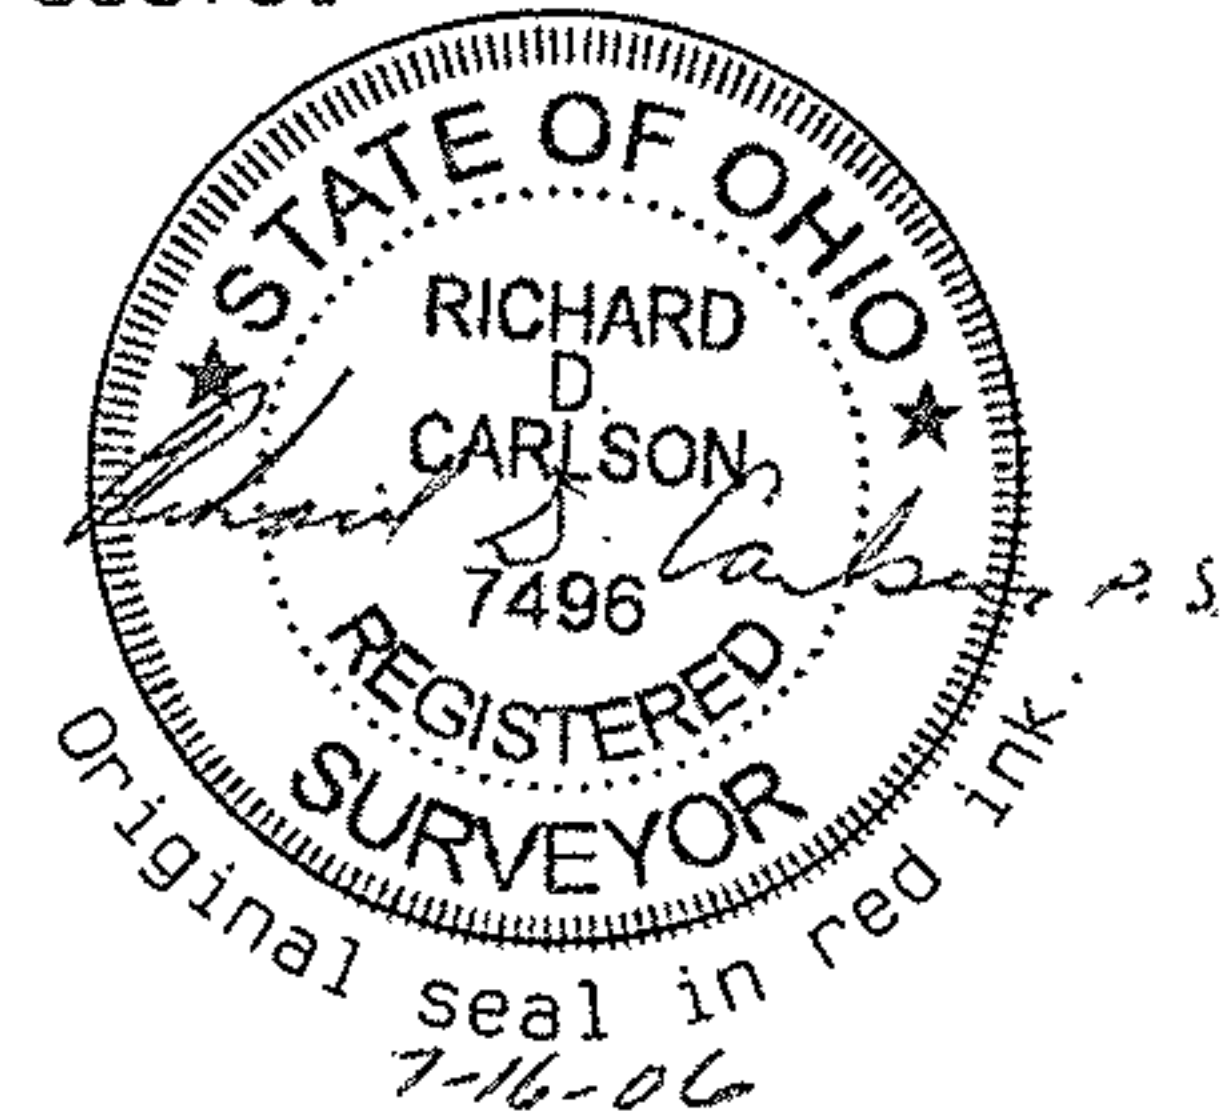

Plat of Survey
for
Gladys Giese

Grafton Twp.
Lorain Co.

Carlson Surveys

Job: 1601-60

No 02235
 June 28, 2006
 O.L. 13
 Ohio
 10-17-2006
 16-13
 JWAFFIELD
 #06-02235