


WILLIAM B. BARTON
 Reg. Land Surveyor No. 4438
 188 PARKWOOD AVENUE
 AVON LAKE, OHIO 44012
 TELEPHONE (216) 933-6662

Village of Wellington
 18-00-028-101-129

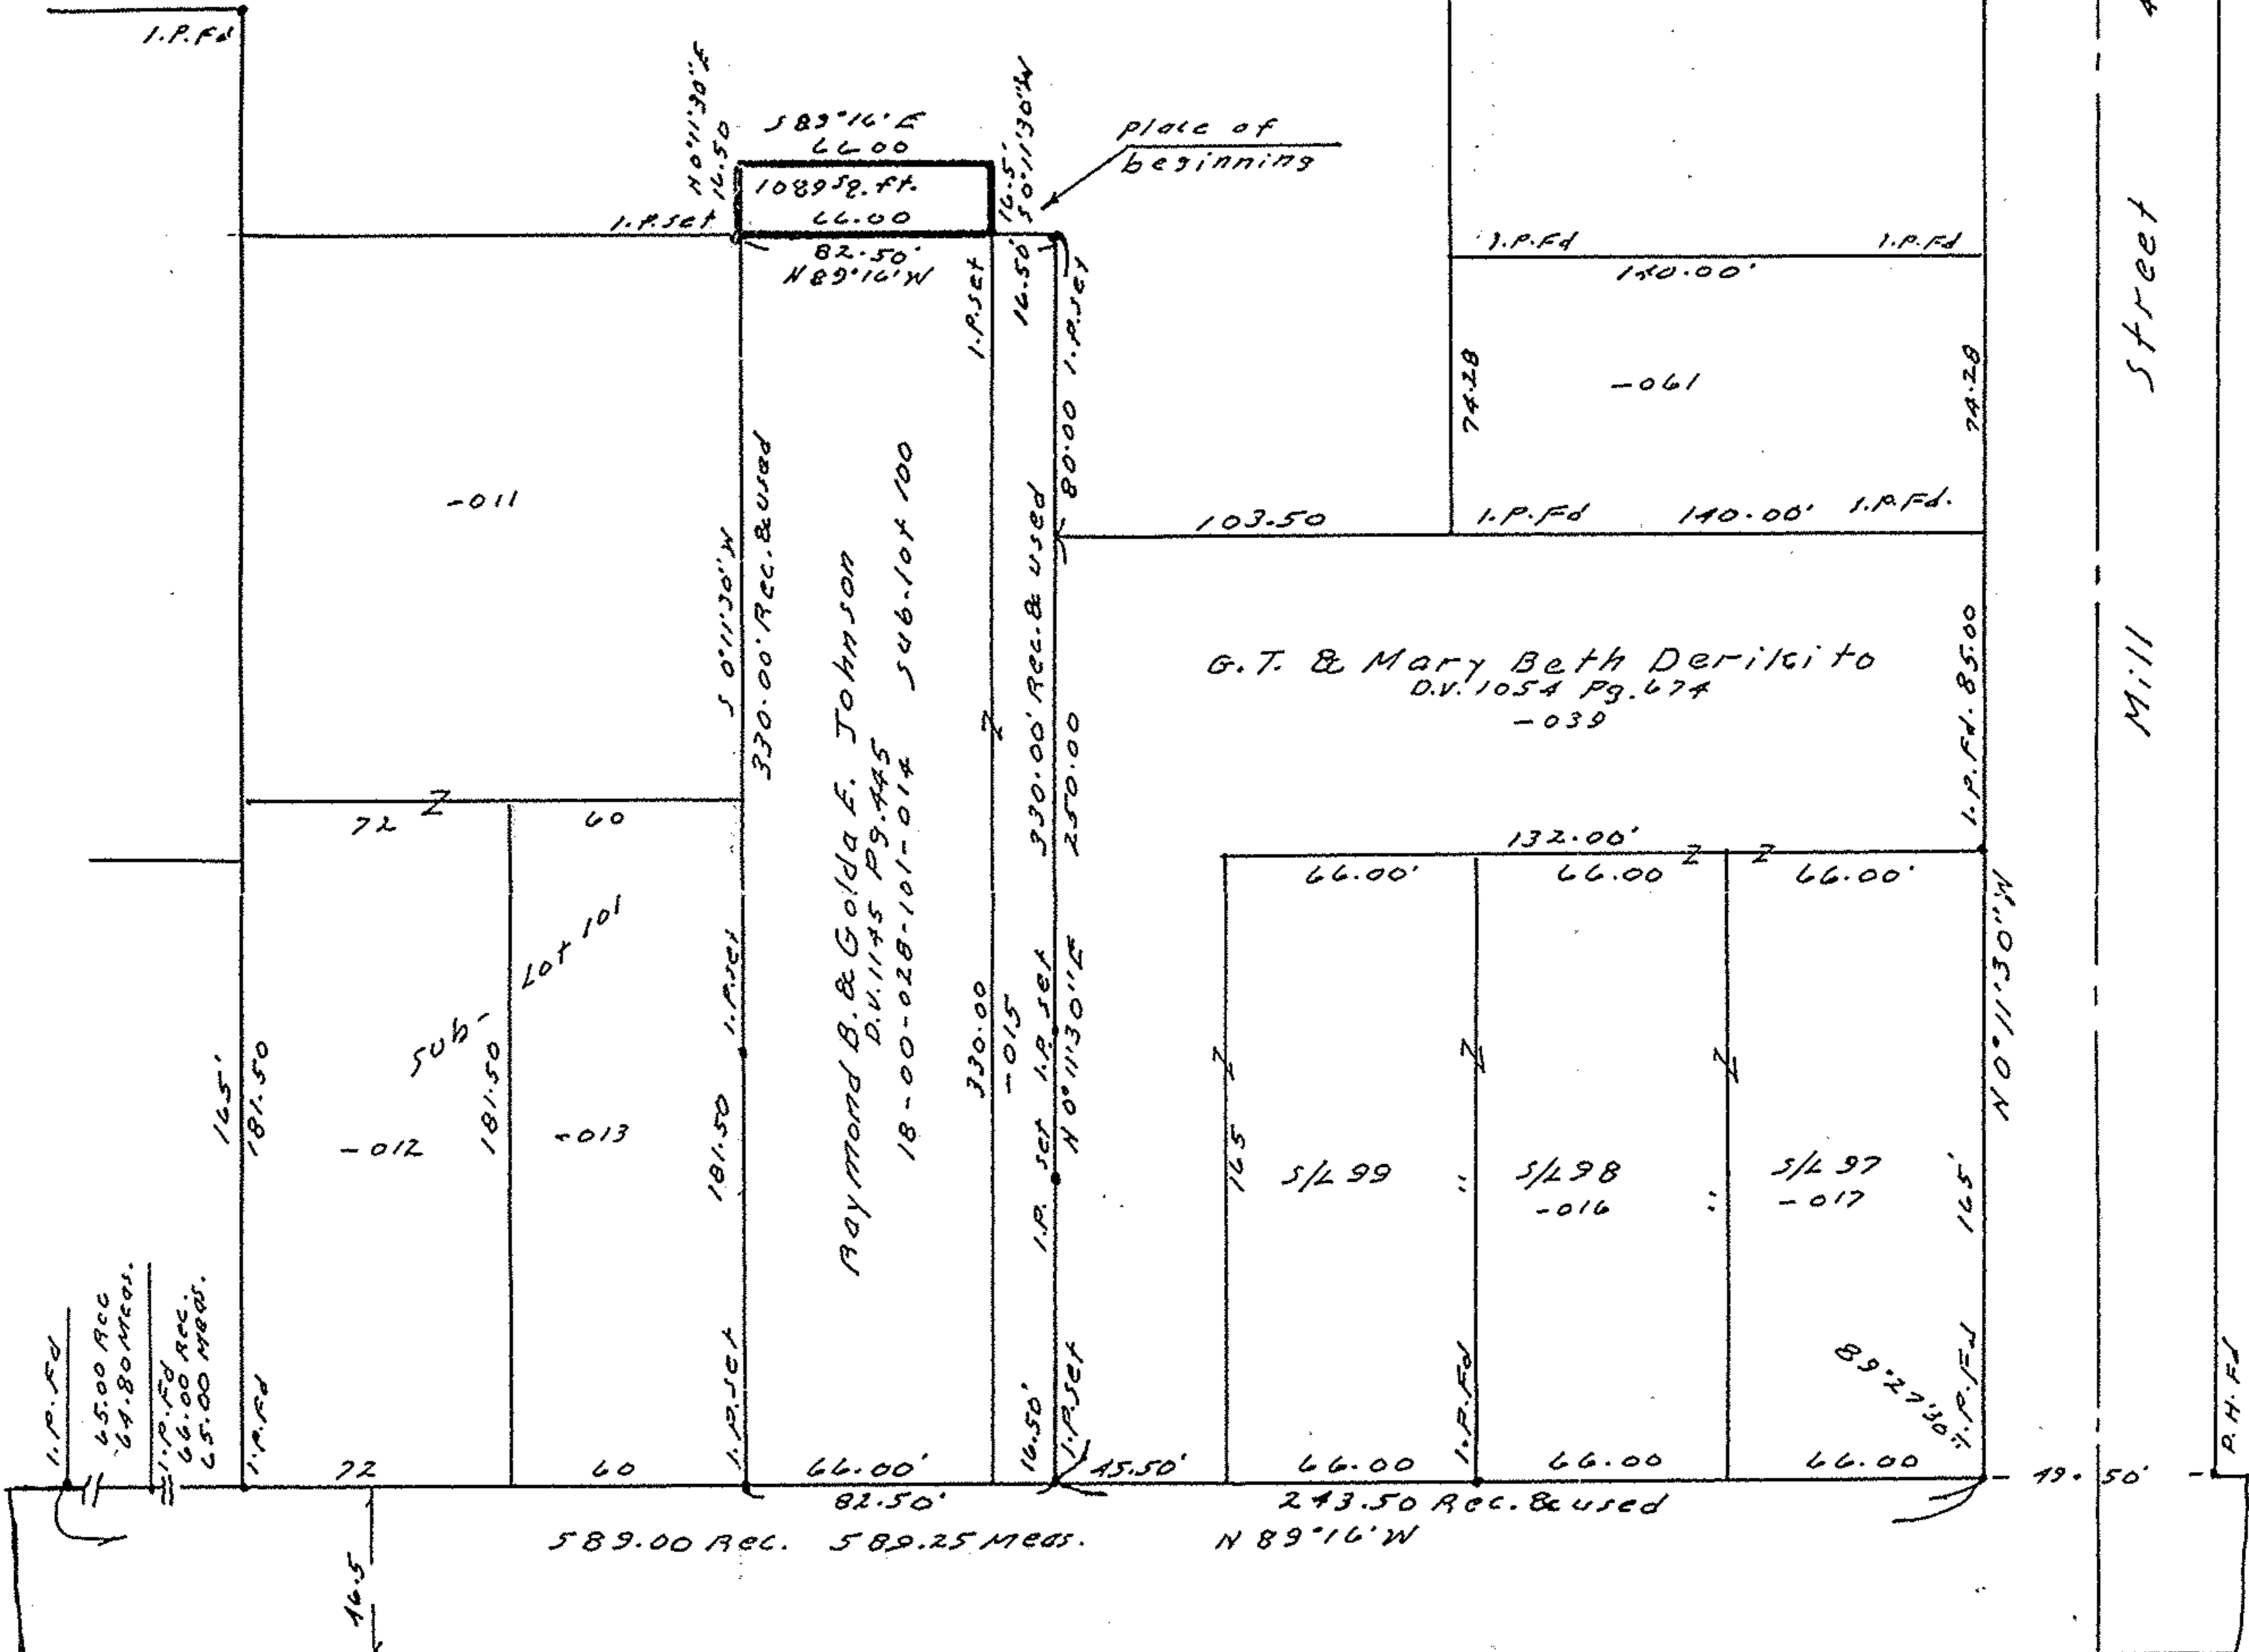

18-00-028-101-014, 012, 013, 011, 029, 061, 039, 016, 017

SURVEY
 OF
 Part of Original Lot No. 28, Wellington
 Township, Lorain County, Ohio.
 Scale 1"=60' June 24, 1987

#17568

APPROVED
LORAIN CO.
MAP DEPT.
DATE 8-3-87
PAGE 18-00-028-C
BY C. Francis
VOID AFTER 17568



A-047