


Var R/W MB Elyria Twinsburg Rd N 88° 53' 25" W  
 SR 82

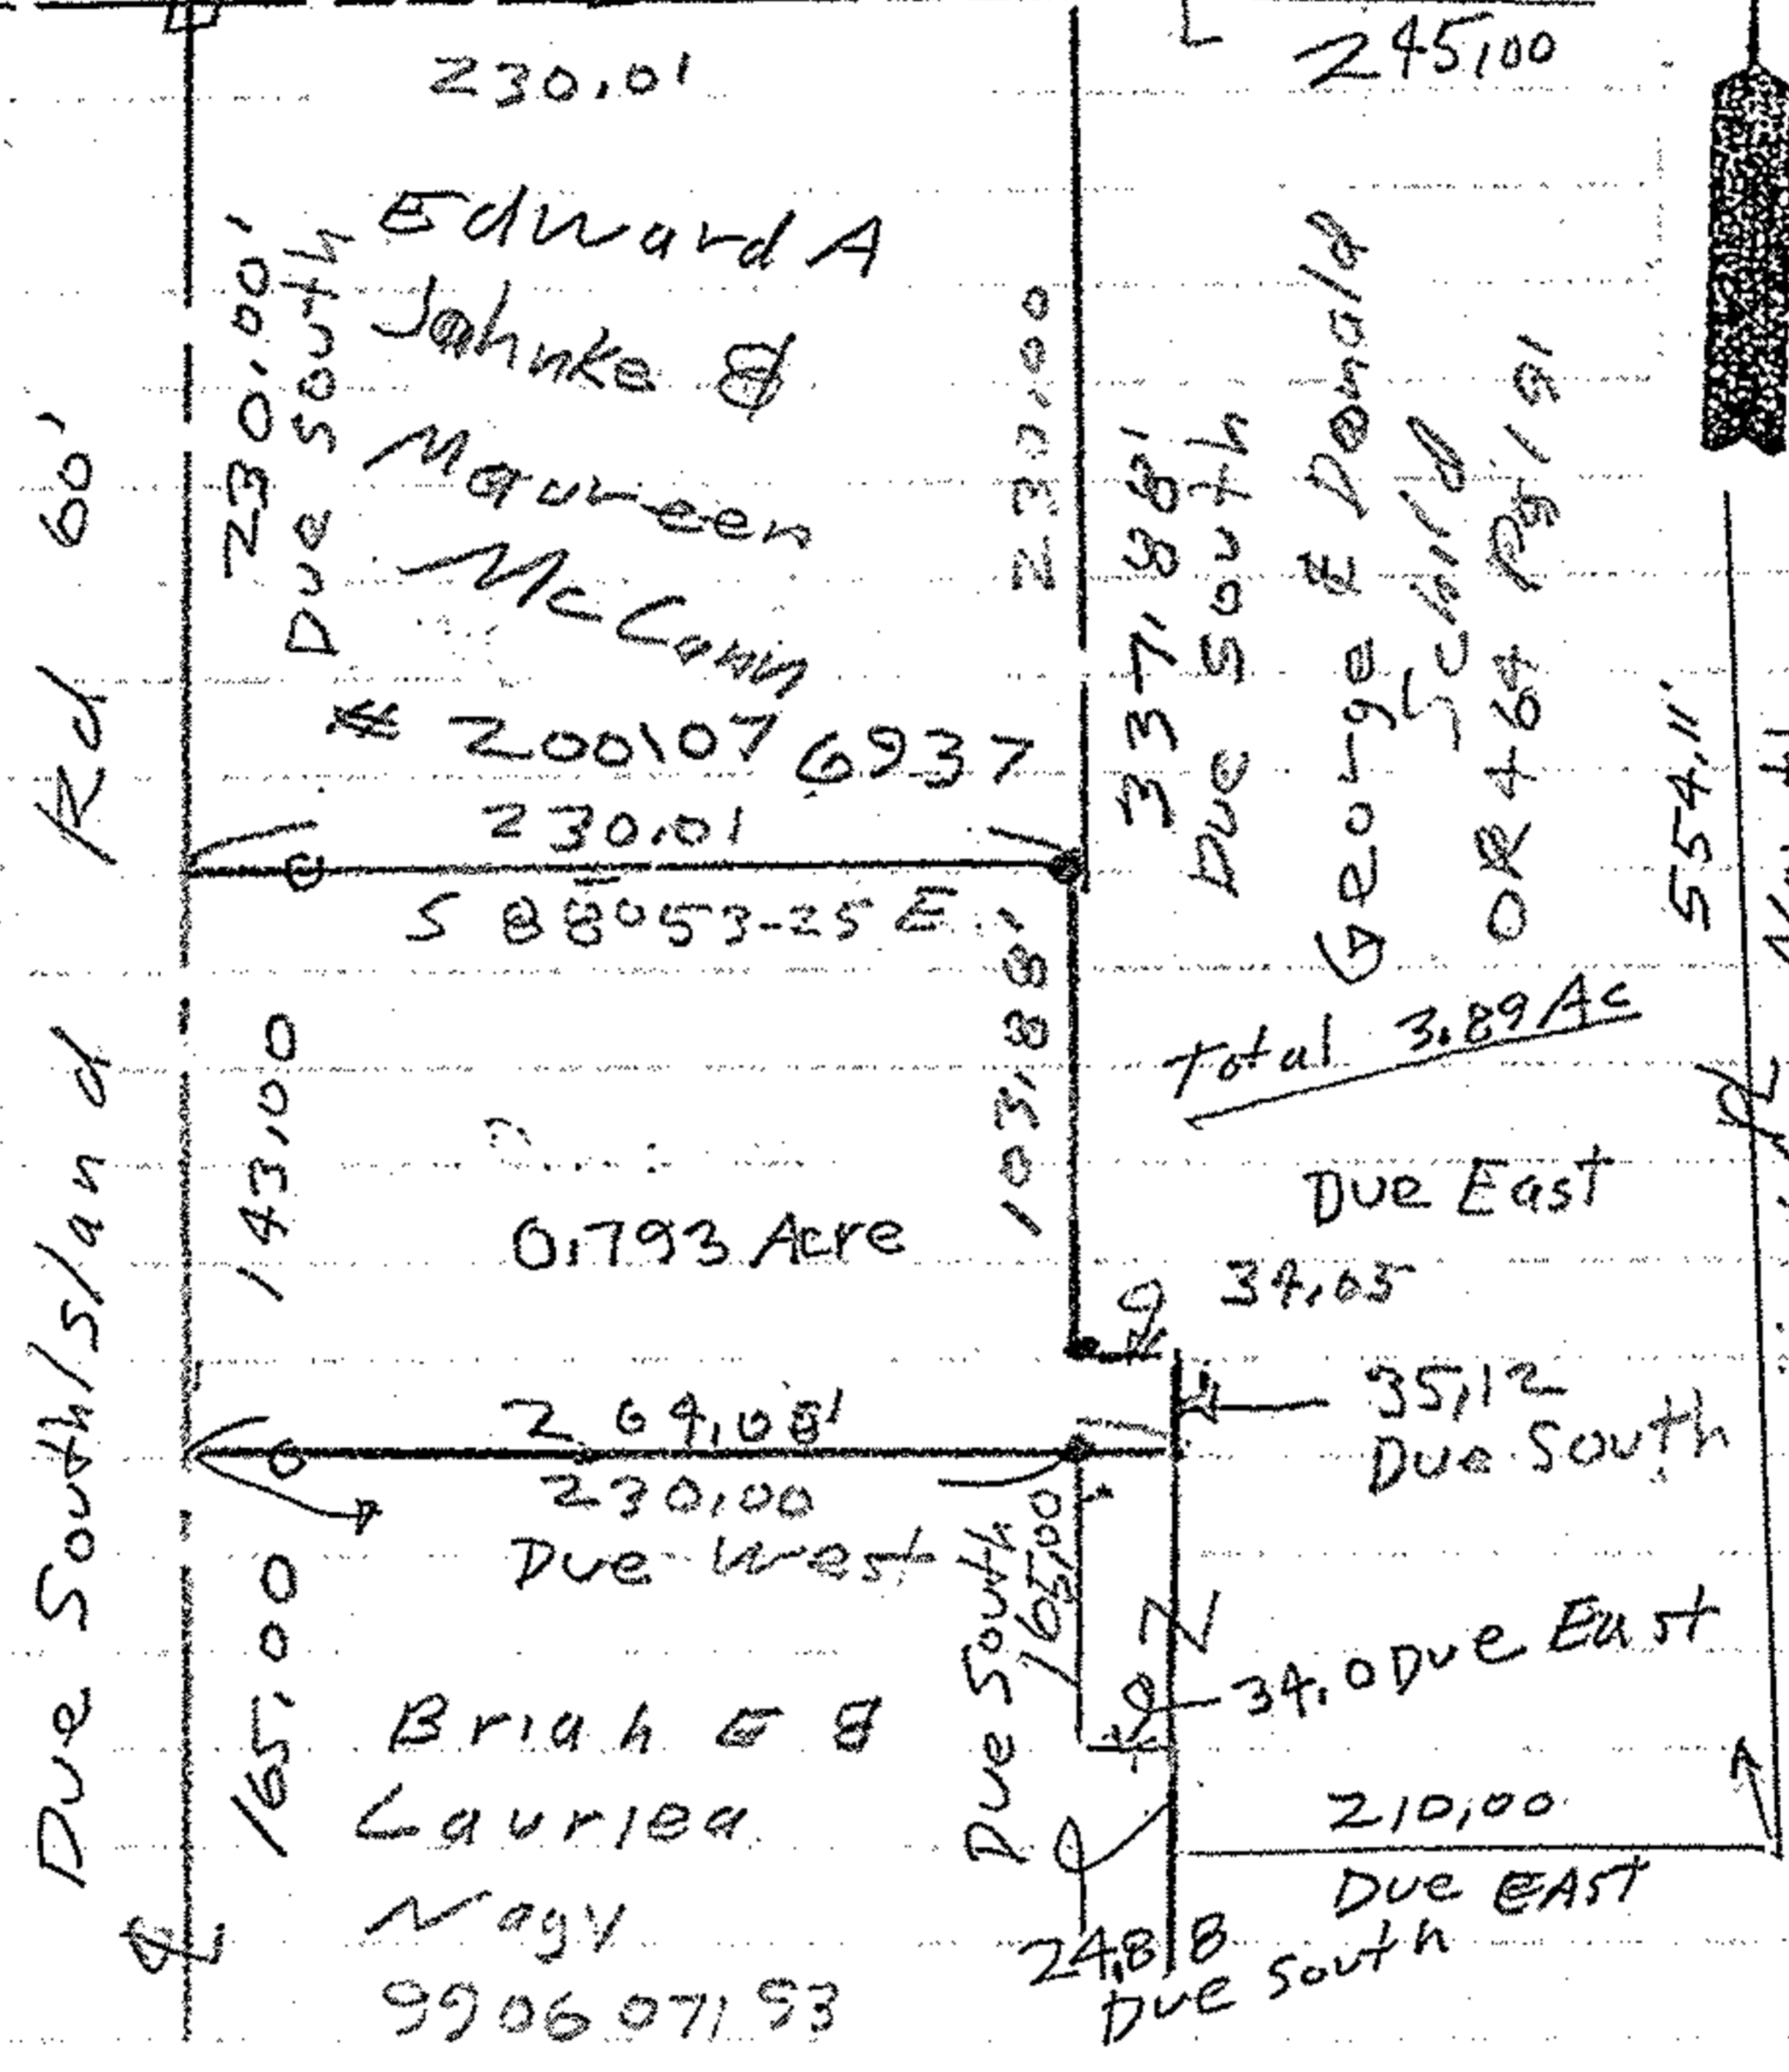

GPR Ventures Inc  
 20050072180

No 02293

12-21-06


4.00-025-A

UHA Field

#06-02298

- ☐ Monument Box
- Iron pins set
- Iron pins set

Survey of A Parcel  
 Split in Original Lot  
 25 Eaton Twp  
 Lorain County, OHIO  
 Scale 1" = 100'  
 August 2006  
 revised

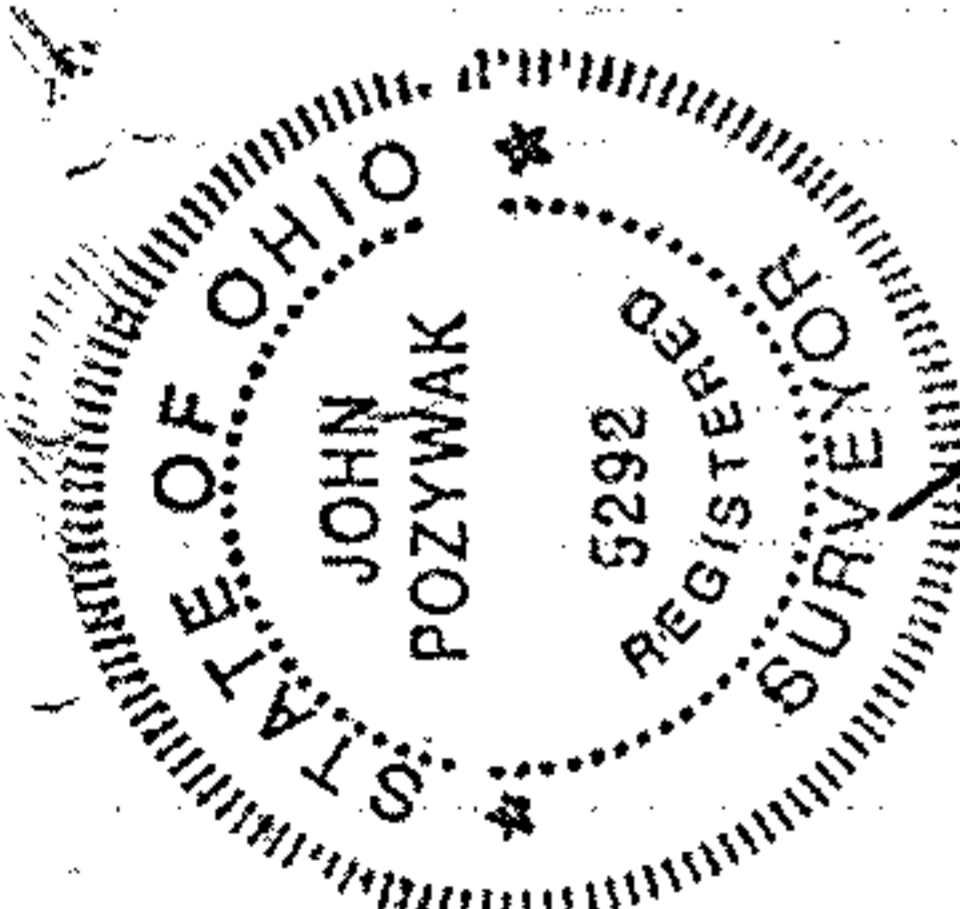

John Pozywak