


SURVEY FOR THE CATHER LIVING TRUST
 PART OF ORIG. PENFIELD TWP. LOT 3 IN TRACT No. 1
 PENFIELD TWP., LORAIN COUNTY, OHIO
 SCALE 1" = 300' DECEMBER 10, 2006

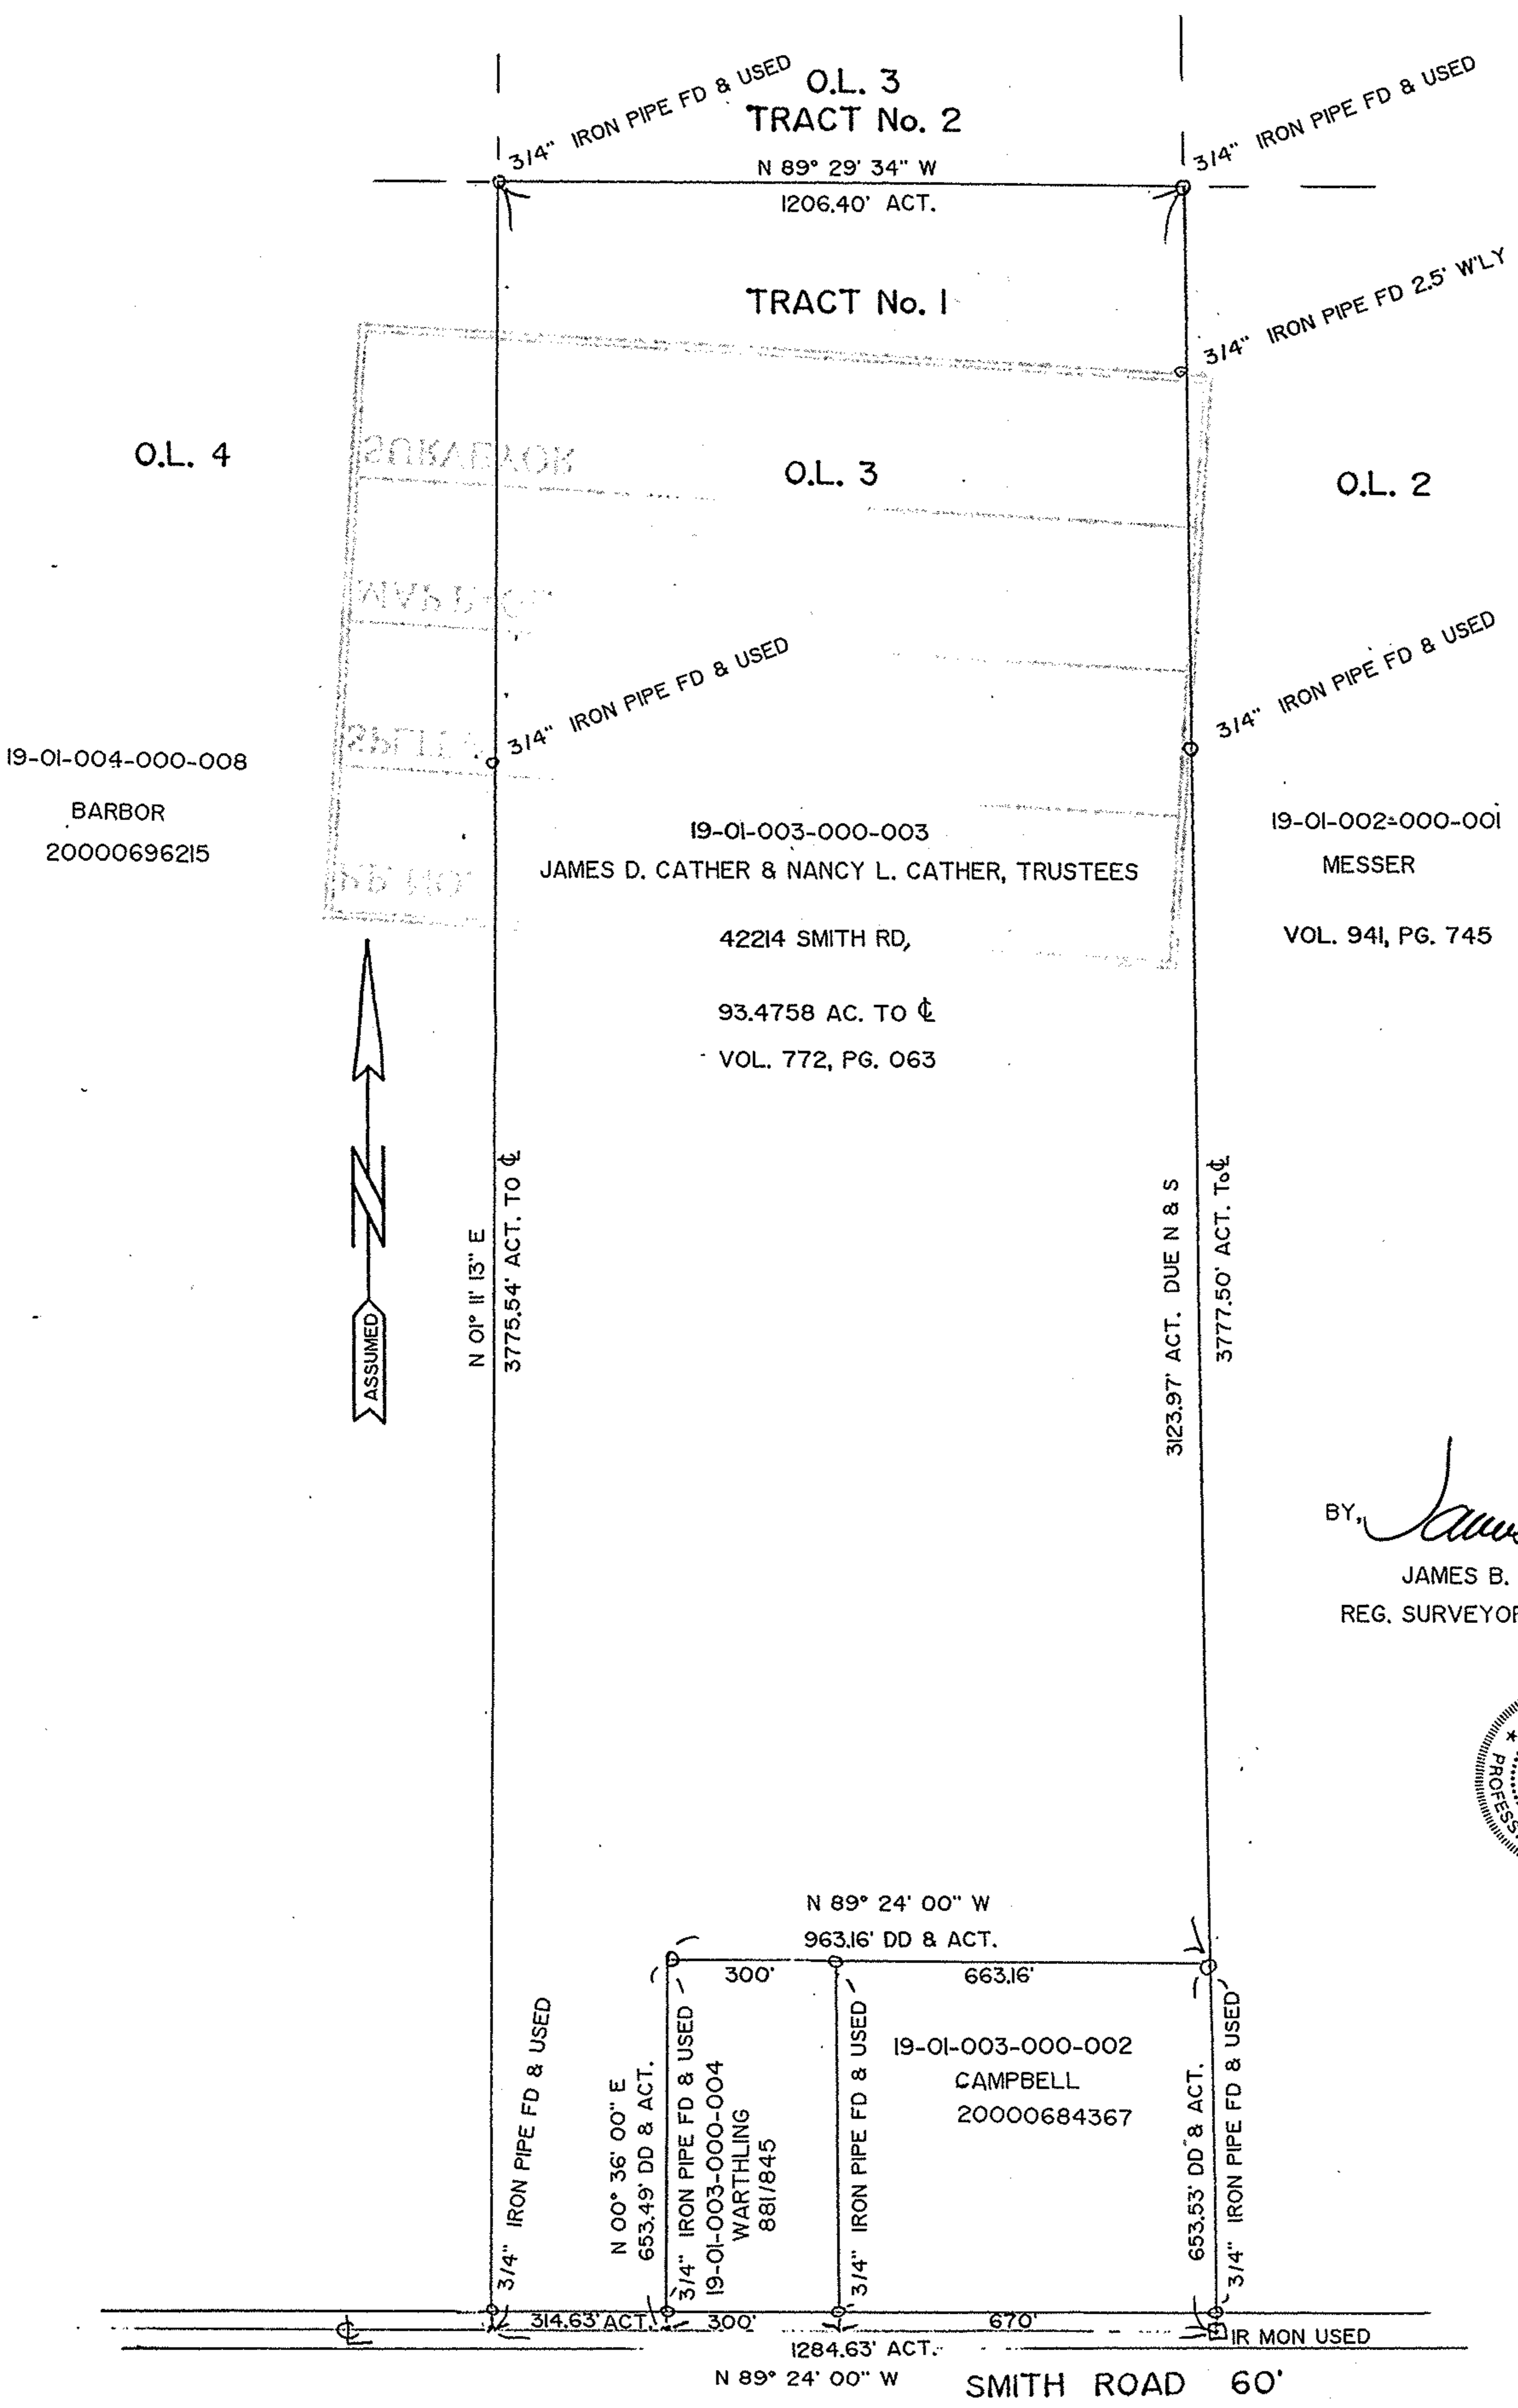

19-01-004-000-008
 BARBOR
 20000696215

19-01-002-000-001
 MESSER
 VOL. 941, PG. 745

BY, *James B. Root*
 JAMES B. ROOT
 REG. SURVEYOR No. 5045

