

KLEINOEDER · SCHMIDT

and ASSOCIATES

ENGINEERS — SURVEYORS — CONSULTANTS in LAND PLANNING
OHIO

ELYRIA · NORWALK · MEDINA

SURVEY

Sublot(s) _____

Subd'n _____

Township SHEFFIELD

Tract _____

Orig. Lot(s) 112

Sec. _____


County of LORAIN

State of Ohio

Corporation _____

RICHARD J. FIOR
D.V. 1231 P. 907

0.75 AC.

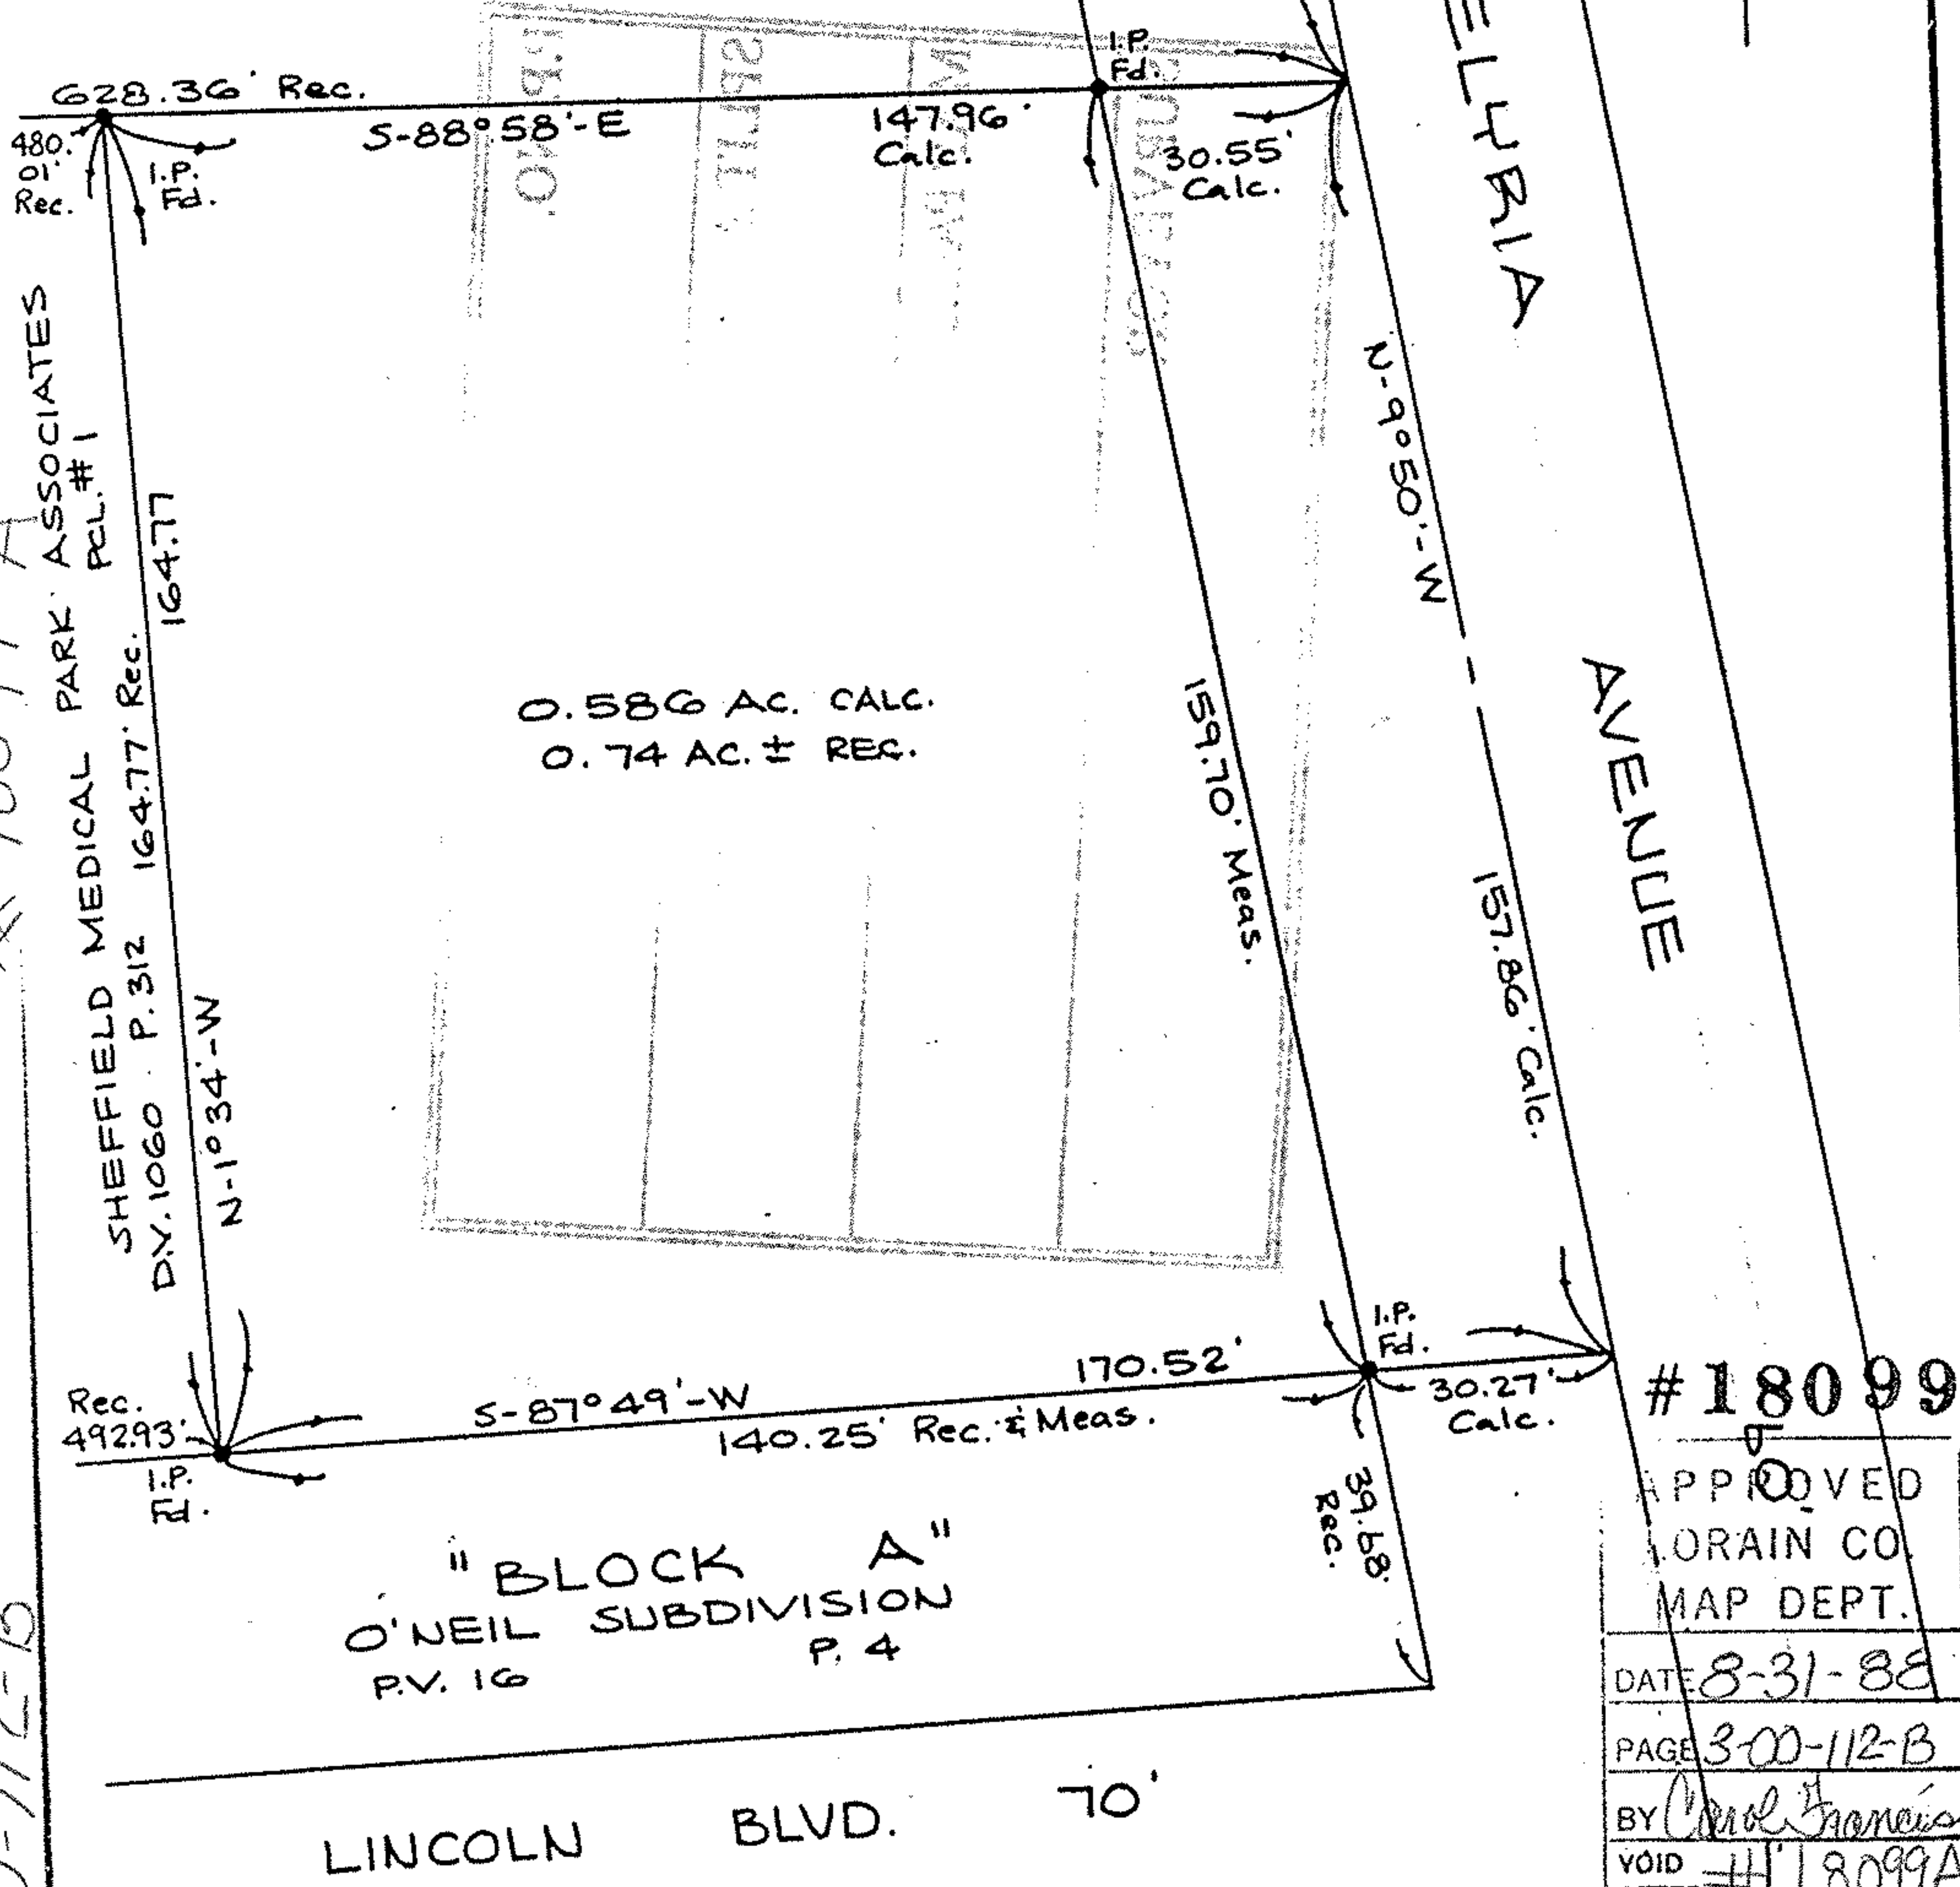

03-00-112-102

18099-A

3-00-112-B

Prepared for:

Scale: 1" = 30'

Date: 10-9-84

Dr. by: *SE*

Job No 84-146

18099 A

APPROVED
LORAIN CO.
MAP DEPT.

DATE 8-31-88

PAGE 3-00-112-B

BY *Carol Francis*

VOID AFTER # 18099A