




CERTIFICATE OF CORRECTION  
"EXHIBIT A"



*David L. Elwell*  
REG. SURV. NO. 6333

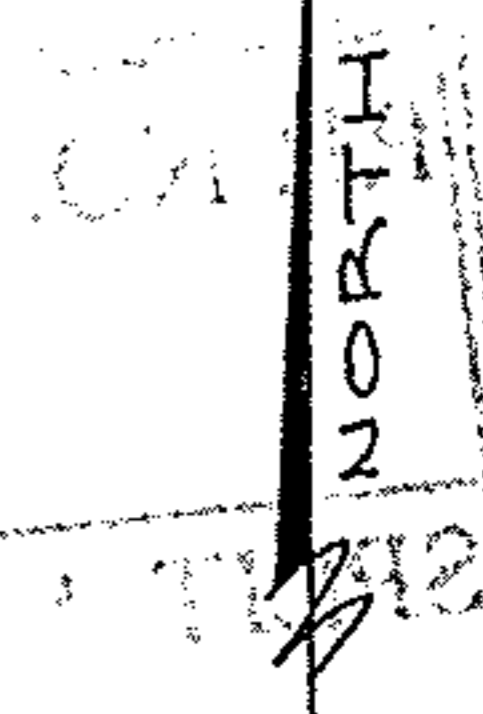

SCALE: 1" = 100'

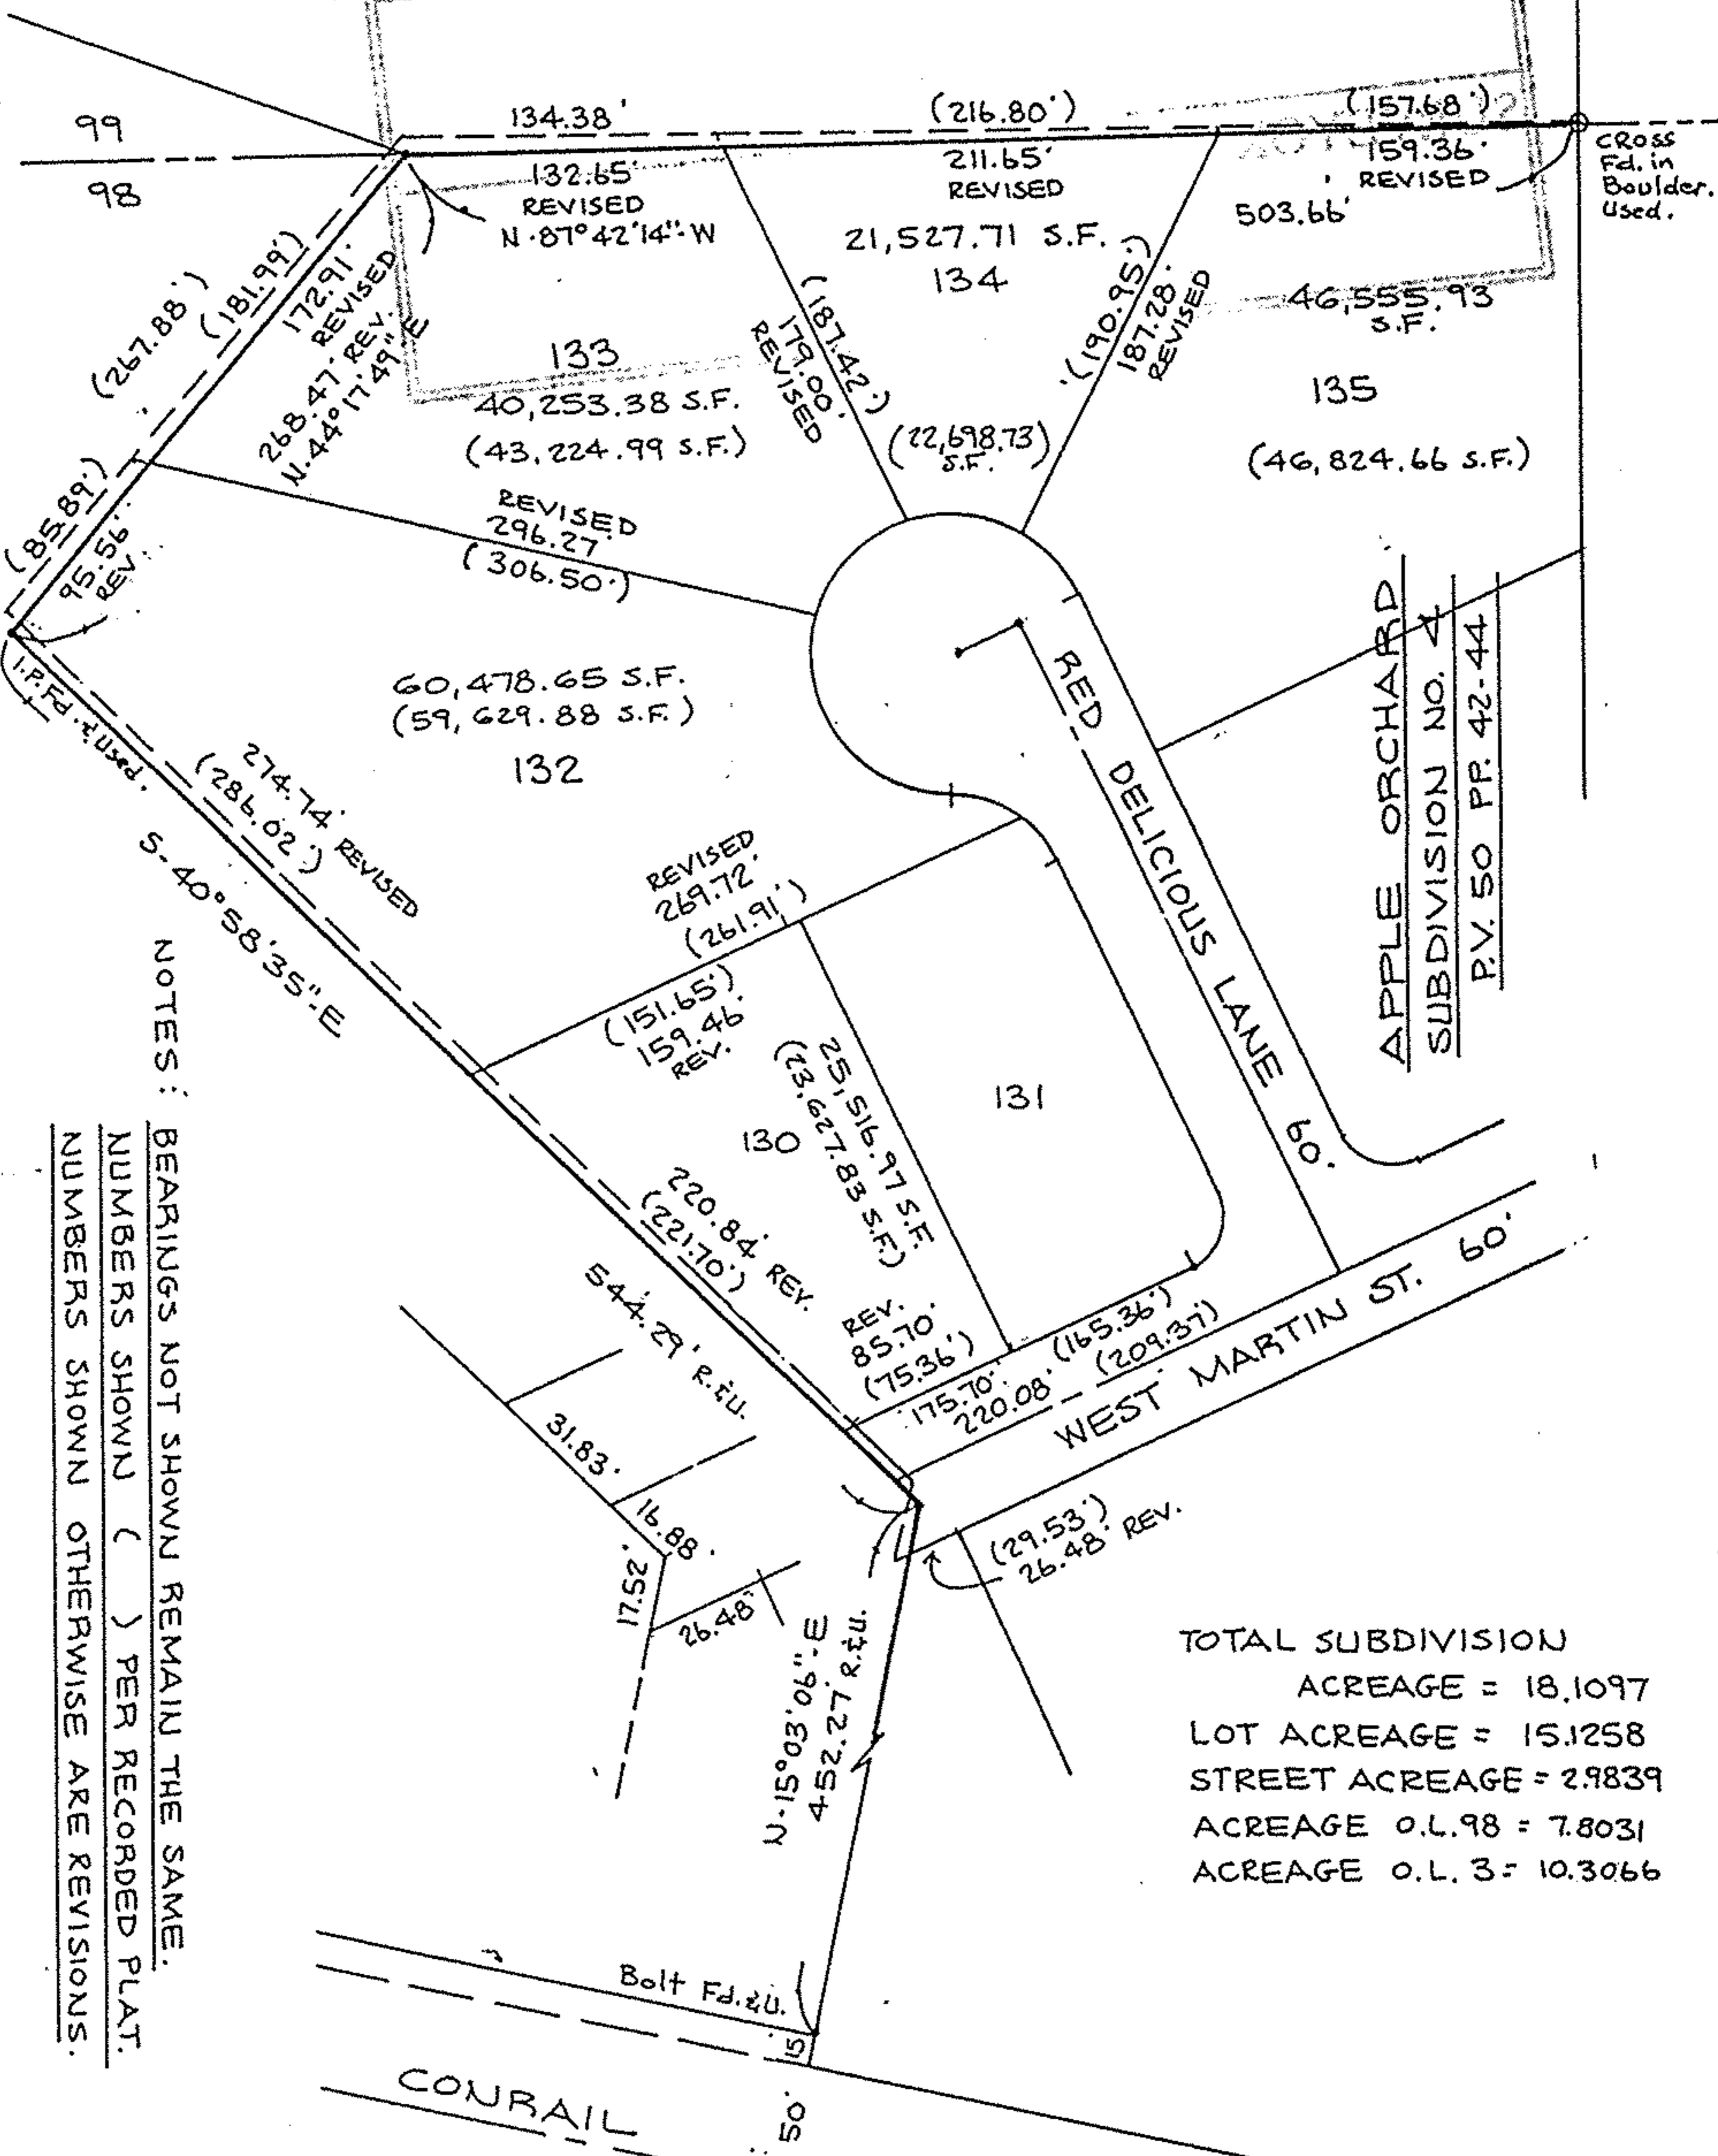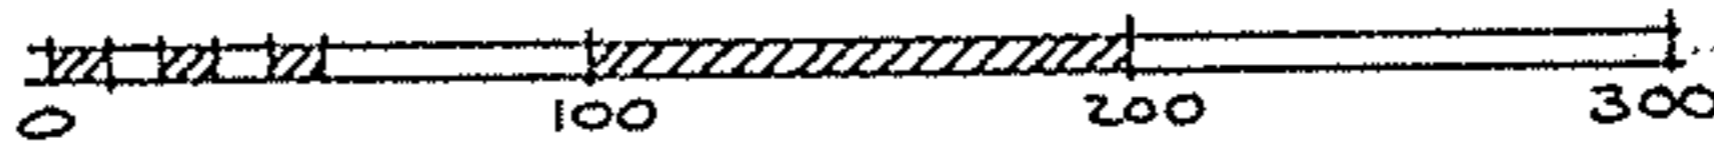

NOTES: BEARINGS NOT SHOWN REMAIN THE SAME.  
NUMBERS SHOWN ( ) PER RECORDED PLAT.  
NUMBERS SHOWN OTHERWISE ARE REVISIONS.

TOTAL SUBDIVISION  
ACREAGE = 18.1097  
LOT ACREAGE = 15.1258  
STREET ACREAGE = 2.9839  
ACREAGE O.L. 98 = 7.8031  
ACREAGE O.L. 3 = 10.3066