

MON. BOX W/ I.P.
FND., 0.44' W.

STA. 191+67.01 @ S.R.611(COLORADO AVE.)=
STA 30+00.00 @ ROOT ROAD
O.D.O.T R/W PLAN LOR-611-4.38



MON. BOX FND., REBAR
W/ CAP STAMPED
"BRAMHALL"

REBAR FND. W/ CAP
STAMPED "MCGANHON"

1/2" REBAR
FND.

03-00-058-102-012

TERI M. CAMPANA
INST. NO. 20050085775
03-00-058-102-002

03-00-058-102-003


03-00-058-102-013

P.O.B.
3/4" PIPE FND. BENT
SURVEY MARKER SET

3/4" PIPE FND.

1.000 AC.

CITY OF LORAIN
INST. NO. 20040023525
03-00-058-102-017
25.30 AC.

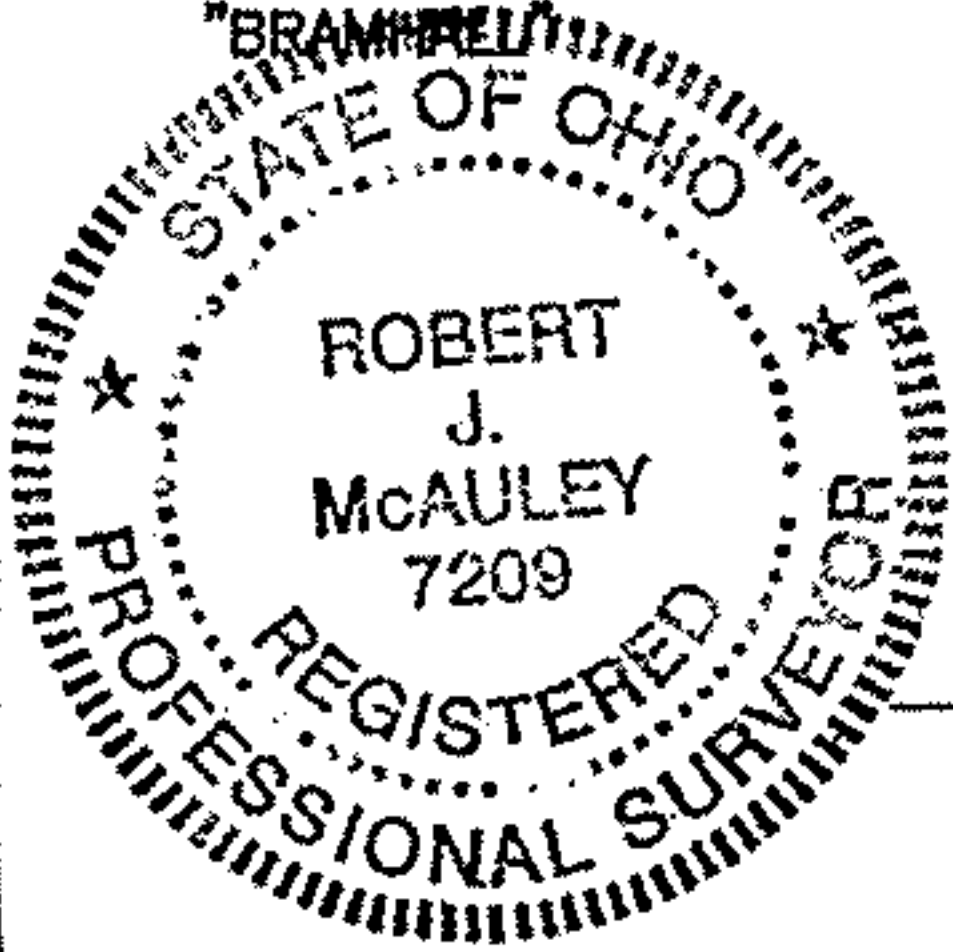

MON. BOX FND., REBAR
W/ CAP STAMPED
"BRAMHALL"

BEARINGS ARE BASED ON THE CENTERLINE OF ROOT
ROAD BEING S 0°00'17" E AS SHOWN ON O.D.O.T.
RIGHT OF WAY PLAN "LOR-611-4.38" AND ARE
INTENDED FOR THE DETERMINATION OF ANGULAR
MEASUREMENT ONLY.

LEGEND

- - 5/8" DIA. x 30" REBAR SET WITH PLASTIC CAP STAMPED "RICHLAND ENG. RLS 7209".
- - MONUMENT BOX FOUND WITH IP
- - SURVEY MARKER FOUND AS NOTED

SURVEY FOR FIRST ENERGY

SITUATED IN THE CITY OF LORAIN, TOWNSHIP OF
SHEFFIELD, COUNTY OF LORAIN, STATE OF OHIO
AND BEING A PART OF ORIGINAL SHEFFIELD
TOWNSHIP LOT NO. 58.

ROBERT J. MCAULEY
RLS 7209

27 April 2006

DATE