


HARTUNG & ASSOCIATES ENGINEERS & SURVEYORS

P.O. BOX 426, 421 WILLIAMS ST., HURON, OH 44839-0426
(419) 433-4321 • FAX (419) 433-7879

DANIEL E. HARTUNG JR., PE, PS

CONTRAIL (ORIG NYCRR) DV 122 PG 492

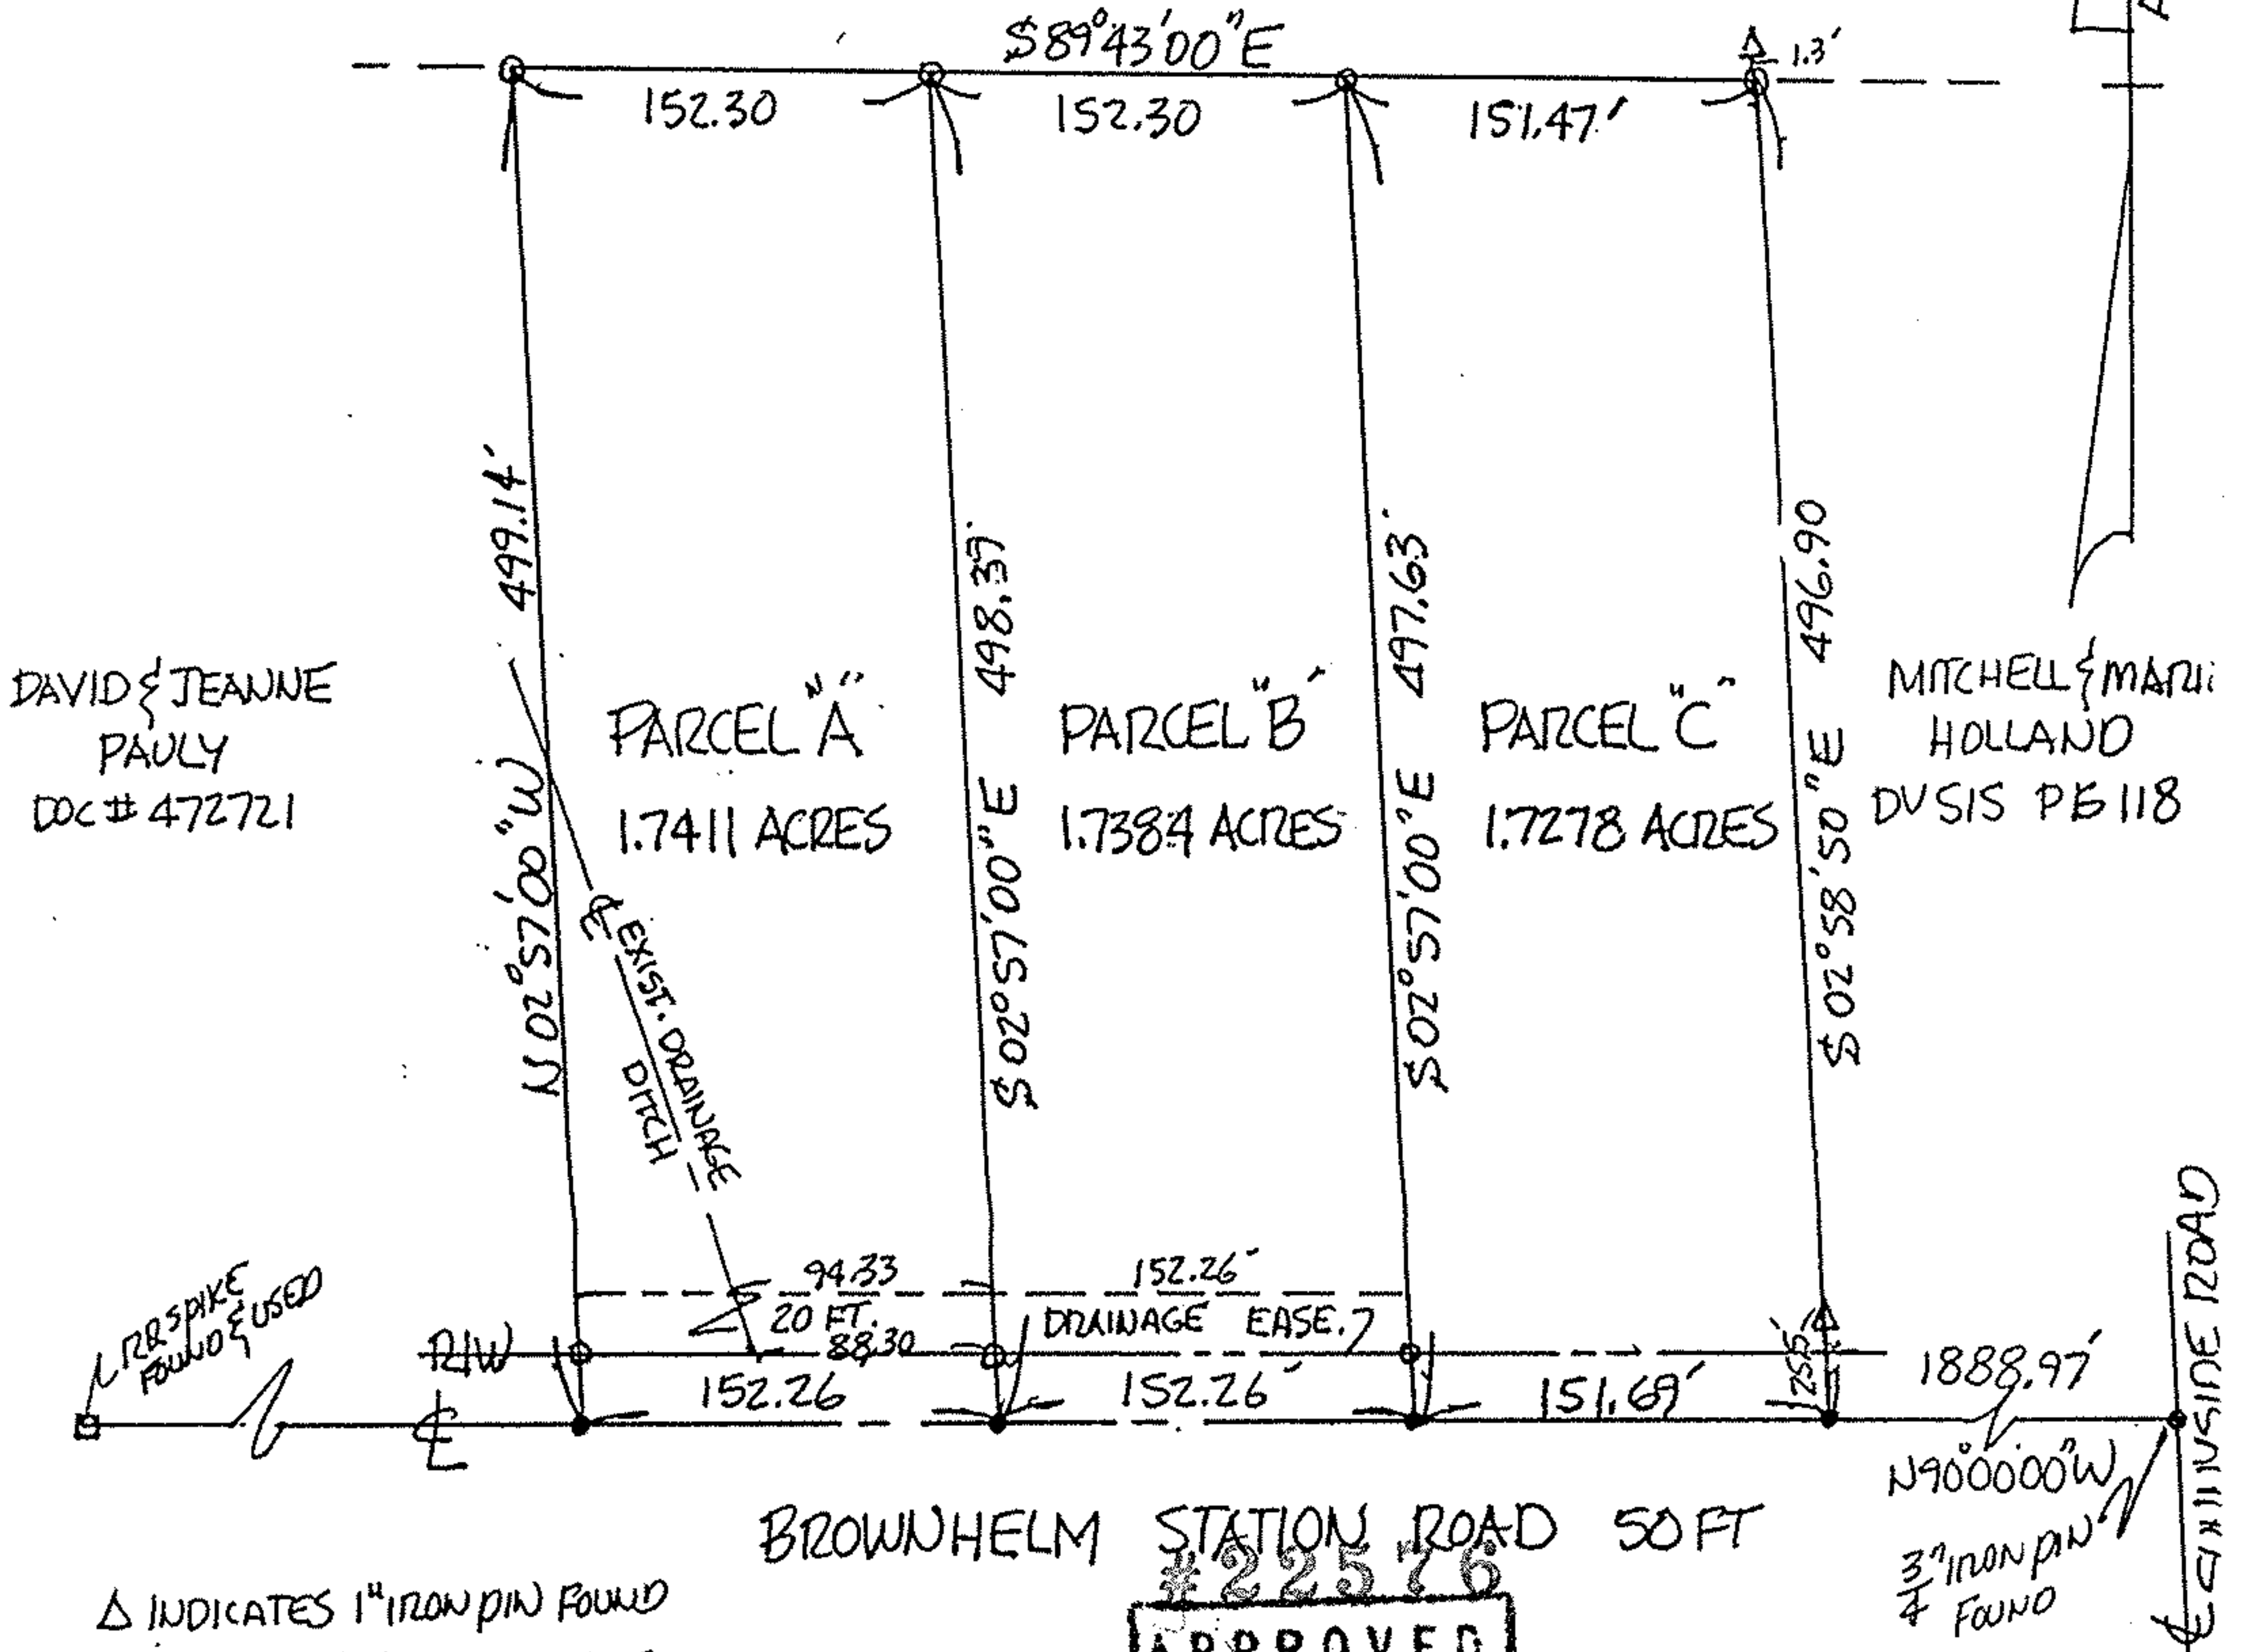

- △ INDICATES 1" IRON PIN FOUND
- INDICATES PK NAIL SET
- INDICATES 1/2" IRON PIN SET


"SURVEY"
FOR
FAWN A. SMITH

APPROVED	
LORAIN CO. MAP DEPT.	
DATE	7/6/98
PAGE	1-B
BY	TJS
VOID AFTER	22576



PART ORIG. LOT 13
CITY OF VERMILION
JANUARY 1998

BROWNHELM TWP.
LORAIN COUNTY, OHIO
SCALE 1"=100'

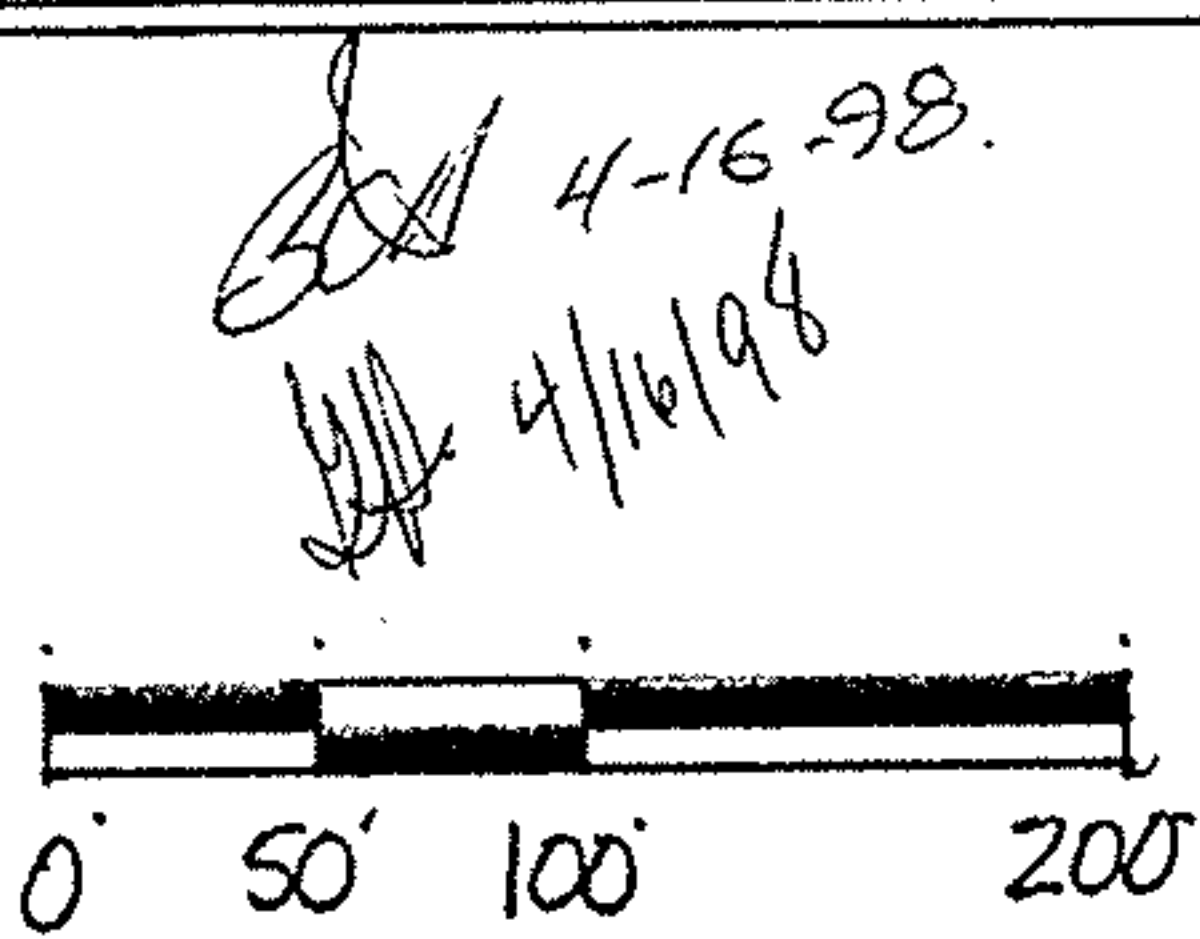

I HEREBY CERTIFY THE WITHIN TO BE A TRUE REPRESENTATION OF A SURVEY MADE BY ME.

Daniel E. Hartung Jr.
DANIEL E. HARTUNG JR., PE, PS