


NOTES: ● indicates iron pin set
○ indicates iron pin found unless designated as pipe.

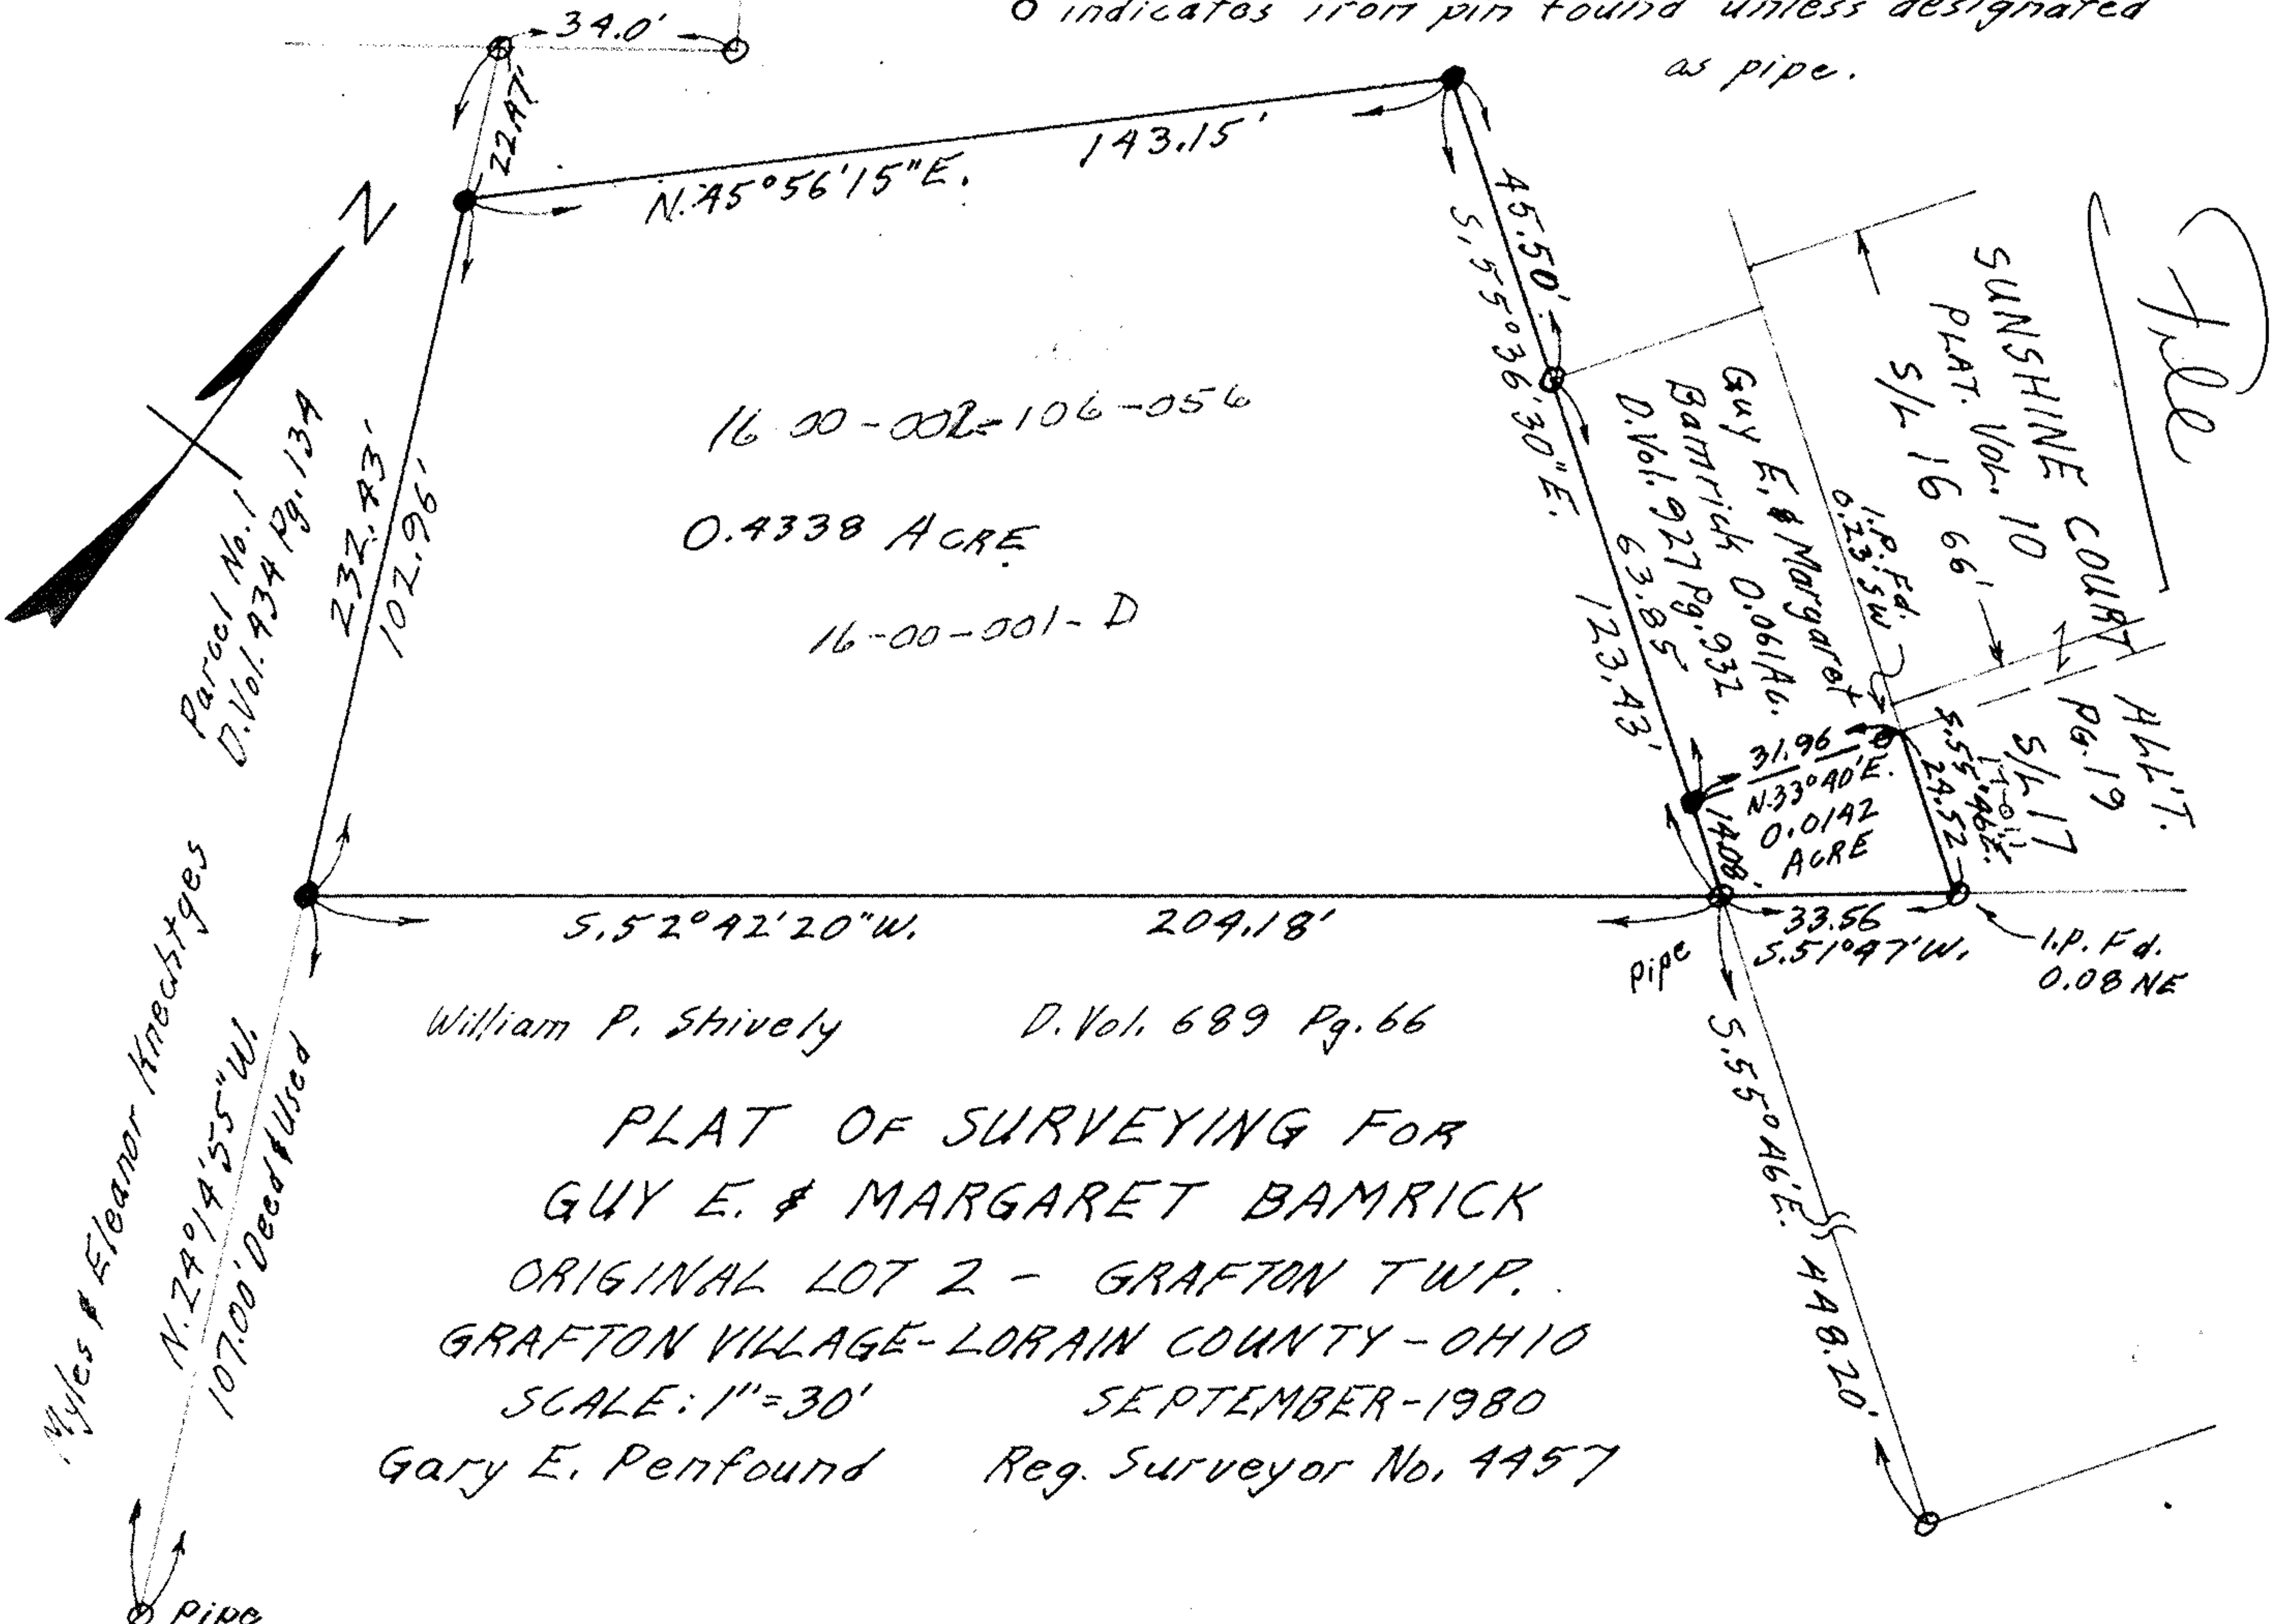

16-00-002-106-056

0.4338 ACRE

16-00-001-D

209.18' S. 52° 42' 20" W.

William P. Shively D. Vol. 689 Pg. 66

PLAT OF SURVEYING FOR
GUY E. & MARGARET BARRICK
ORIGINAL LOT 2 - GRAFTON TWP.
GRAFTON VILLAGE - LORAIN COUNTY - OHIO
SCALE: 1" = 30'
SEPTEMBER - 1980

Gary E. Penfound Reg. Surveyor No. 4457

file

Myles & Eleanor Knechtges
Parcel No. 1
D. Vol. 934 Pg. 134
N. 24° 19' 55" W.
107.00' Deed Used

Pipe

Pipe

I.P. Fd. 0.08 NE

SUNSHINE COURT
PLAT. Vol. 10
S/L 16 66'

PLAT. Vol. 17
S/L 17 17'

Guy E. & Margaret
Barrick D. 0.061 A.C.
D. Vol. 927 Pg. 932
63.85' 123.43'

I.P. Fd. 0.23 SW
I.P. Fd. 0.0142 ACRE
N. 33° 40' E.
31.96'

33.56' S. 51° 47' W.

S. 55° 04' 46" E. 448.20'

232.83' 102.96'

22.87' 34.0' N. 45° 56' 15" E. 143.15'

45.50' S. 55° 03' 36" E.