


7370

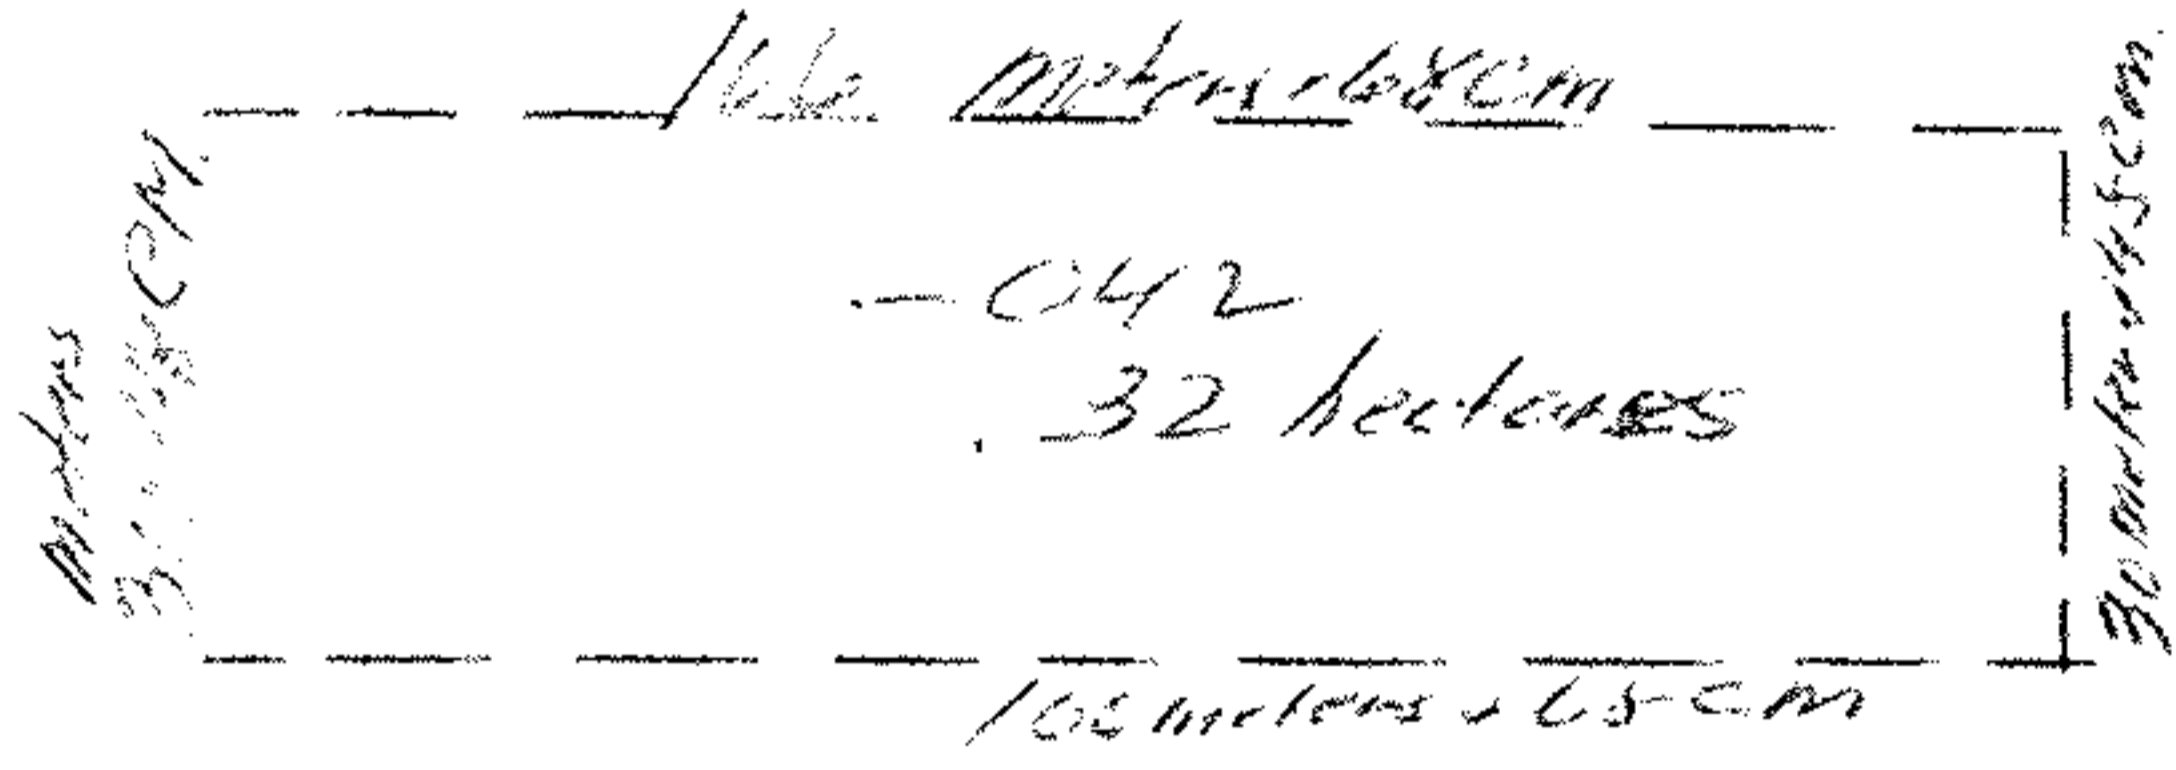

7370

APPROVED LORAIN CO. MAP DEPT.	
DATE	9-17-73
PAGE	11-00-028-1B
BY	L. W. Hill
VOID AFTER	

101
102


043
~~044~~
17.04 hectares

island.

100
103
100A

100

100

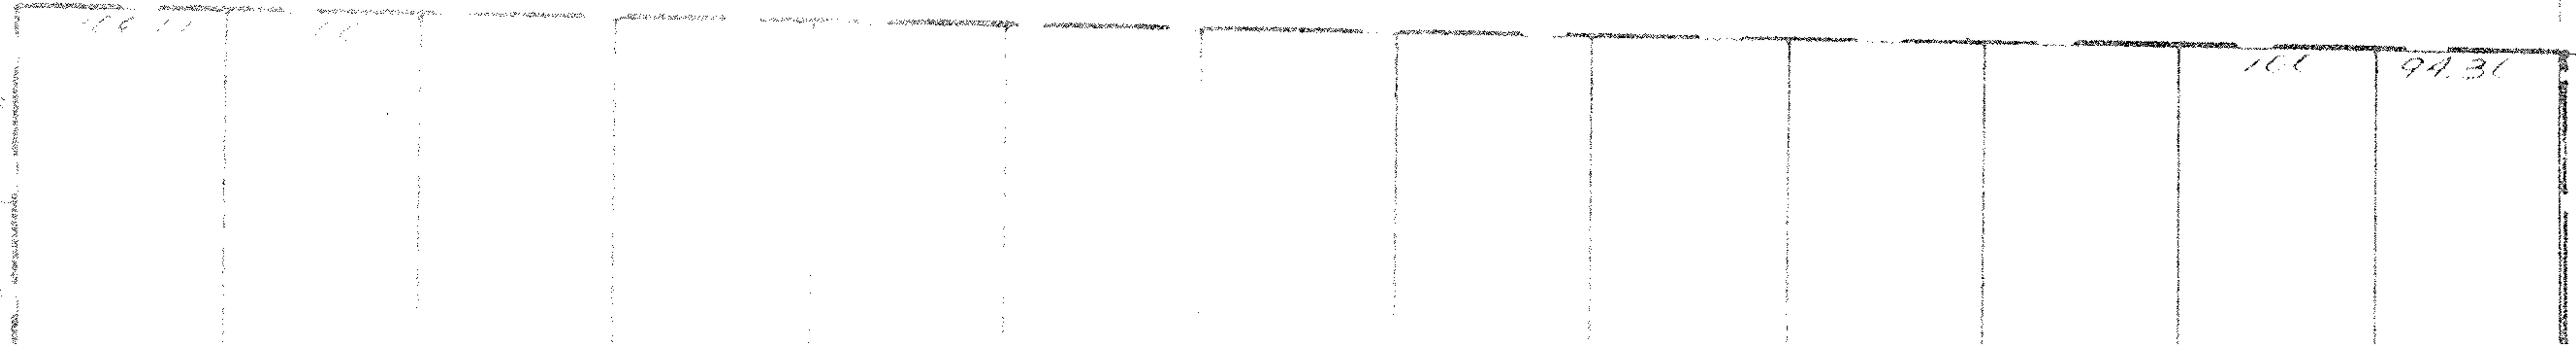

CHANGE ACCREGE + NUMBER ON 11-00-028-1B