

14-00-159-000-004,002

Plat of Survey
for

Pittsfield Land & Cattle Co. LLC.

Pittsfield Twp
Lorain Co.



O.L. 159
Ohio

Carlson Surveys
July 28, 2005

1" pipe
0.16'S
30.61'c/l

IPS= Iron Pin Set


-002
Edward C. Pilan &
Carol J. Pilan,
Co-Trustees
Doc. 02-0836881

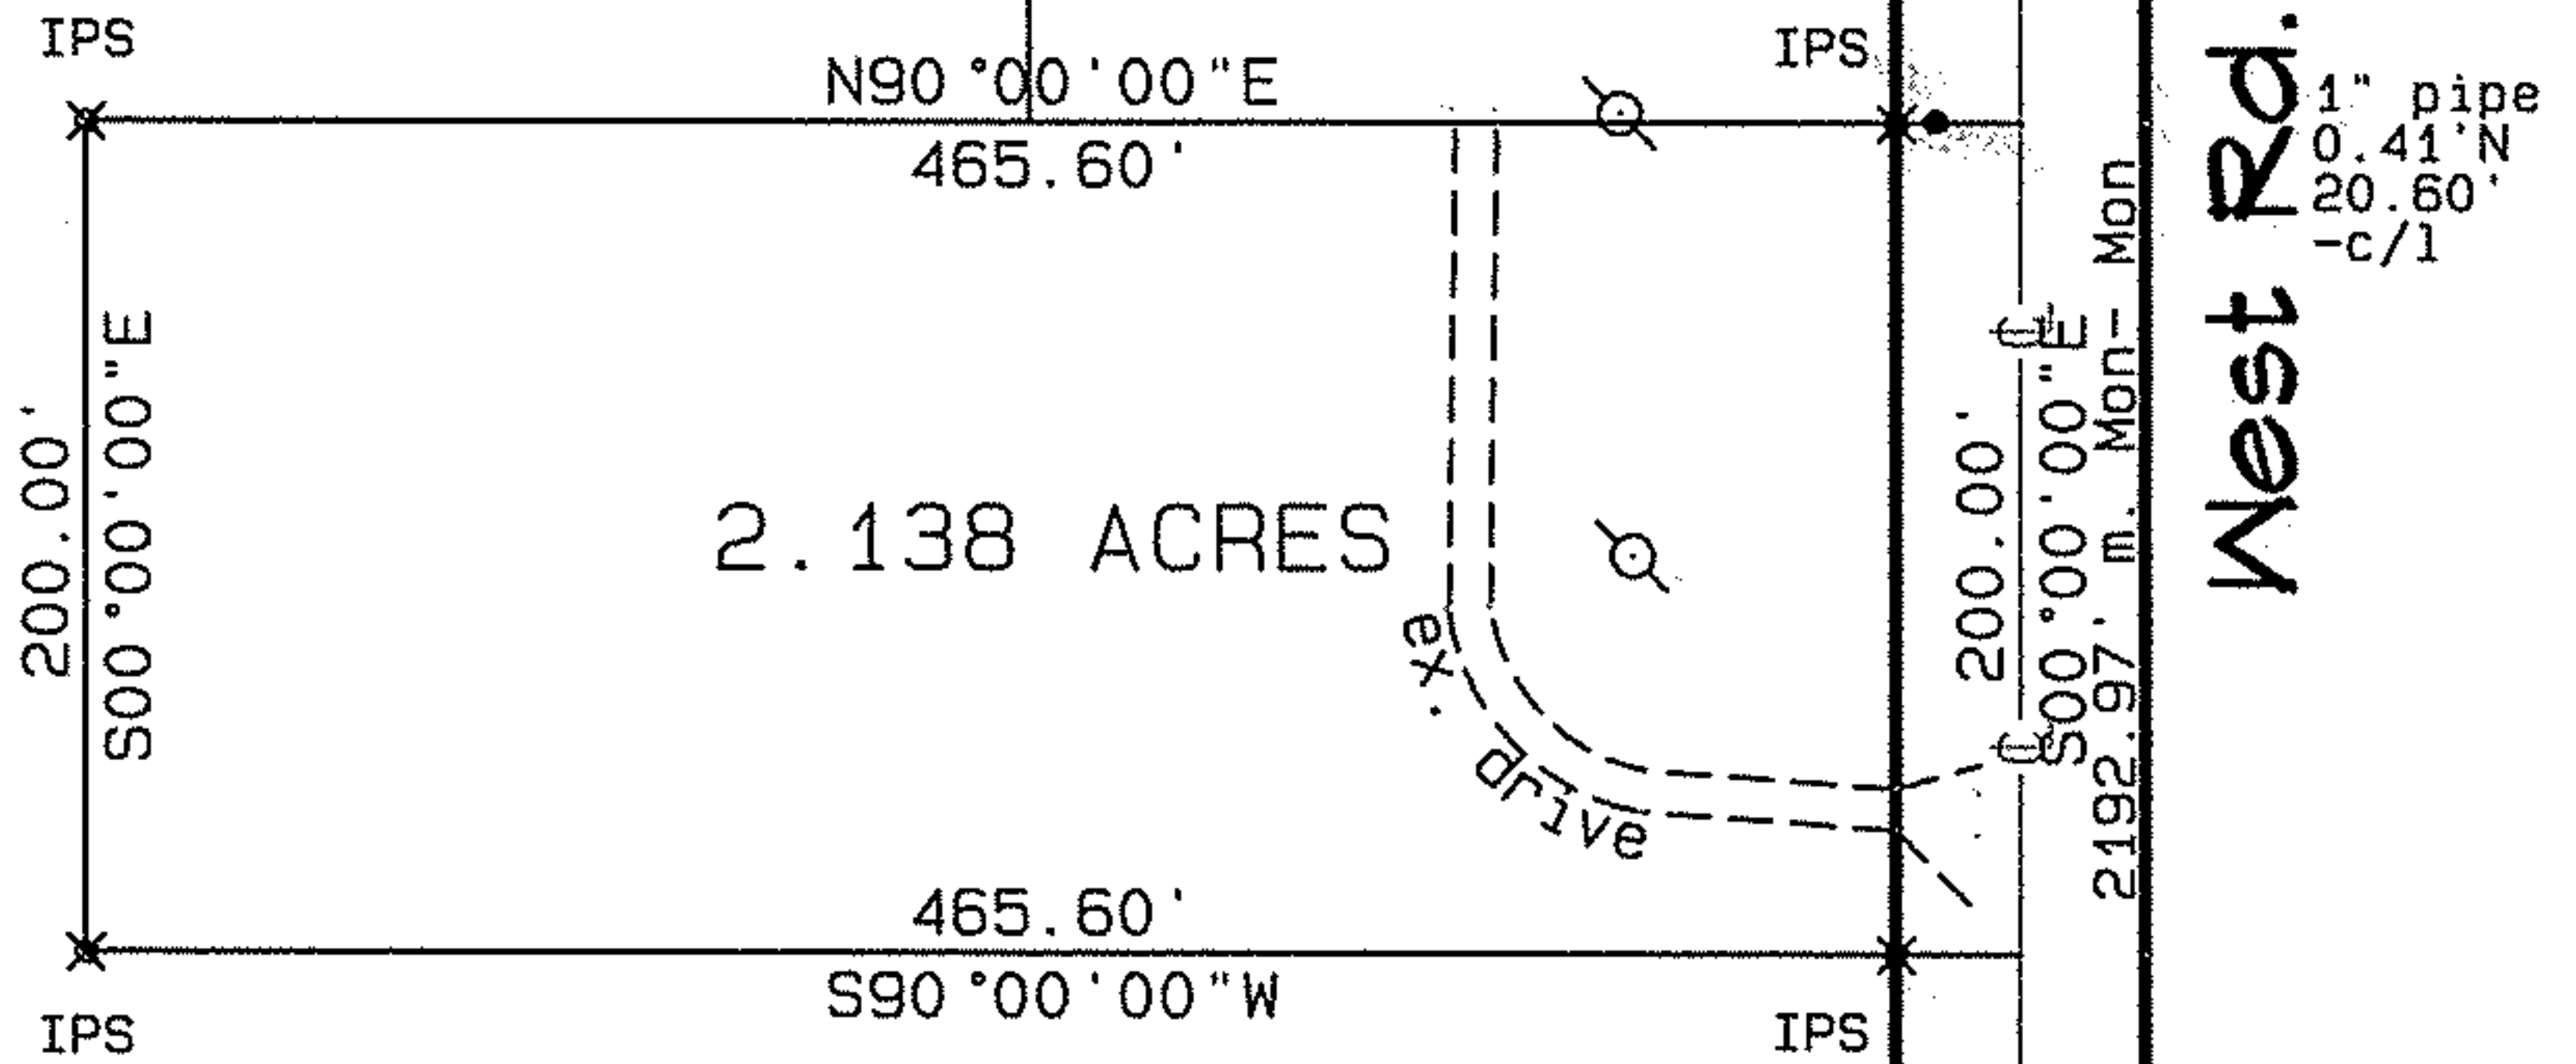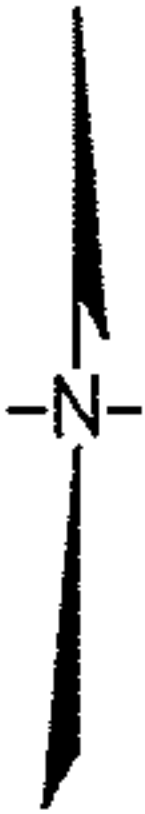

West Rd. 60'

1" pipe
0.41'N
20.60'
-c/l

Rem. -003
Pittsfield Land & Cattle Co. LLC.
130.86 Ac. By Auditor

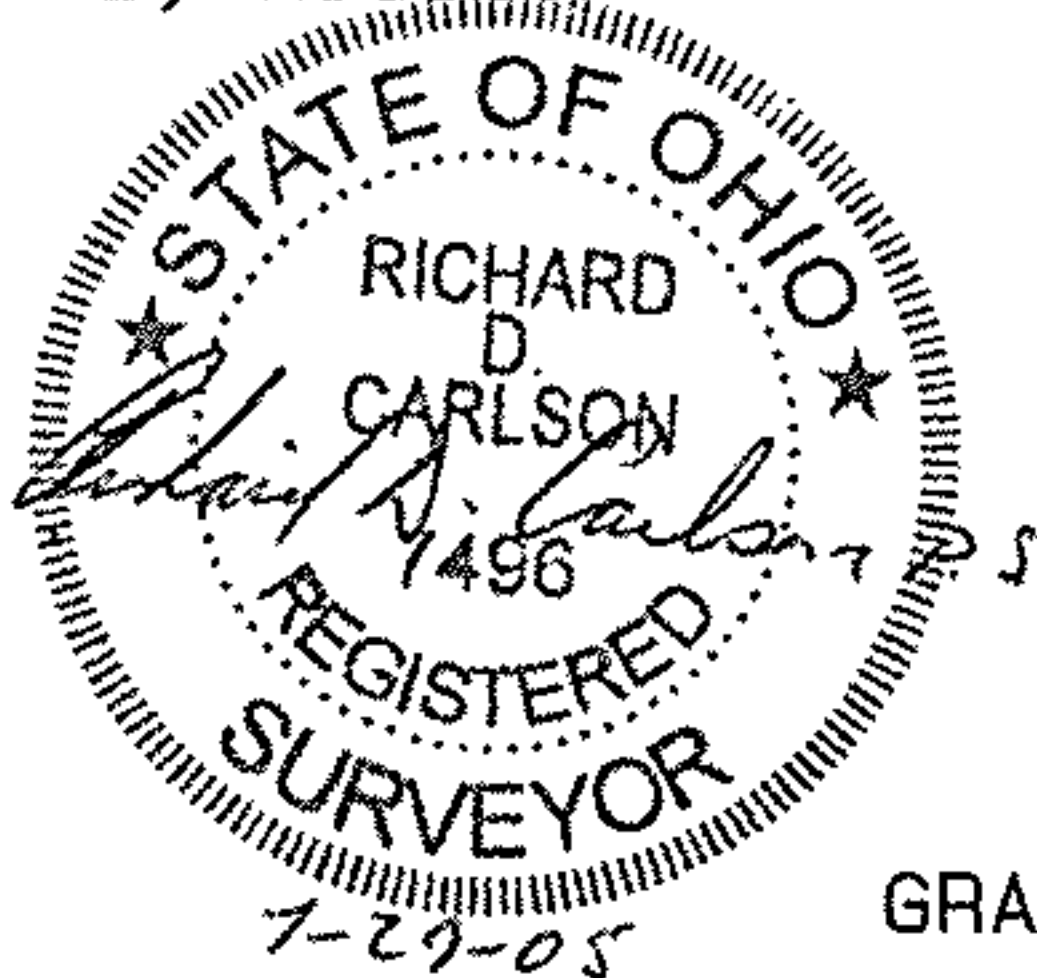

No 02234
10-10-06
14H
J Hatfield
Webster Rd. 60'
06-02234
1"=100'

GRAPHIC SCALE 1"=100'



0 100 200 300