


HOLLYWOOD AVE 50'

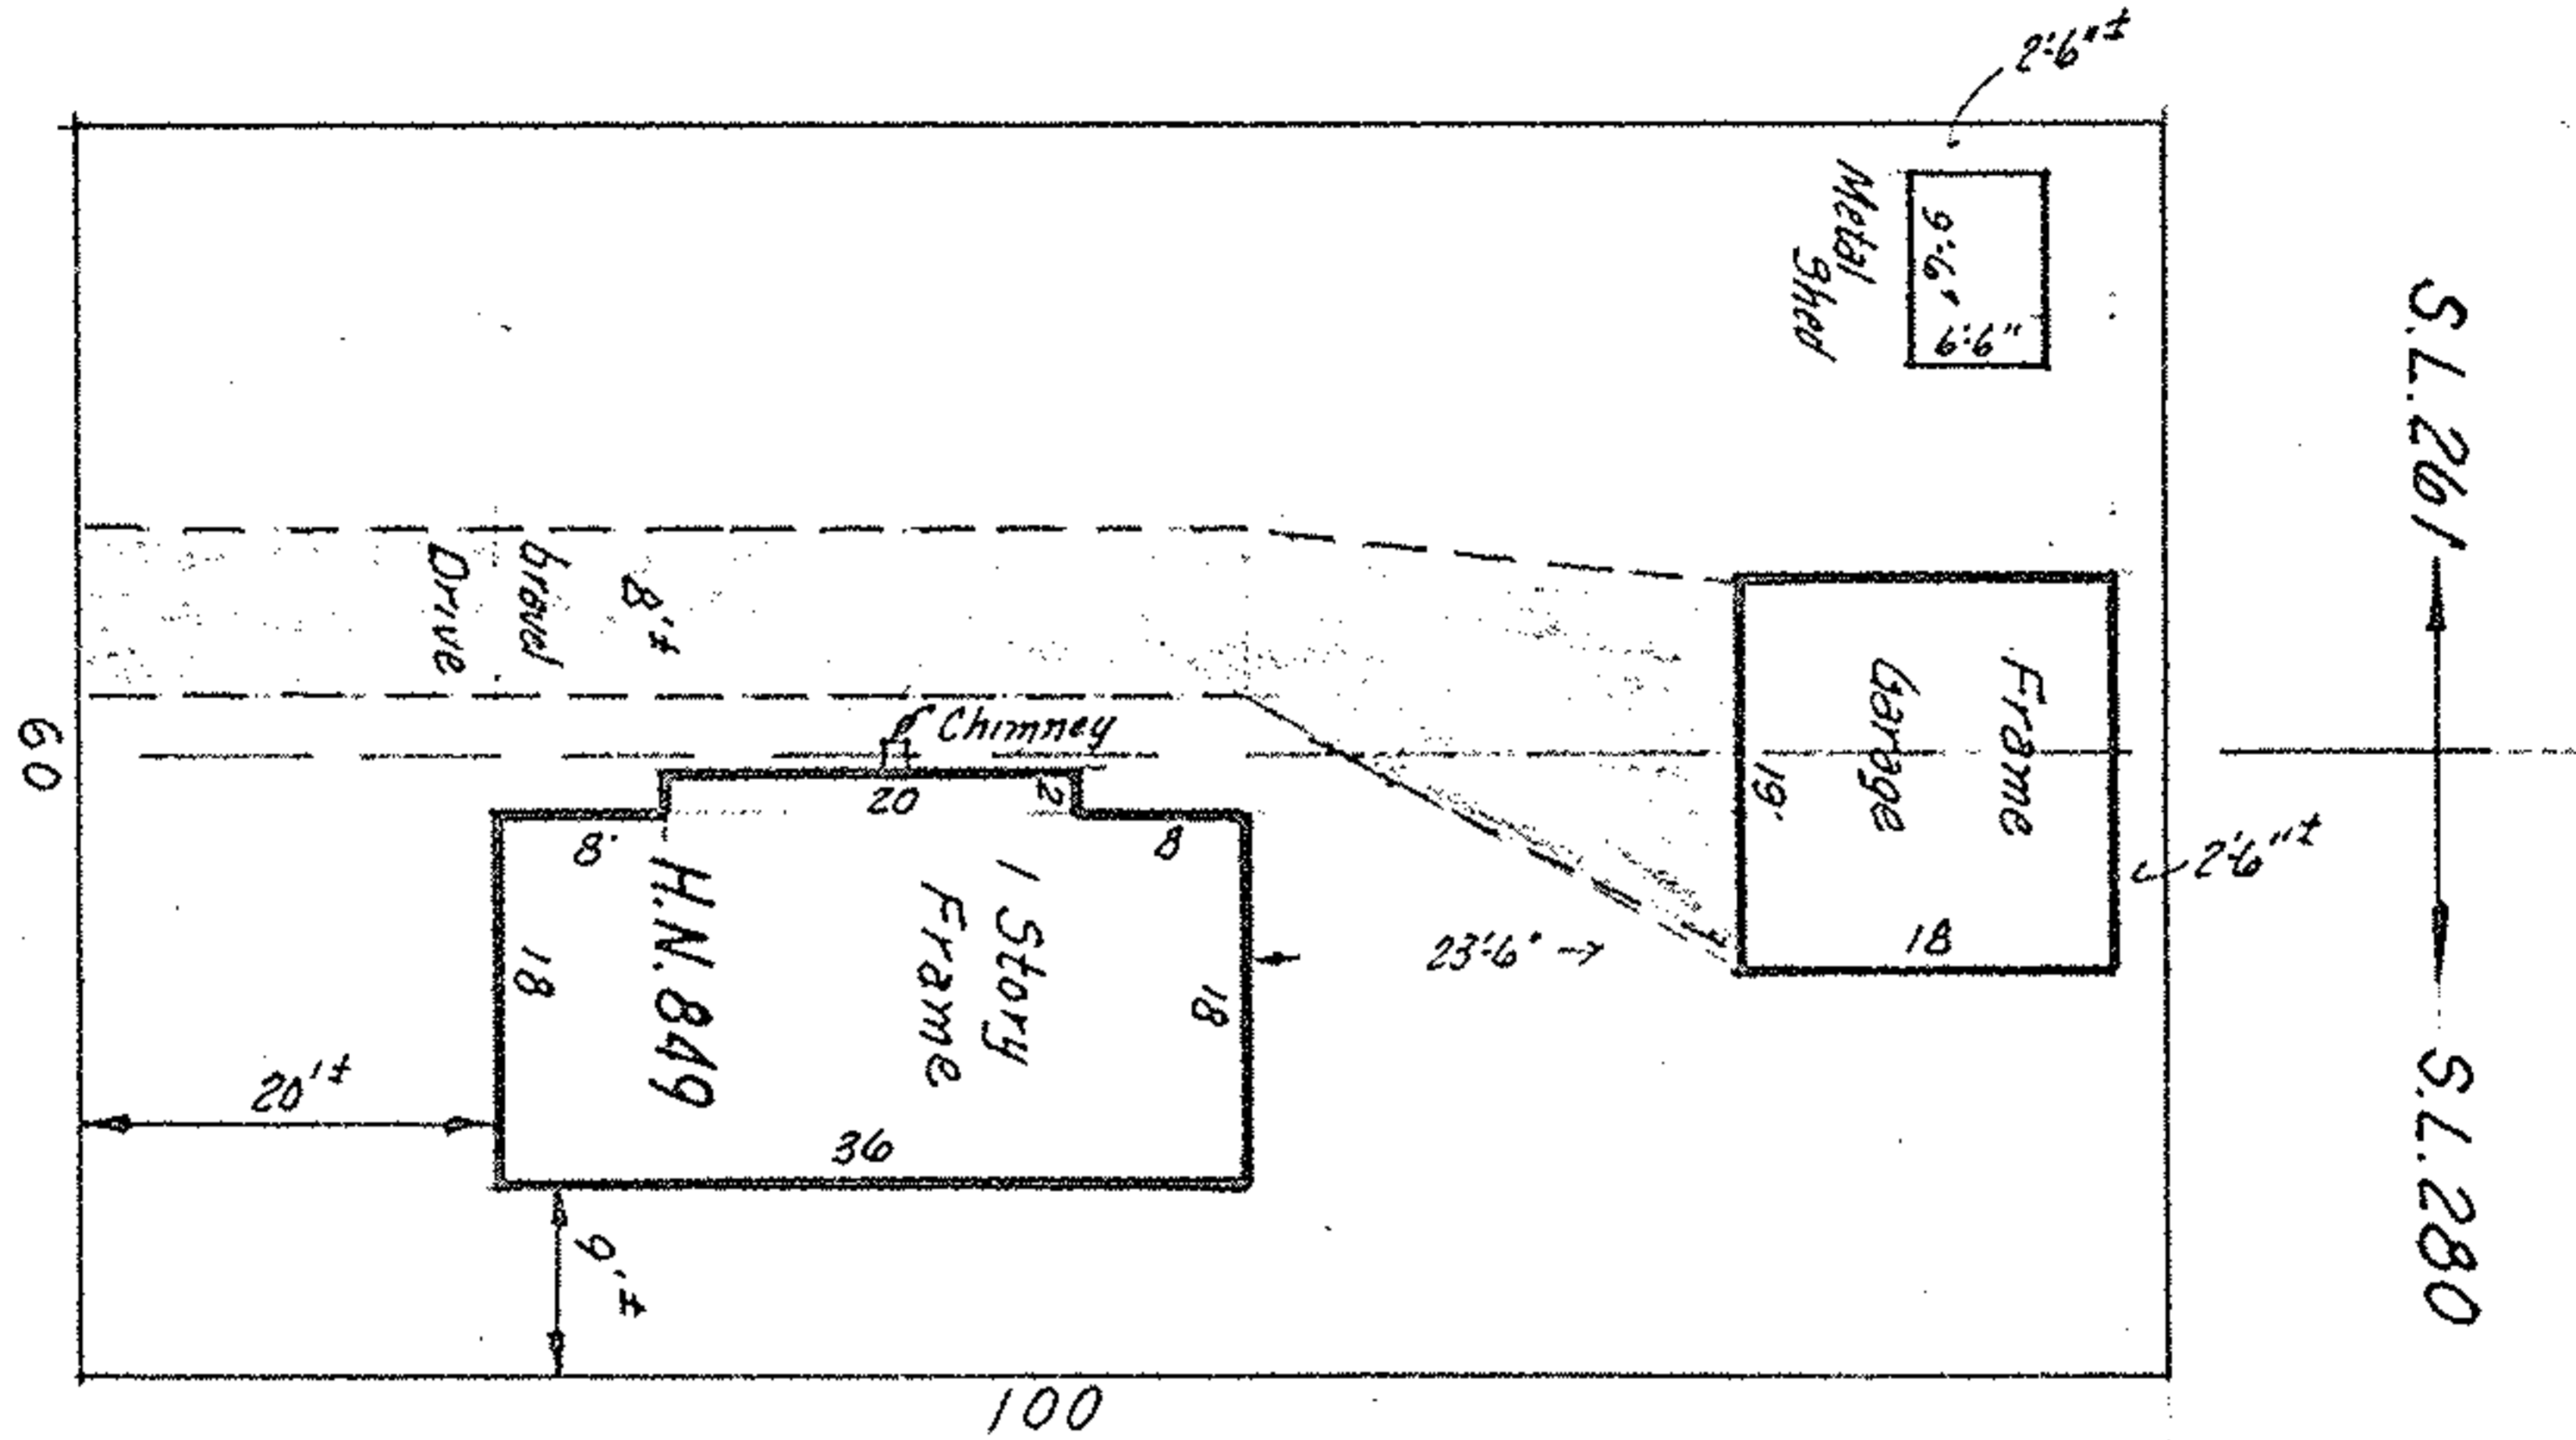

VERIFY LOC'S. OF SIDES.

SUBLOTS #261 & 280 of BLOCK 'D' of CLEVELAND BEACH SUB'D

PLAT VOL. 9 PAGE 30
PART of ORIG. SHEFFIELD TWP. LOT 39
NOW in CITY of SHEFFIELD LAKE, OHIO

Mc GLINCHY & ASSOCIATE
DEC. 13, 1977 #772852

ST 1-A242