


01-00-018-128-008

04-00-018-0010

2019 25 1967

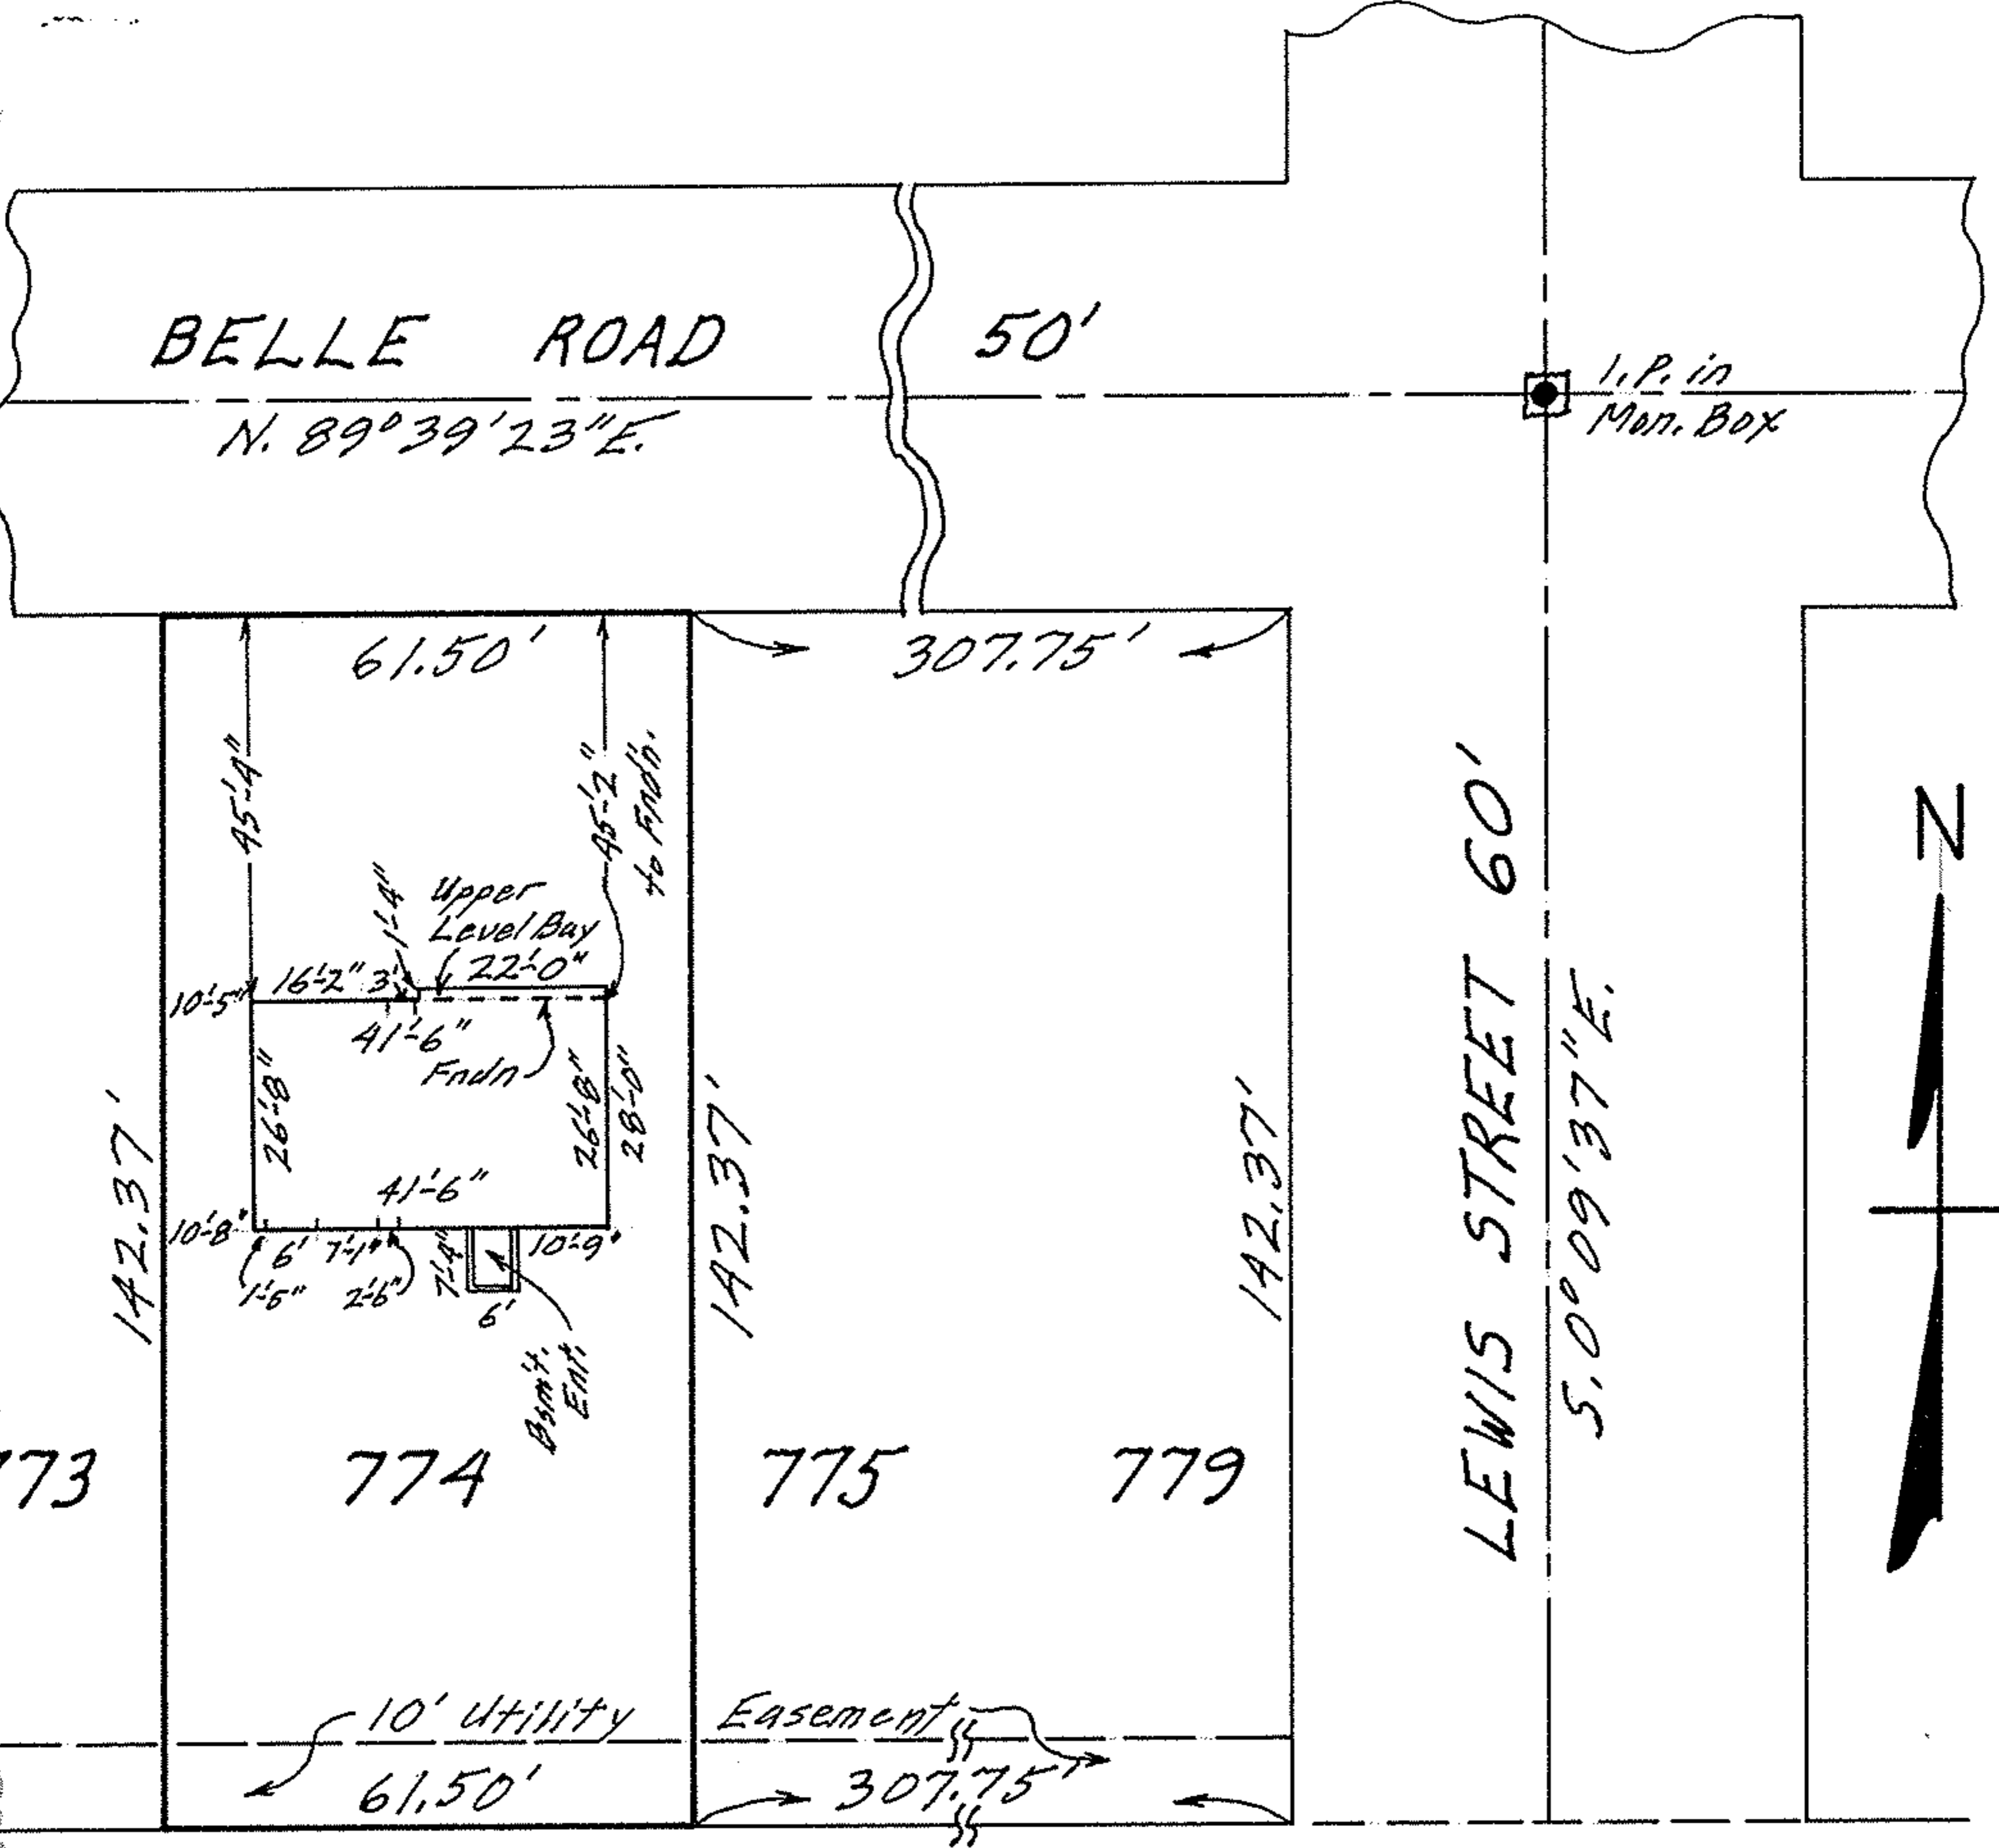

MAP OF SUB-LOT NO. 774 OF RESUBDIVISION OF PART  
 OF BELDEN PARK SUB'N. NO. 2 VOL. 18 PG. 24 PLATS  
 SECTION 18 AVON TWP. - AVON LAKE CITY  
 LORAIN COUNTY OHIO  
 SCALE: 1" = 30' JAN. 28-1967 4:30 P.M.

R. Gary E. Penfound REG. SURVEYORS  
 for G. E. Penfound

E-14954 Kopf Construction Corp.