


E-13127 Snider Building Corp.

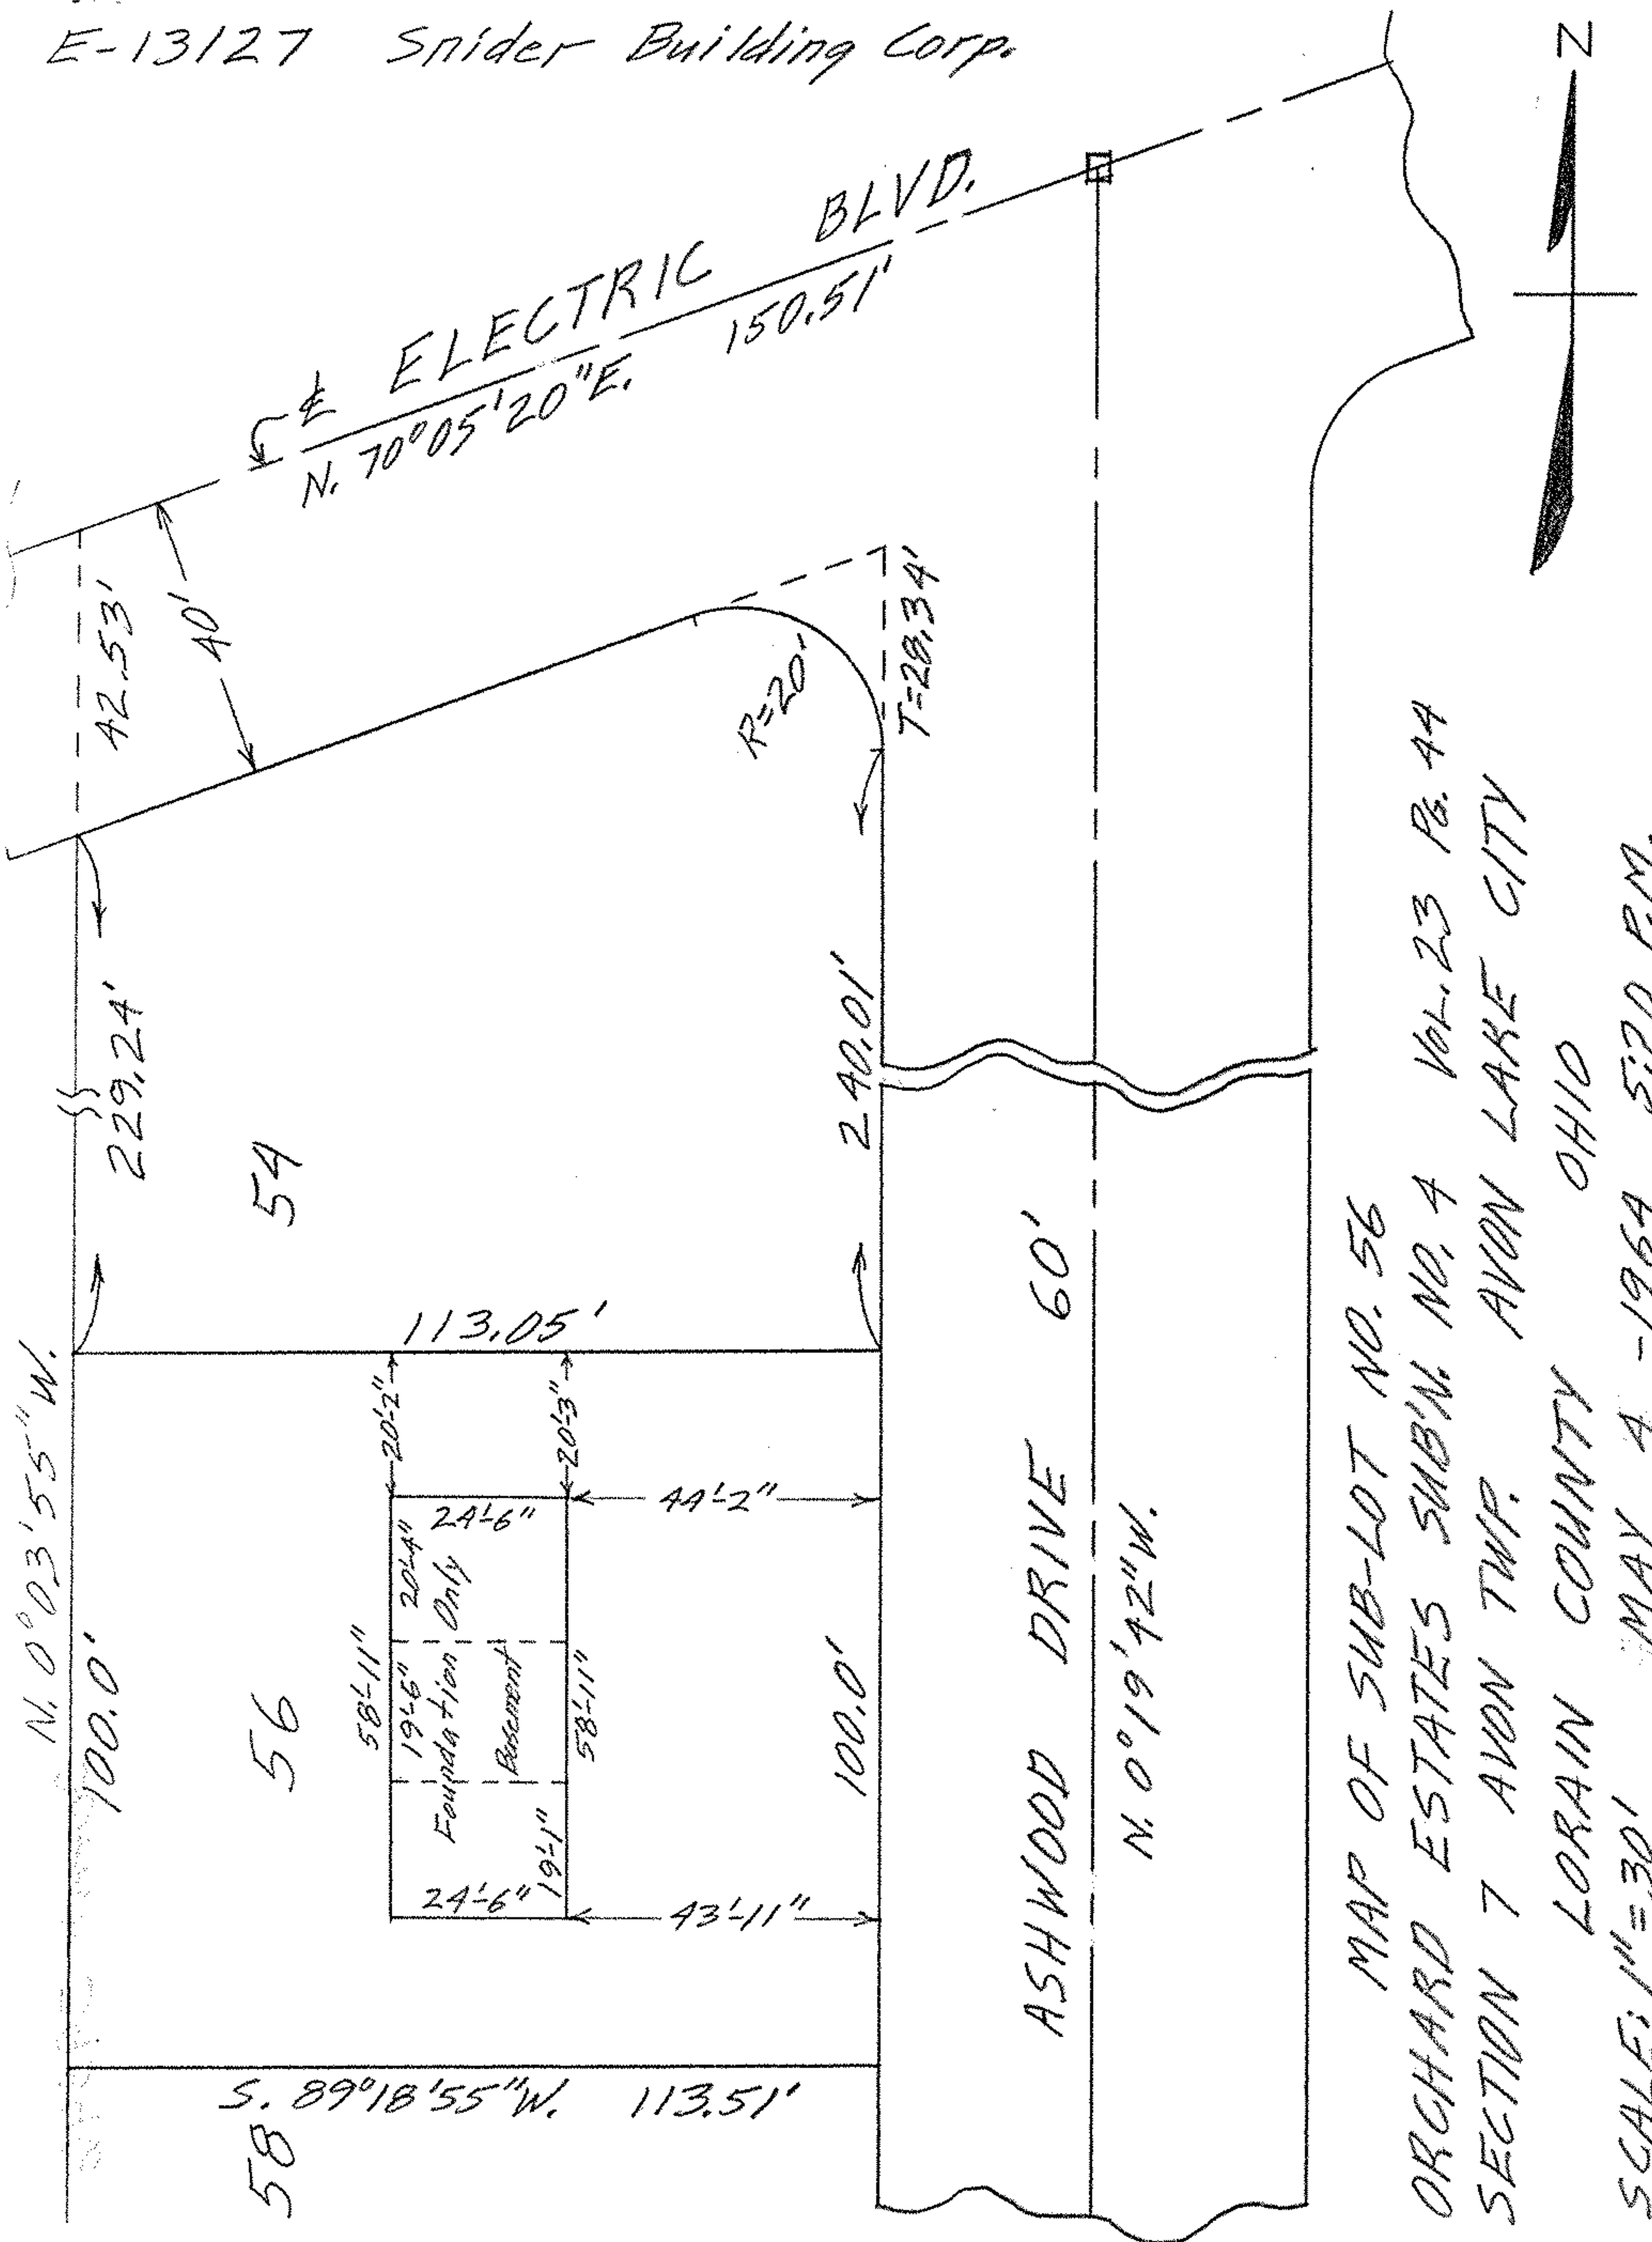

MAP OF SUB-LOT NO. 56
 ORCHARD ESTATES SUB'D. NO. 4 VOL. 23 PG. 44
 SECTION 7 AVON TWP. AVON LAKE CITY
 LORAIN COUNTY OHIO
 SCALE: 1"=30' MAY 4 - 1964 5:20 P.M.
 Gary E. Penfound for C.E. Penfound REG. SURVEYORS