


05-05-000-102-018 810-201-000-50 05-05-000-50 02-02-01

MAP OF SUB-LOT NO. 151  
CARR ESTATES SUBN. NO. 3 Vol. 23 Pg. 75  
ORIG. LOT 6 - TRACT 2 - BLACK RIVER TWP.  
LORAIN CITY - LORAIN COUNTY - OHIO  
SCALE: 1" = 30' JUNE 5-1968 10:30 A.M.  
Gary E. Penfound REG. SURVEYOR

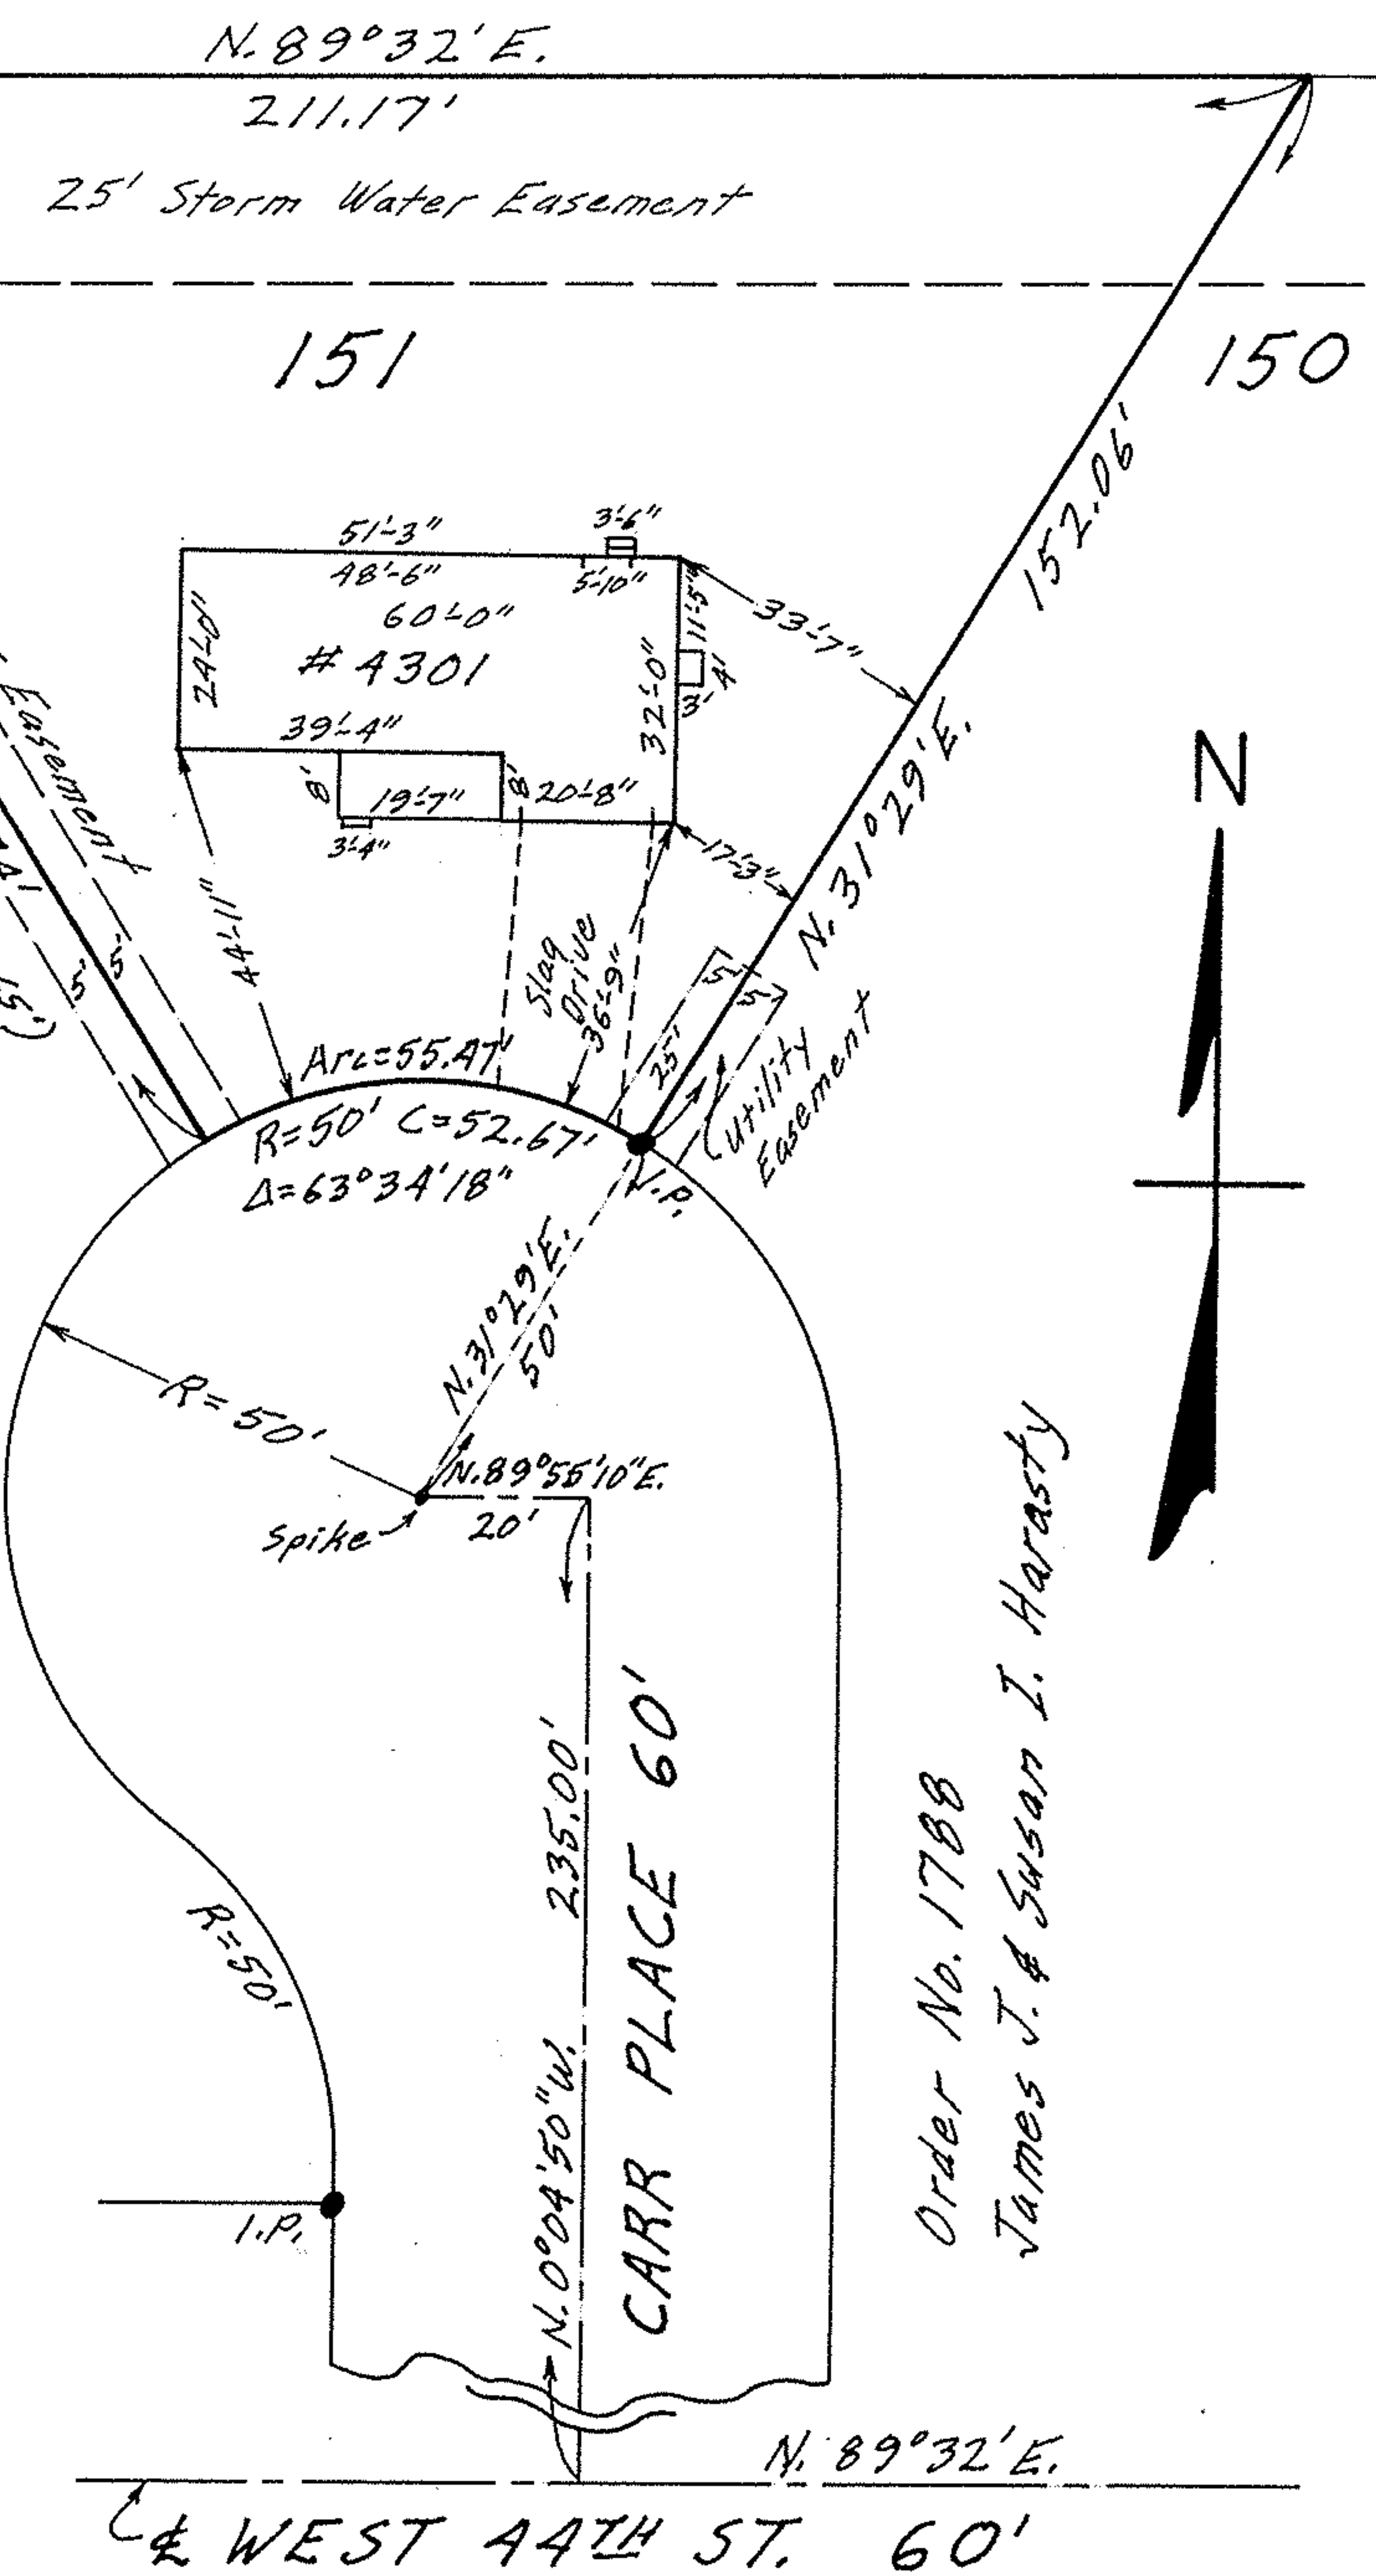

Order No. 1788  
James J. & Susan I. Harasty