

**Ashland Kipton Rd.  
(S.R. 511)**

**Bronson Rd.**

#02364

APPROVED  
LORAIN CO.  
MAP DEPT

*Carlson Surveys*

March 2007  
Job: 1301-10R

DATE 4-30-07

13-09-032000-001

PAGE 13-G

BY JHAF

Tr. 9 O.L. 23 #07 02364

882.22' m.  
877.8' d. N89°45'57" E 1999.56'

Tr. 9 O.L. 32

24.956 ACRES

1950.28' m.  
1952.28' d.

N02°27'10"E

Iron Pin Set  
30.03' - C/L

Iron Pin Set  
30.04' - C/L

16.4'

Iron Pin Set  
30.09' - C/L

S89°32'11"W 2018.12'

Iron Pin Set  
1550.08' - C/L

Iron Pin Set  
1550.08' - C/L

537.19'

579.01'

Tr. 9 O.L. 31


Rem. -001  
43.37 Ac.

Plat of Survey  
for

**Robert & Delores Jackson**

Camden Twp.  
Lorain Co.

Tr. 9 O.L. 32  
Ohio

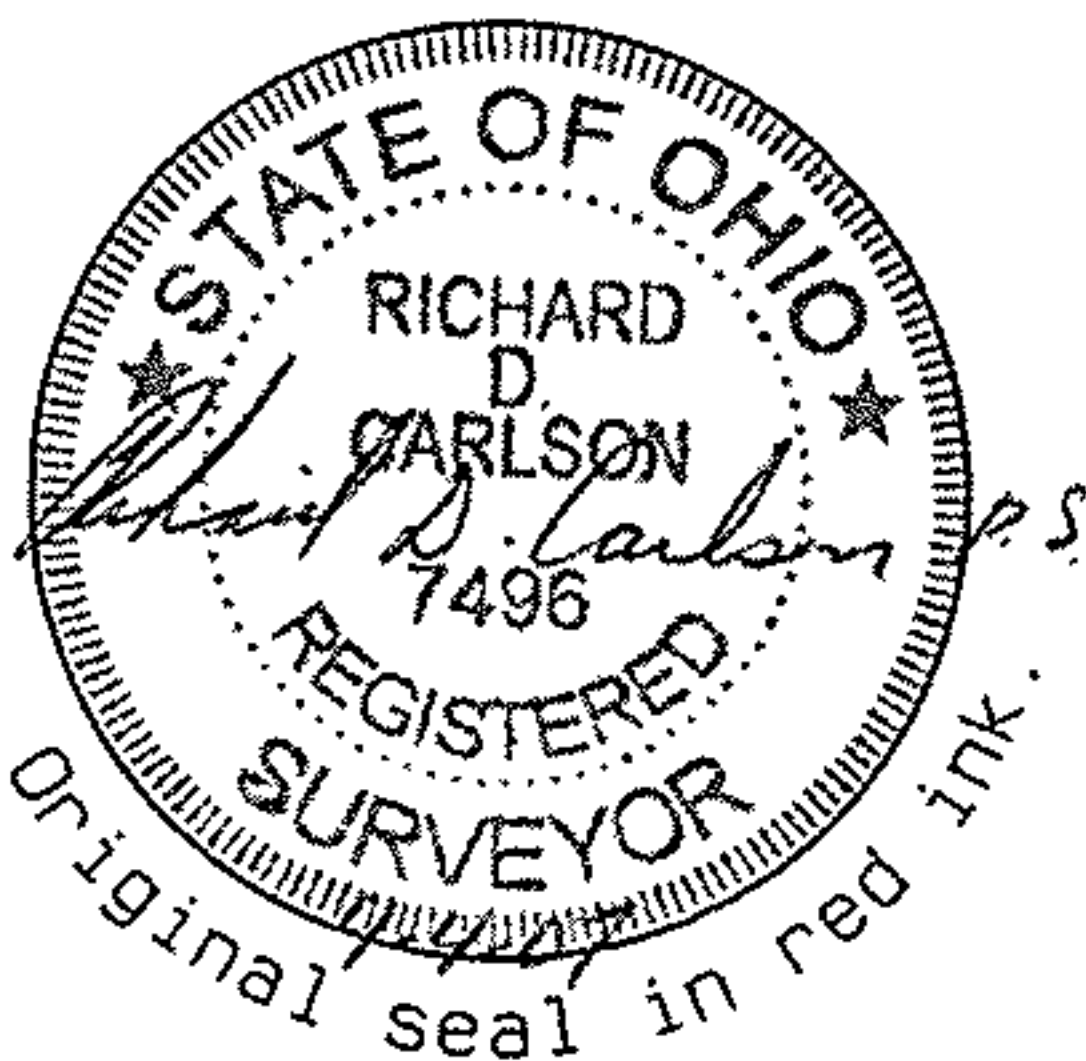

Original seal in red ink.

GRAPHIC SCALE 1"=300'



0 300 600 900

An iron pin set is a 5/8"x30" re-bar with cap stamped Carlson.

