


200P#3600e
2004#1400

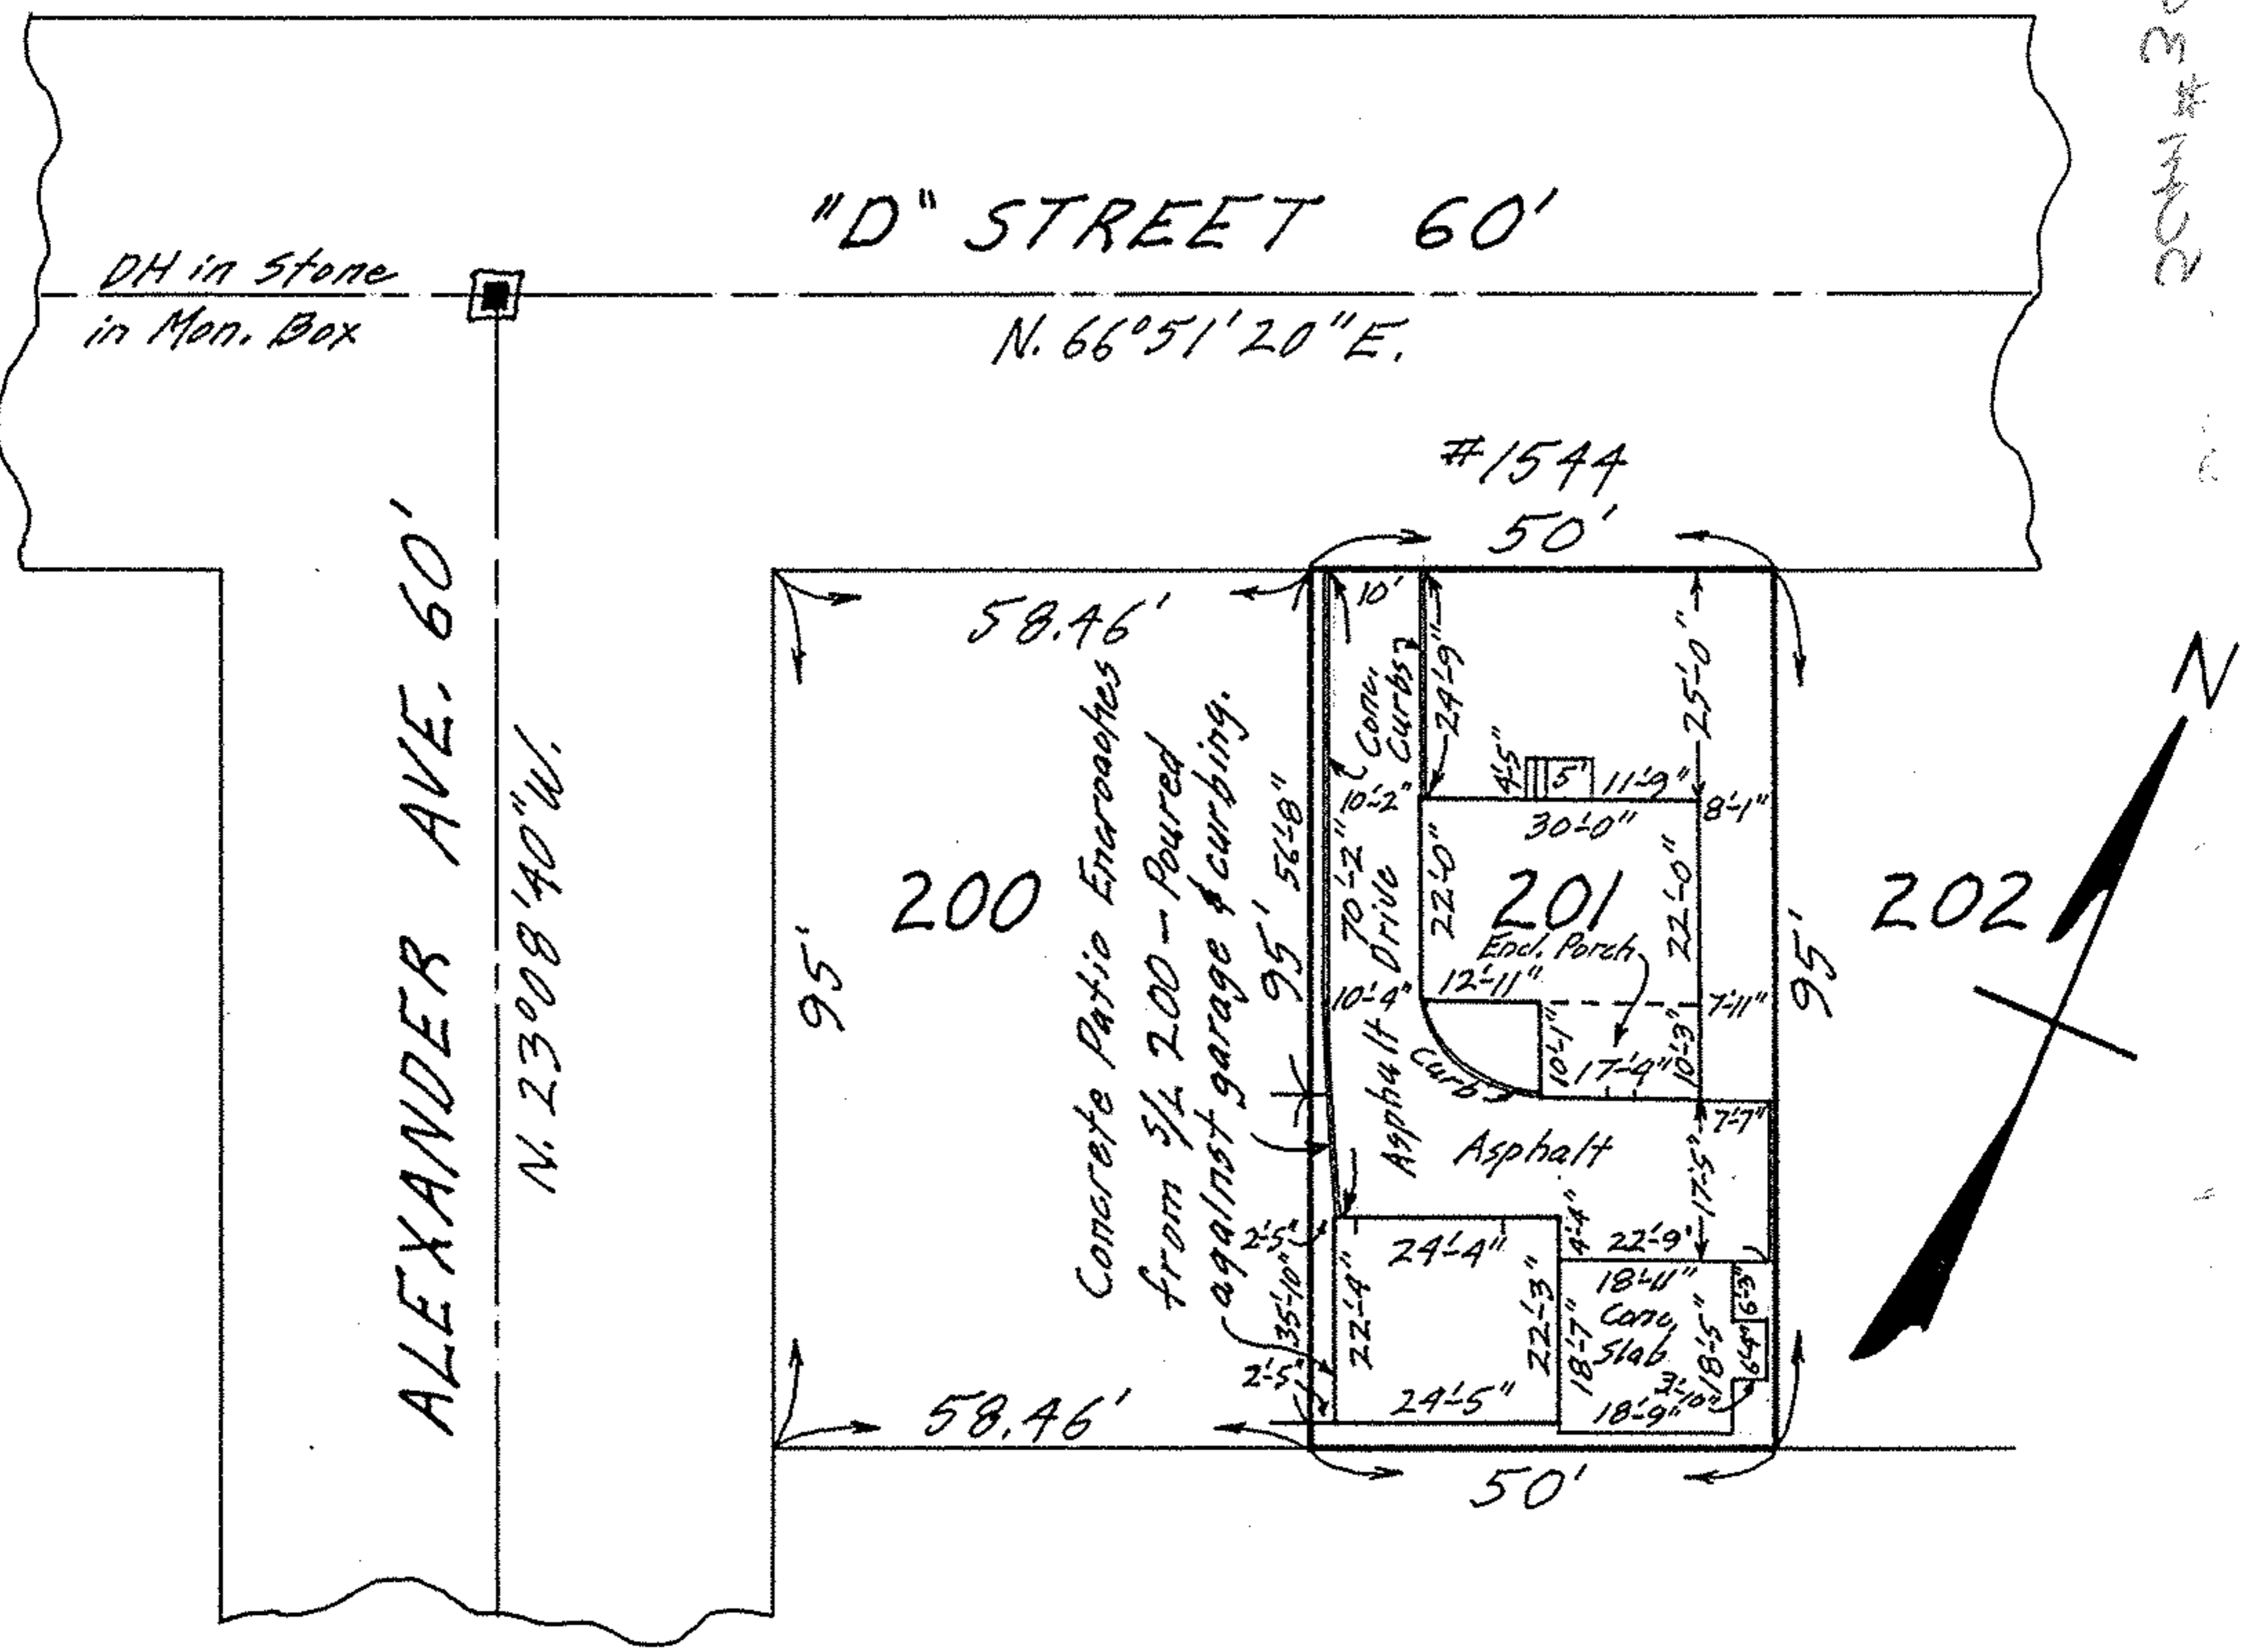

MAP OF SUB-LOT NO. 201

THE FEDERAL HOME BUILDING CO.'S SUB'N. VOL. 9 Pg. 25

ORIG. LOT 51 BLACK RIVER TWP.

LORAIN CITY - LORAIN COUNTY - OHIO

SCALE: 1"=30' APRIL 8-1970 6:00 P.M.

NOTE: The only encroachment on this property is Concrete Patio poured against garage and curbing as shown.

Gary E. Penfound REG. SURVEYOR NO. 4457

CITY TITLE Co. Order No. E-1085-6

Leroy & Betty Lou Cowey to Walter G., Jr. & Mary H. Strock