


02-01-003-150.093

02-01-003-E

Map 1967 of Sublot 4 of Block 20

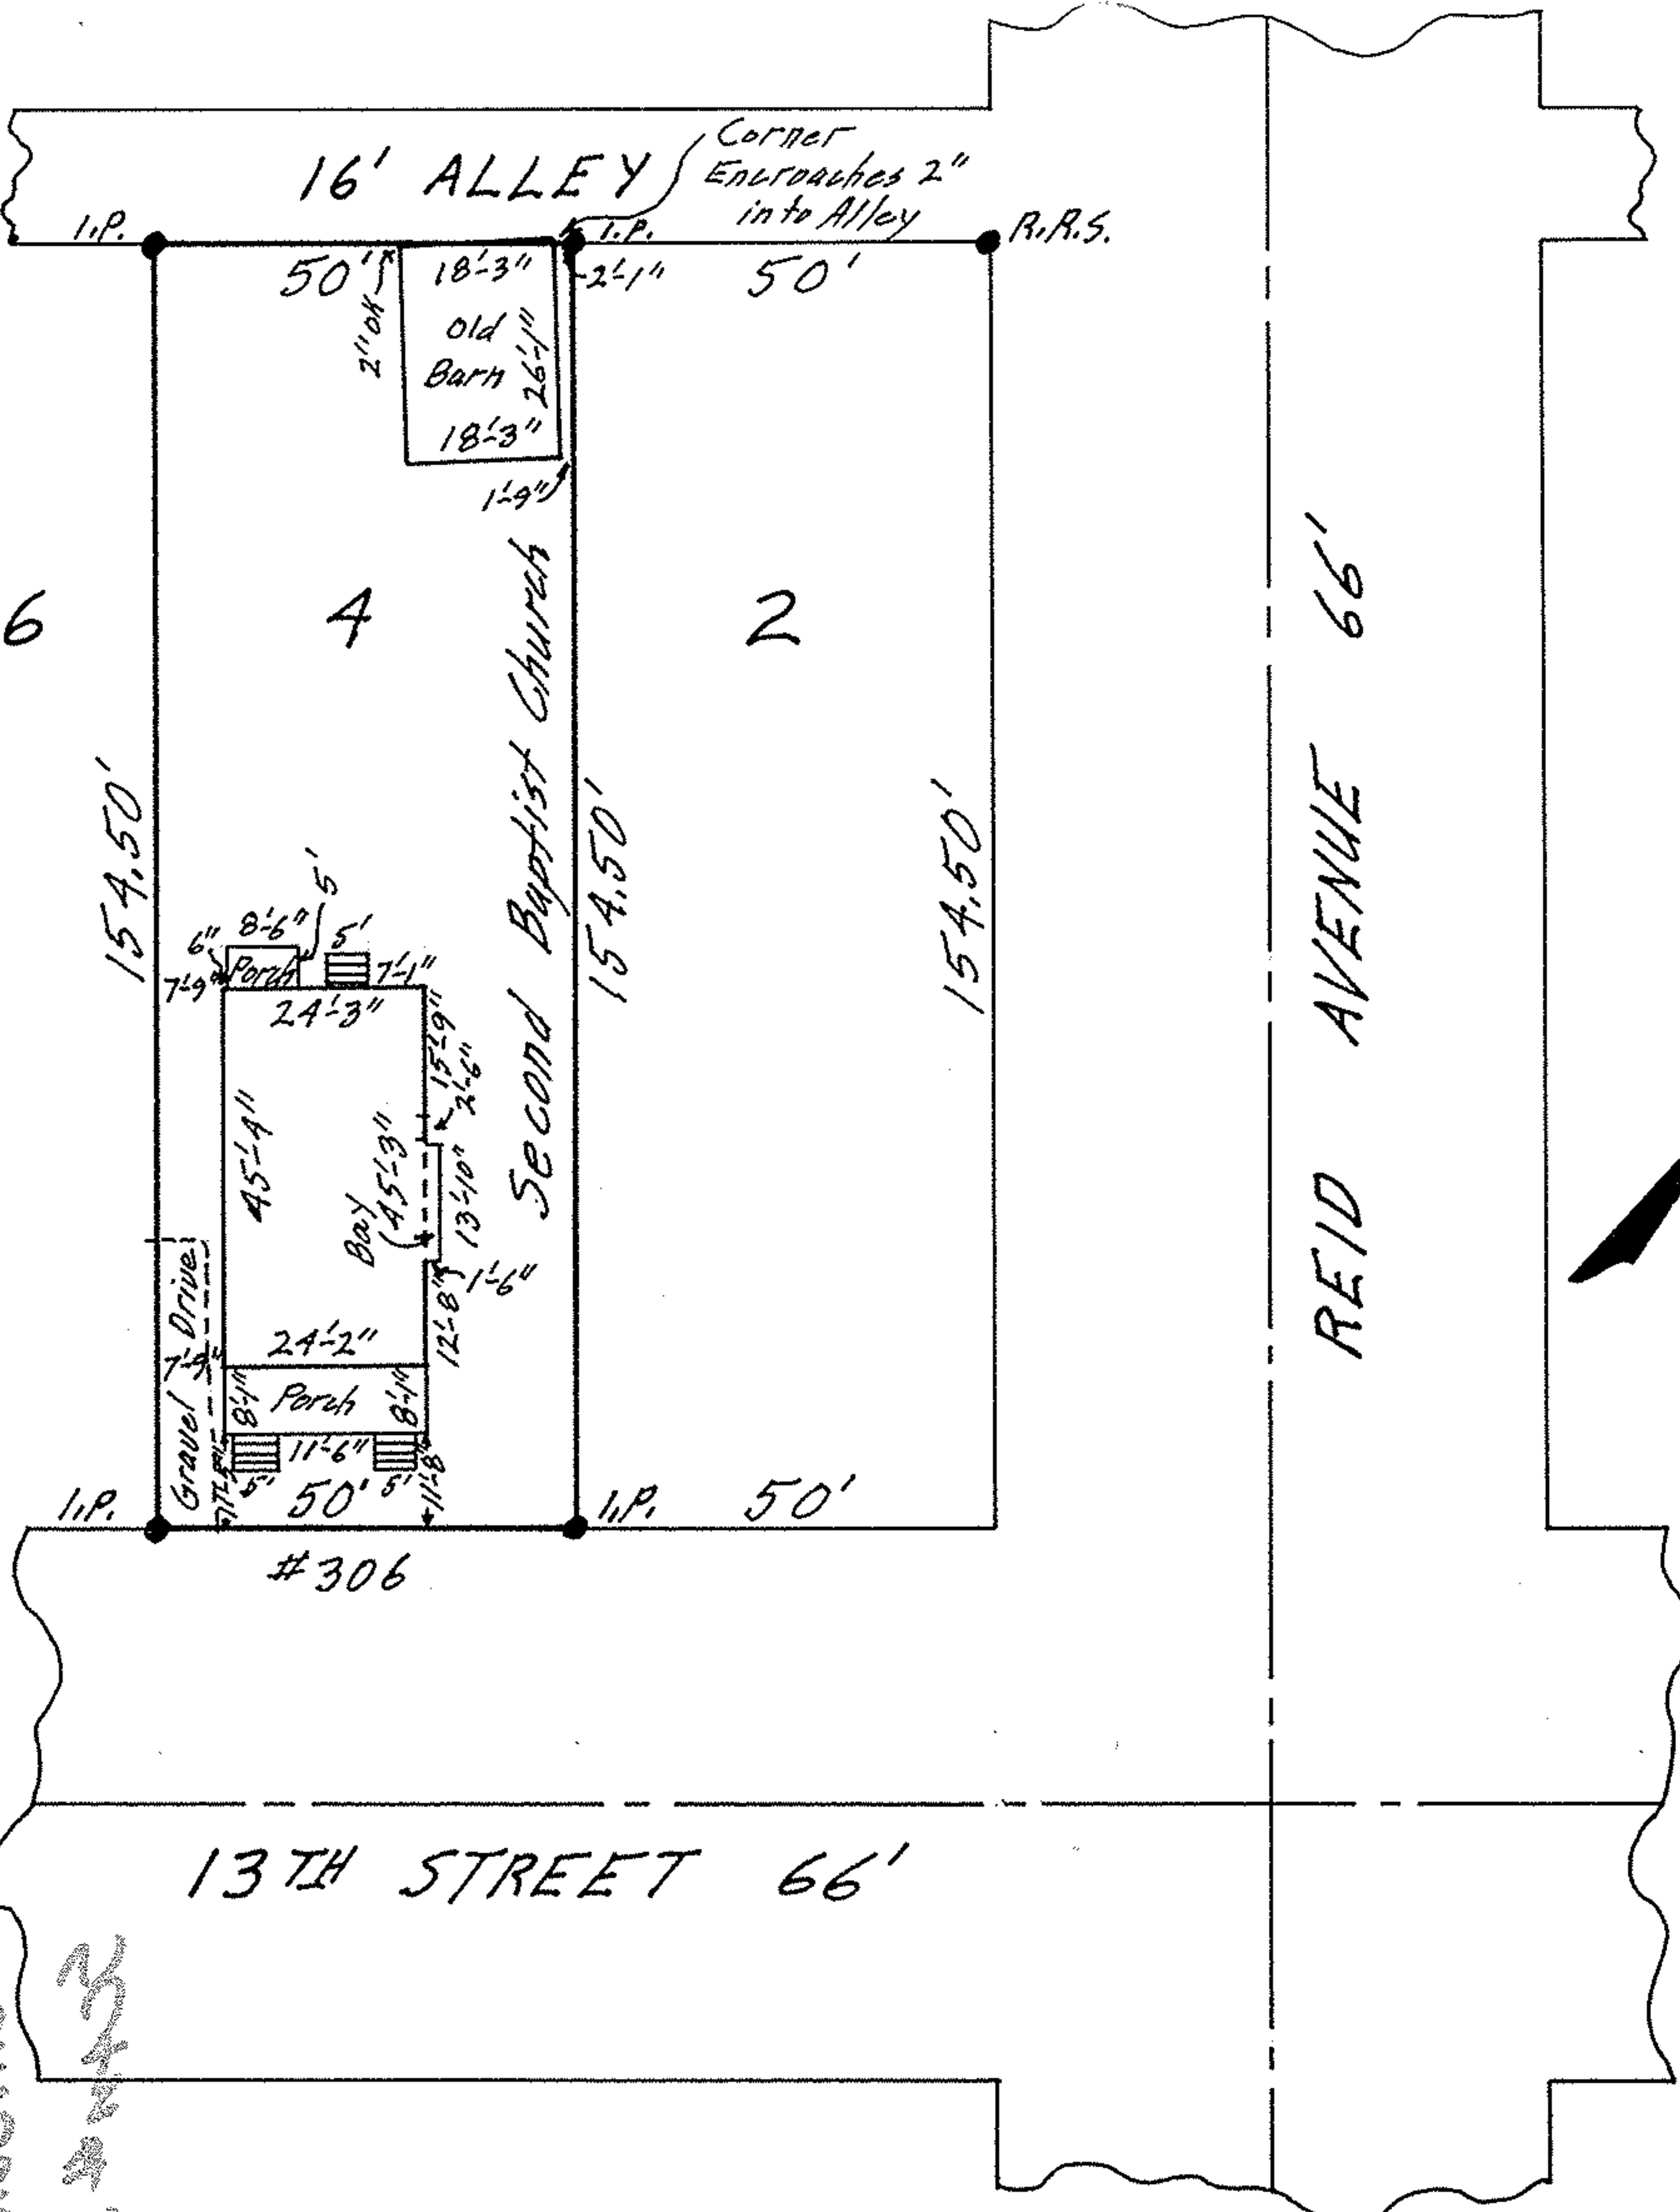

MAP OF SUB-LOT 4 OF BLOCK 20  
 SELAH CHAMBERLAIN ALL'T. VOL. 2 PG. 11 PLATS  
 O.V. 3 - TRACT 1 - BLACK RIVER TWP.  
 LORAIN CITY - LORAIN COUNTY - OHIO  
 SCALE: 1" = 30' APR. 4 - 1967 10:30 A.M.  
 Gary E. Penfound REG. SURVEYOR