


UNRECORDED - SEE ALSO RECORD

NOPE MAR

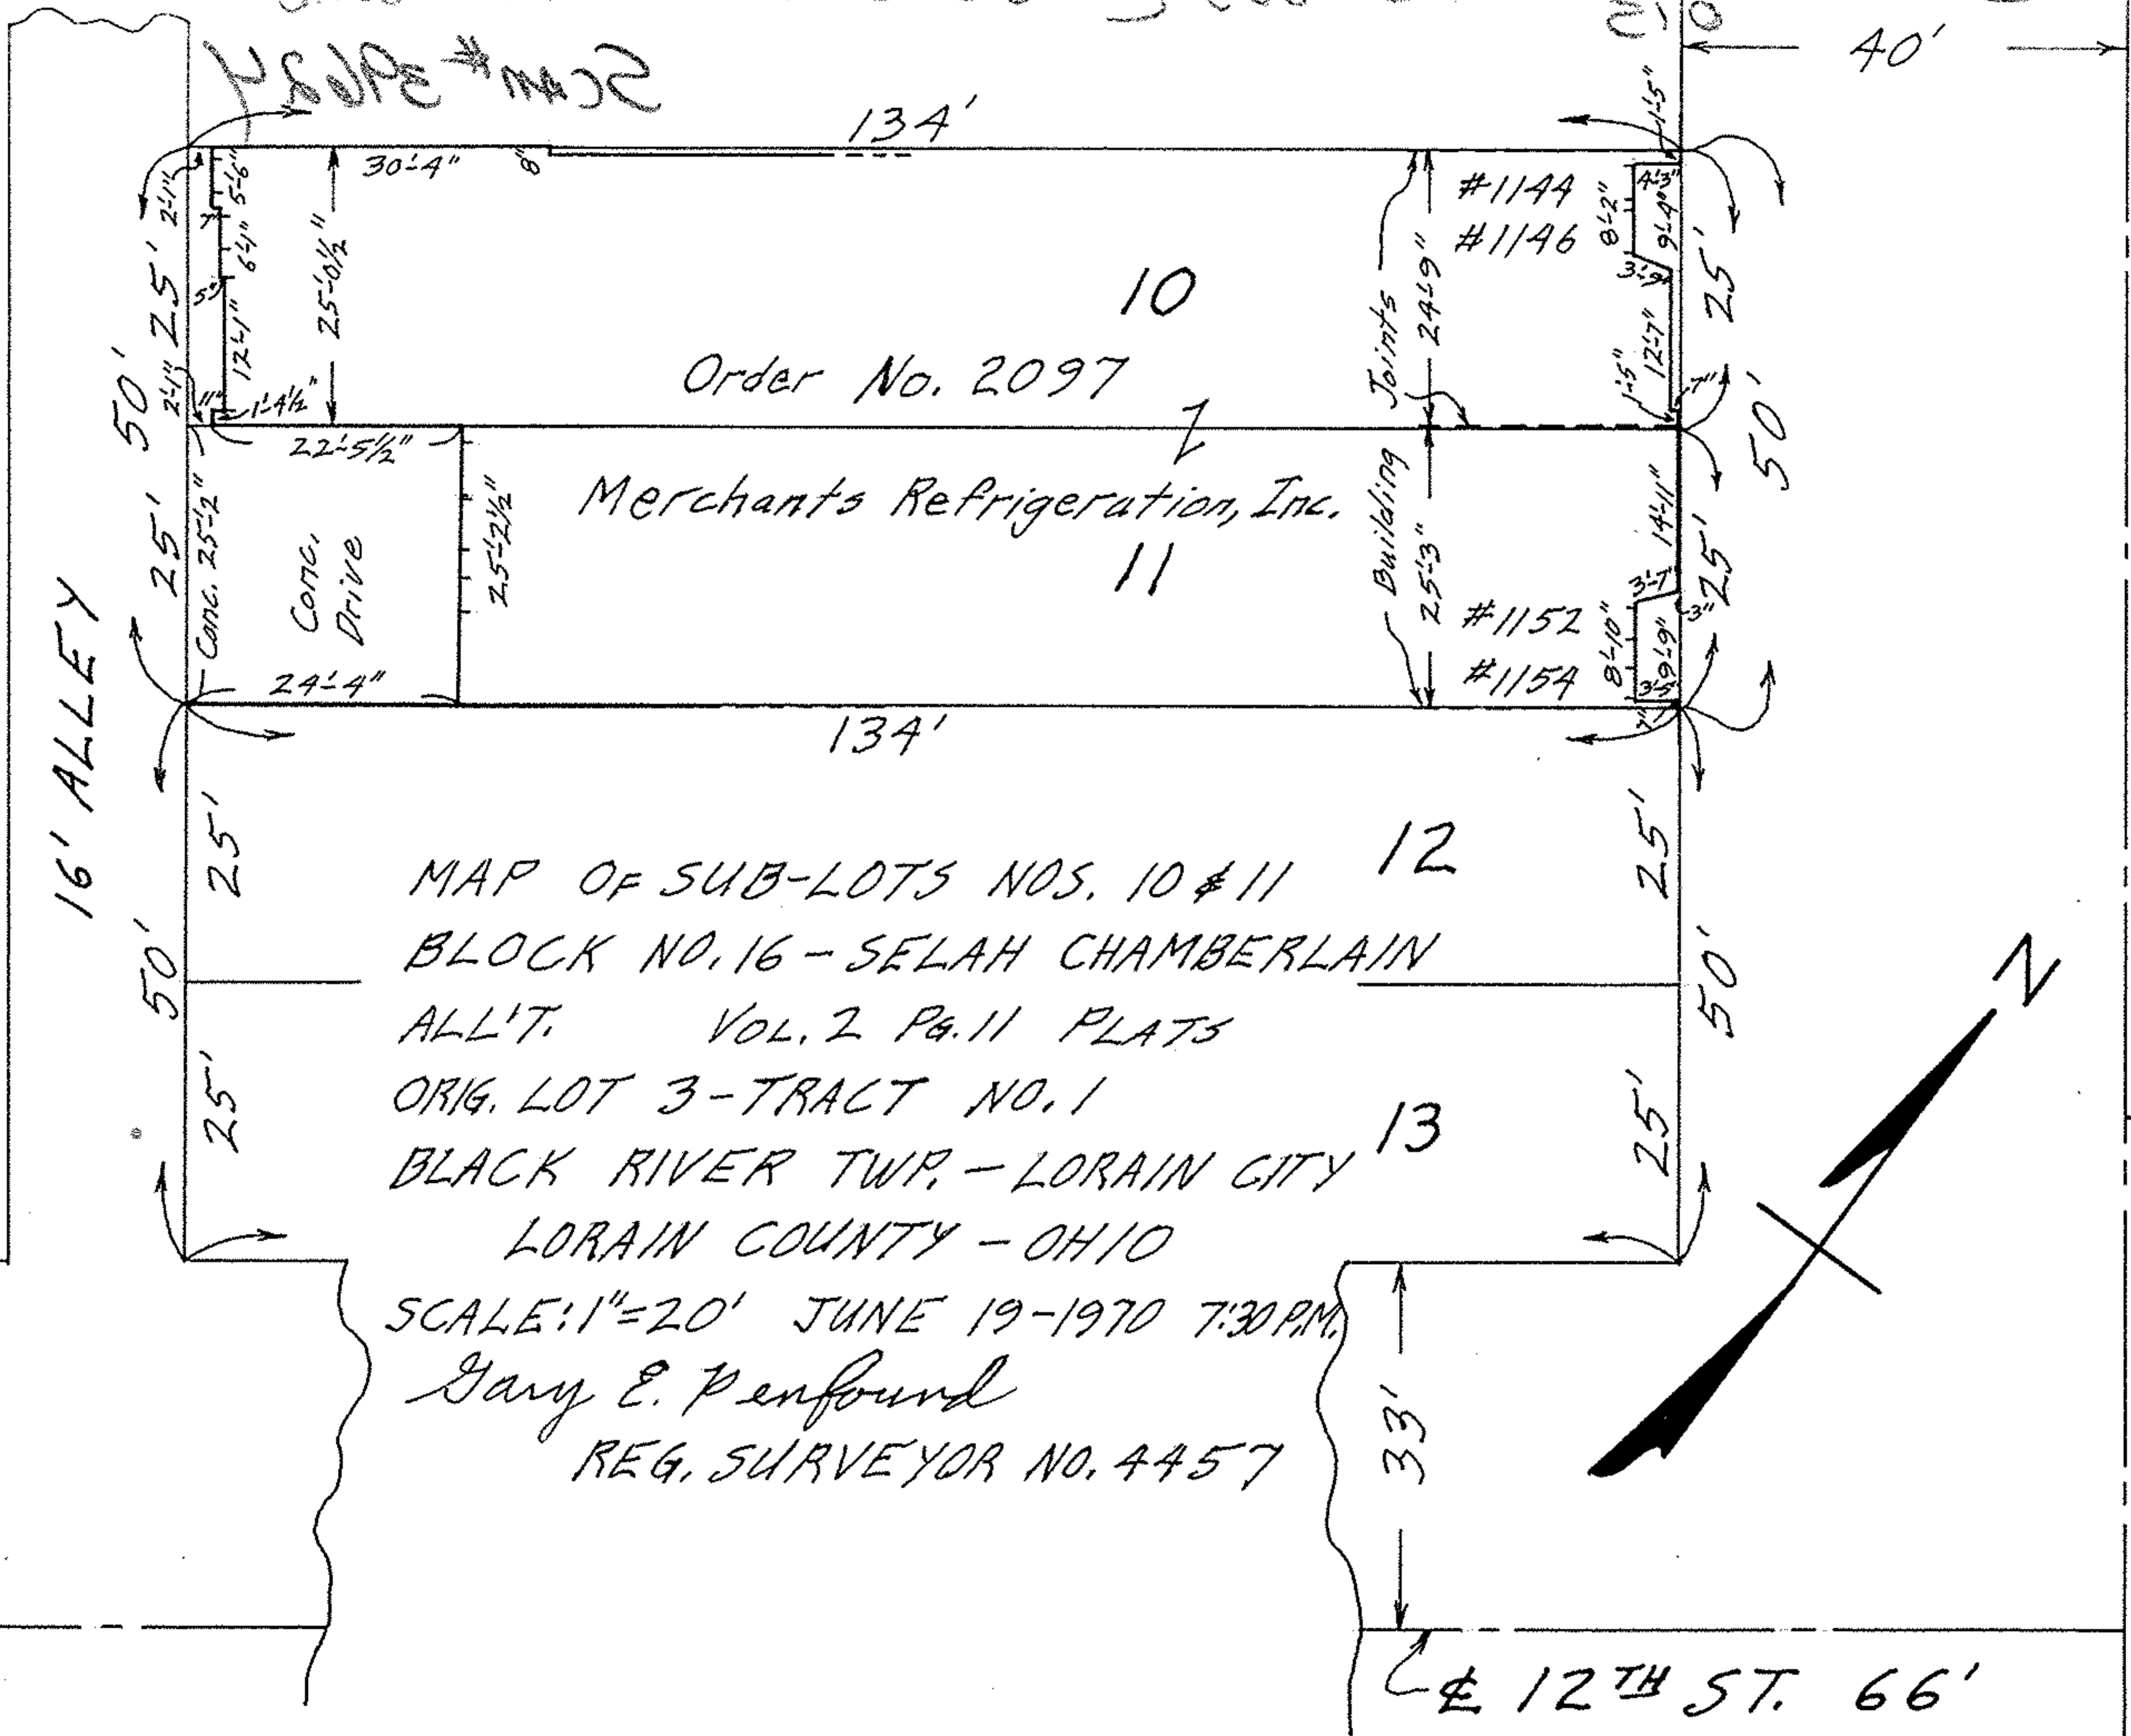

Order No. 2097

Merchants Refrigeration, Inc.

MAP OF SUB-LOTS NOS. 10 & 11 12
 BLOCK NO. 16 - SELAH CHAMBERLAIN
 ALL'T. VOL. 2 Pg. 11 PLATS
 ORIG. LOT 3 - TRACT NO. 1
 BLACK RIVER TWP. - LORAIN CITY 13
 LORAIN COUNTY - OHIO

SCALE: 1" = 20' JUNE 19-1970 7:30 P.M.
 Gary E. Penfound
 REG. SURVEYOR NO. 4457

16' ALLEY

E BROADWAY 80'

E 12TH ST. 66'