


05-01003198018 81099180010-80
05-01-003-H
April 18 70
G Penfound
2041 # 33921

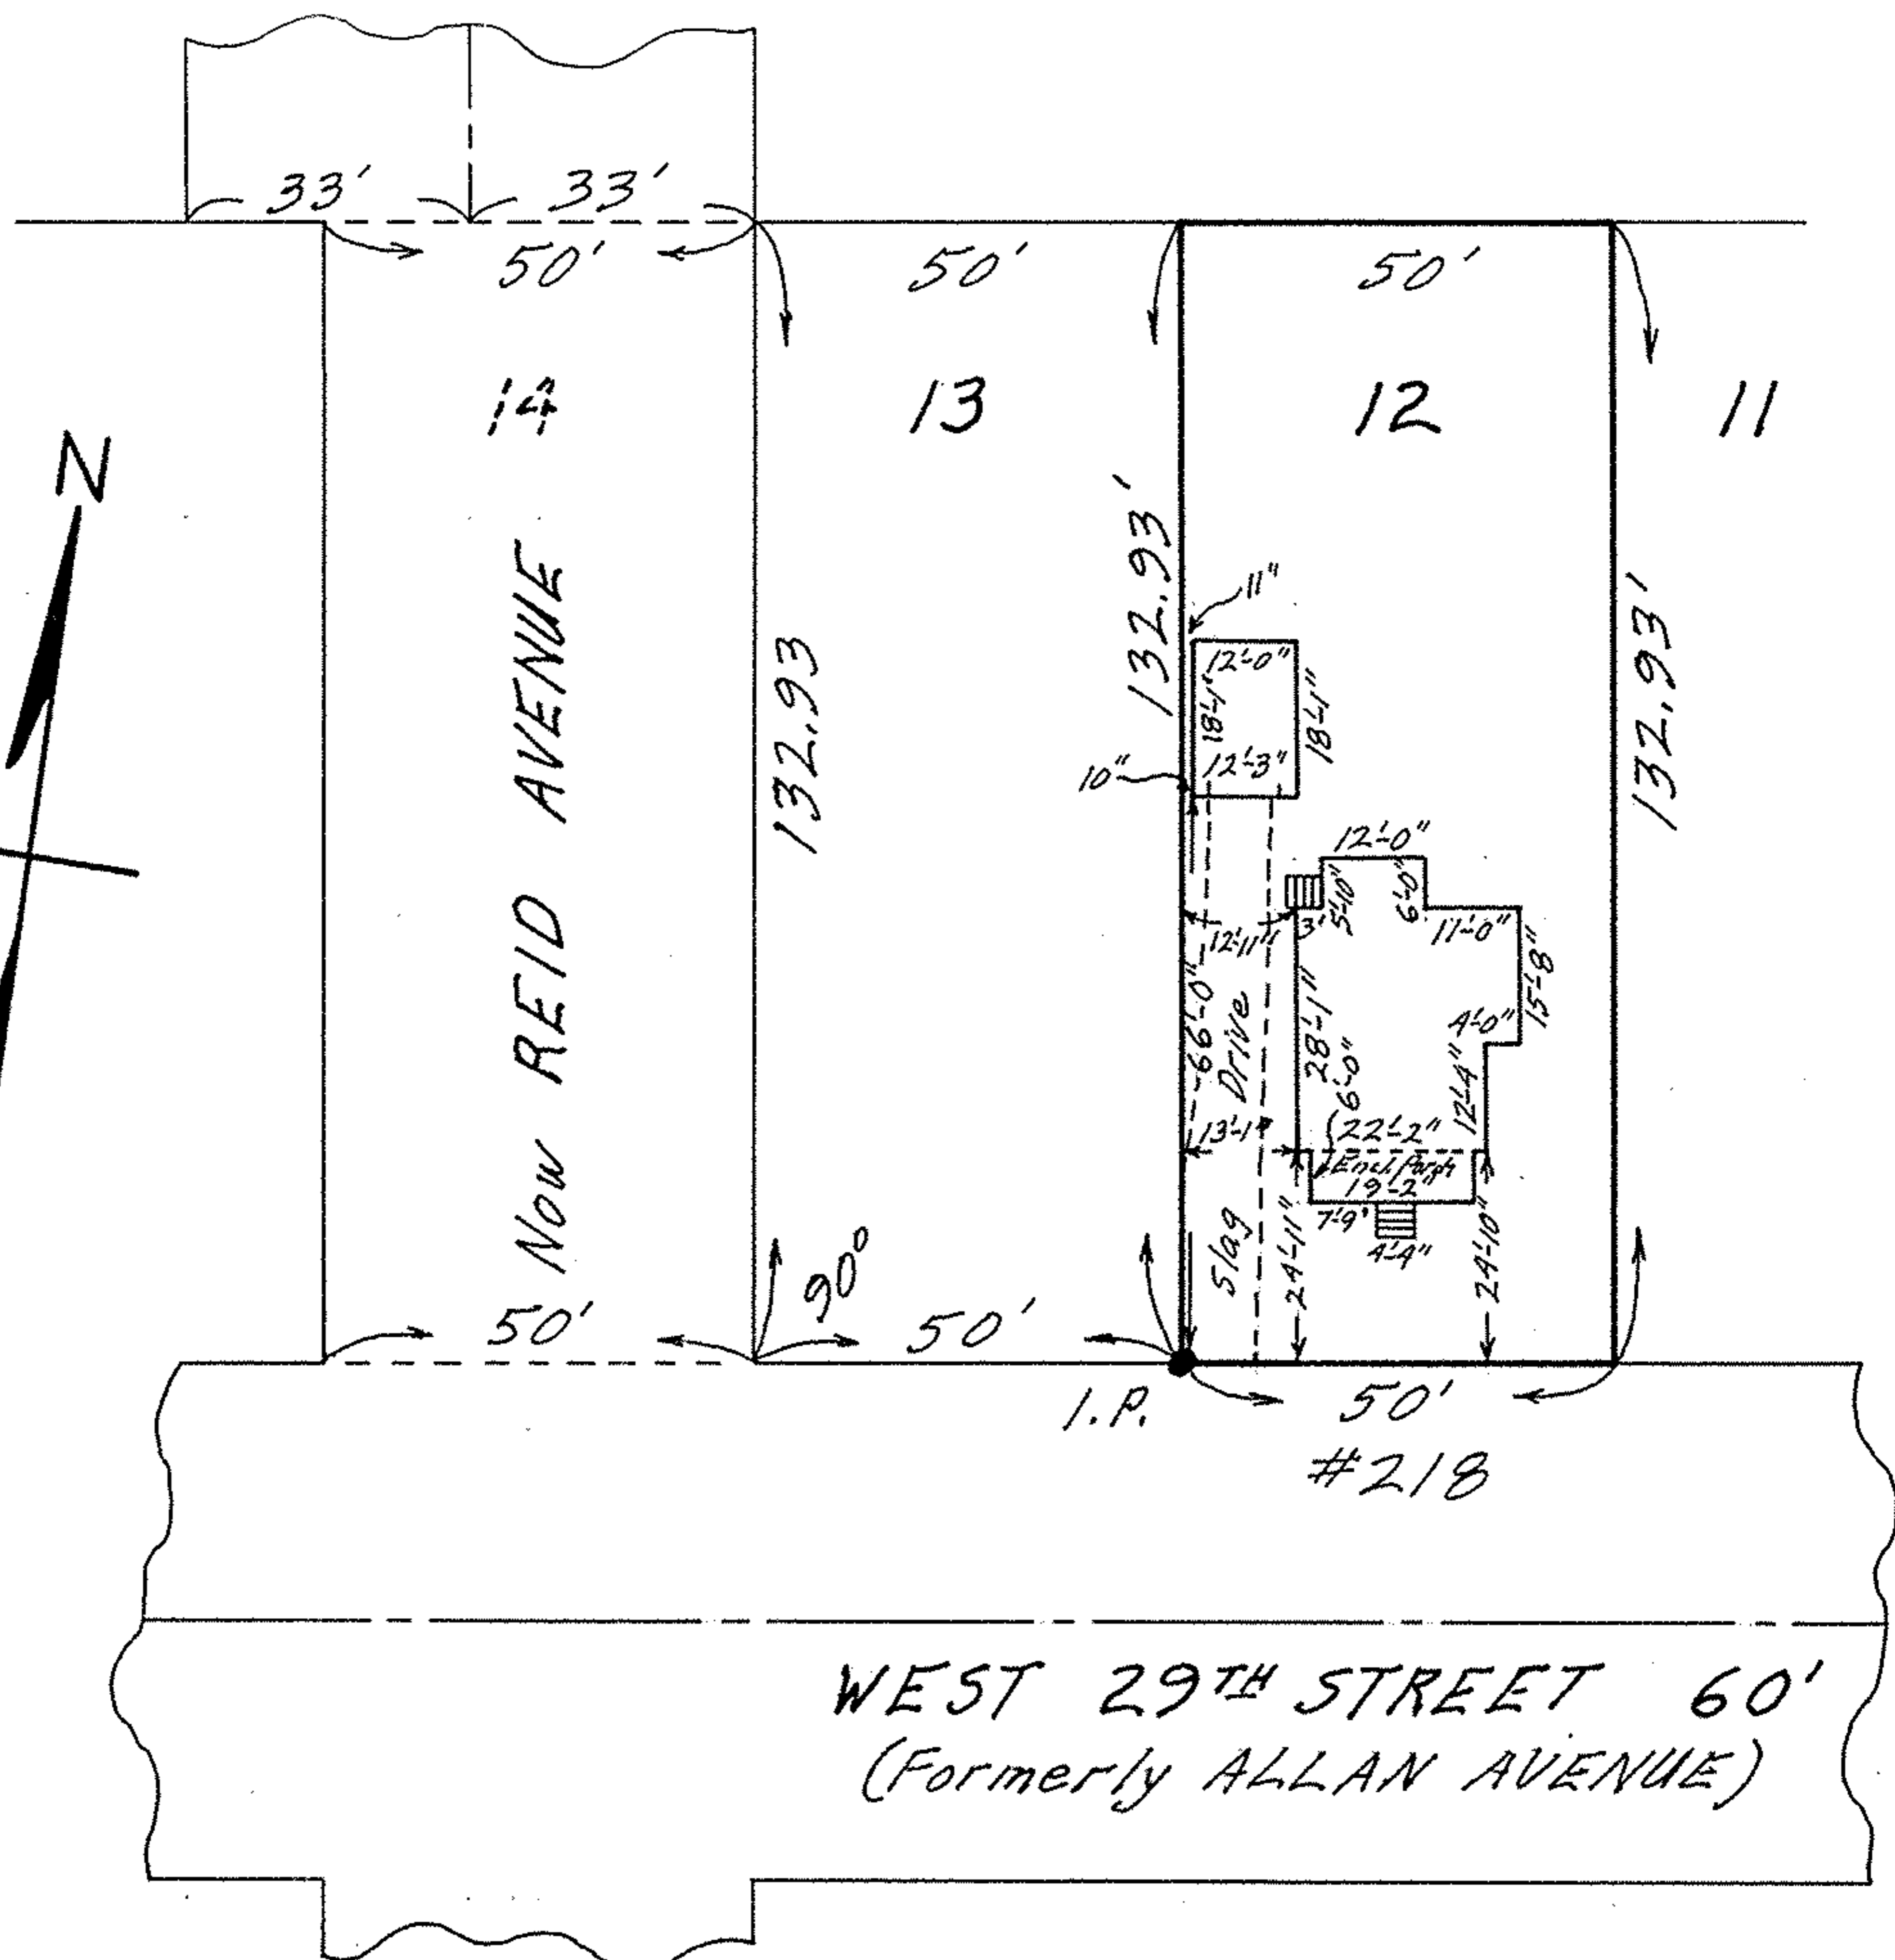

MAP OF SUB-LOT NO. 12

MOREHOUSE & FOSTER'S SUB'N. Vol. 4 Pg. 27
ORIG. LOT 3 - TRACT 1 - BLACK RIVER TWP.
LORAIN CITY - LORAIN COUNTY - OHIO
SCALE: 1"=30' APRIL 18-1970 11:45 A.M.

NOTE: There are no encroachments on this property.
Gary E. Penfound REG. SURVEYOR NO. 4457

CITY TITLE CO. Order No. E-1087-8

Arthur F. Kuhn to Dennis J. & Angela Y. Sniezek