


2-300-10-50 2-300-03-390-040
2-300-10-50 2-300-03-390-040
2-300-10-50 2-300-03-390-040

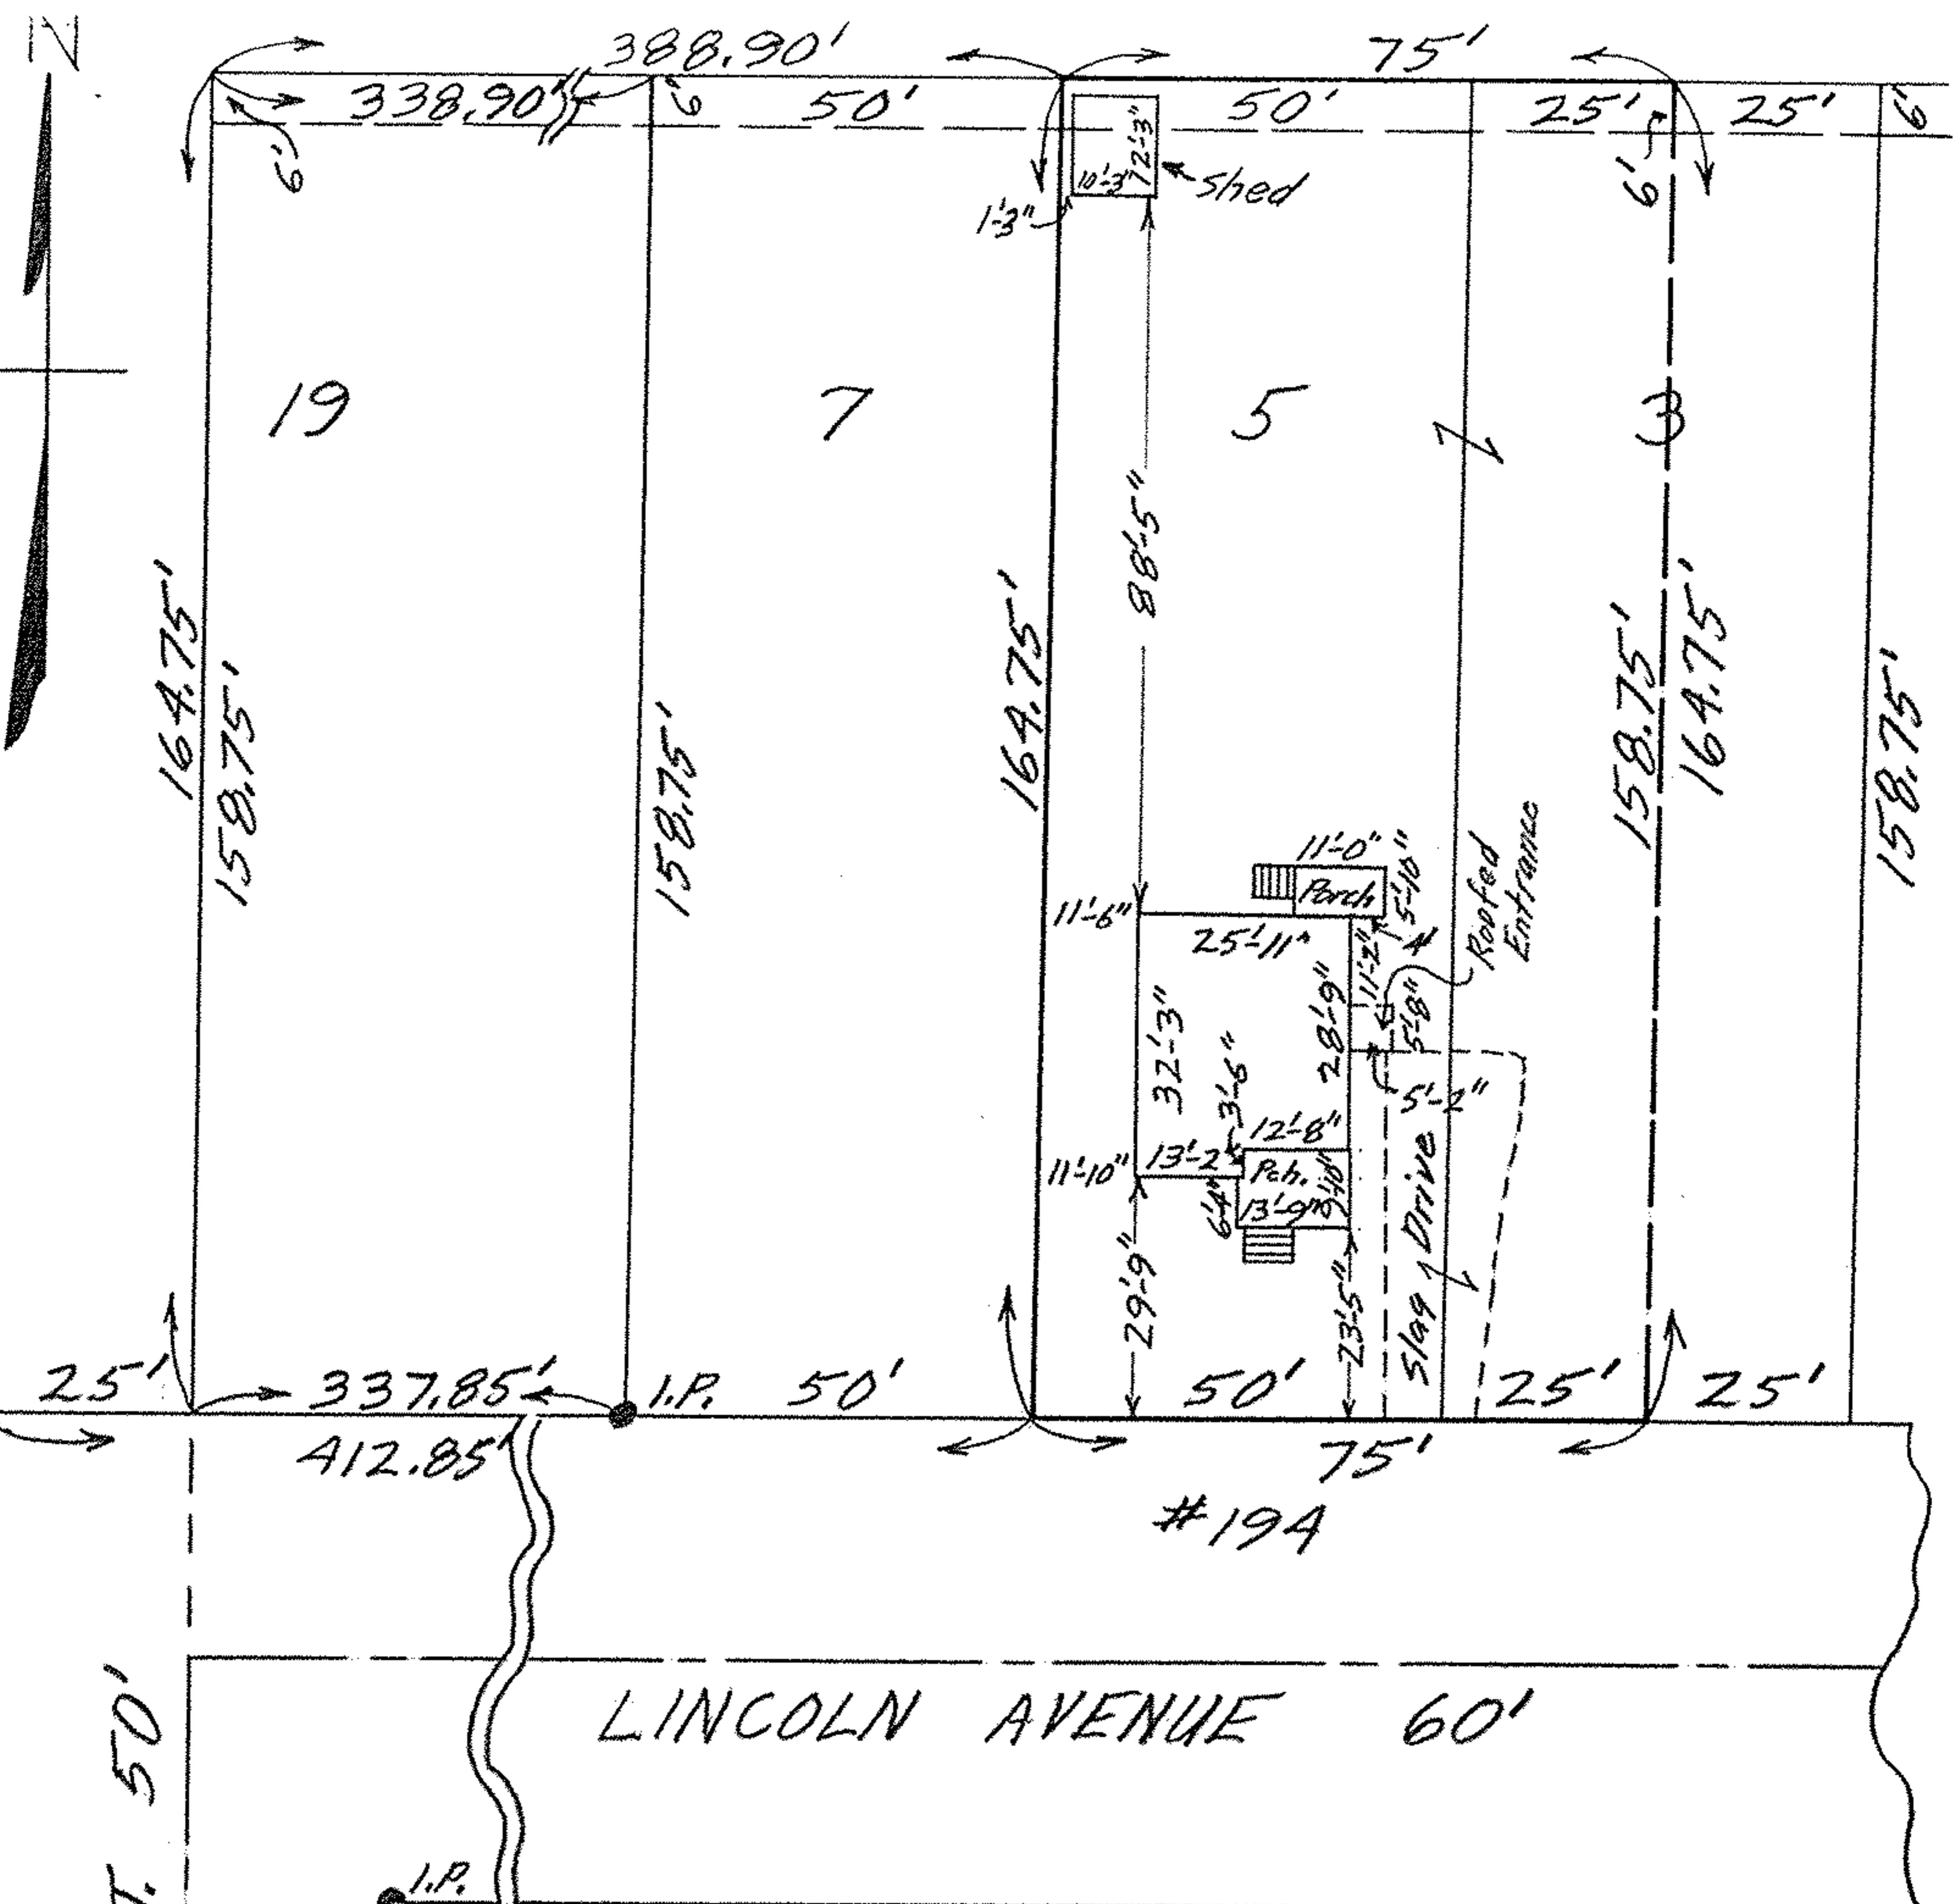

MAP OF SUB-LOT NO. 5 AND THE WESTERLY ONE-HALF OF SUB-LOT NO. 3 OF BLASS & REUTER'S ALL'T. VOL. 5 Pg. 20
 ORIG. LOT 3 - TRACT 1 - BLACK RIVER TWP. LORAIN CITY - LORAIN COUNTY - OHIO
 SCALE: 1"=30' OCT. 26-1965 4:30 P.M.
 Gary E. Penfound REG. SURVEYORS
 for C. E. Penfound
 GL-1351 HALLER, Junior Bradford & Jo Ann