


05-01-003-902-001
100-265-00-10-50
03-01-003-W-300-10-50
JAN 1969

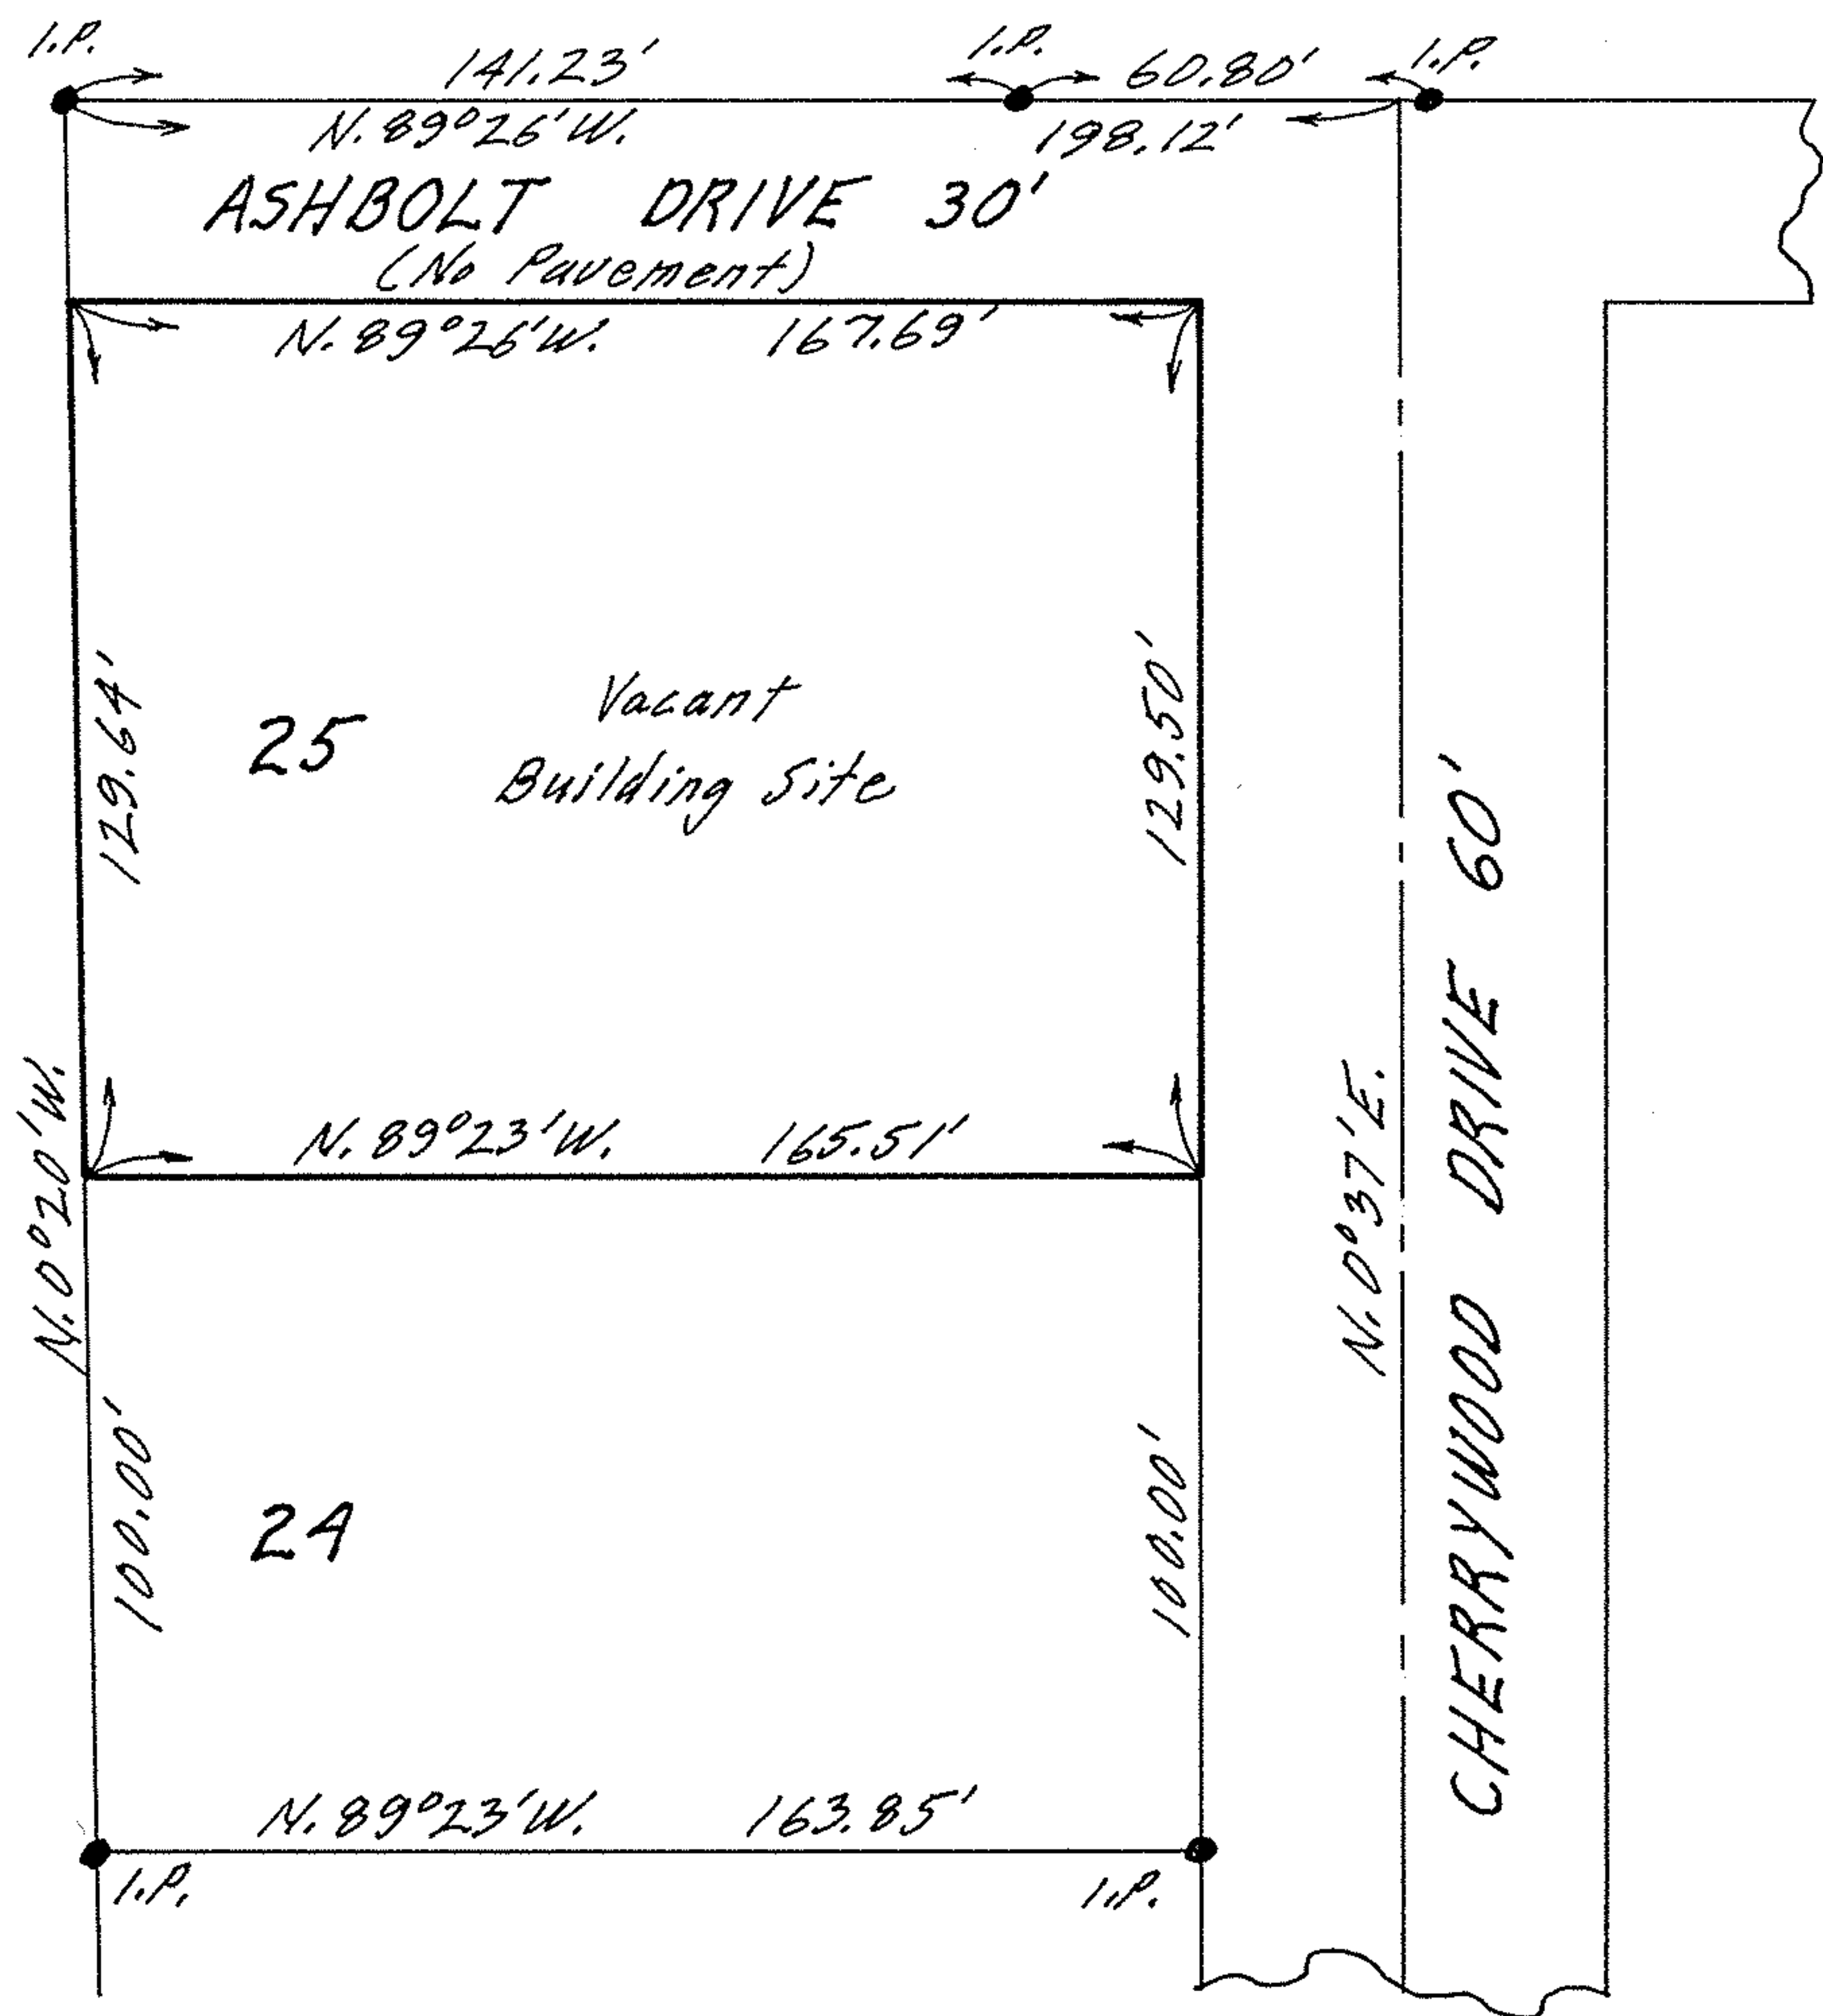

MAP OF SUB-LOT NO. 25

CHERRYLANE SUB'N. NO. 3 VOL. 23 PG. 33

NO. 1 TRACT No. 1 BLACK RIVER TWP.

LORAIN CITY - LORAIN COUNTY - OHIO

SCALE: 1"=40' JAN. 8-1969 12:15 P.M.

Gary E. Penfound REG. SURVEYOR

Daniel L. & Dorothy E. Golini