


02-01-003-512-002
05-01-003-2
Map of part of sub-lot no. 99

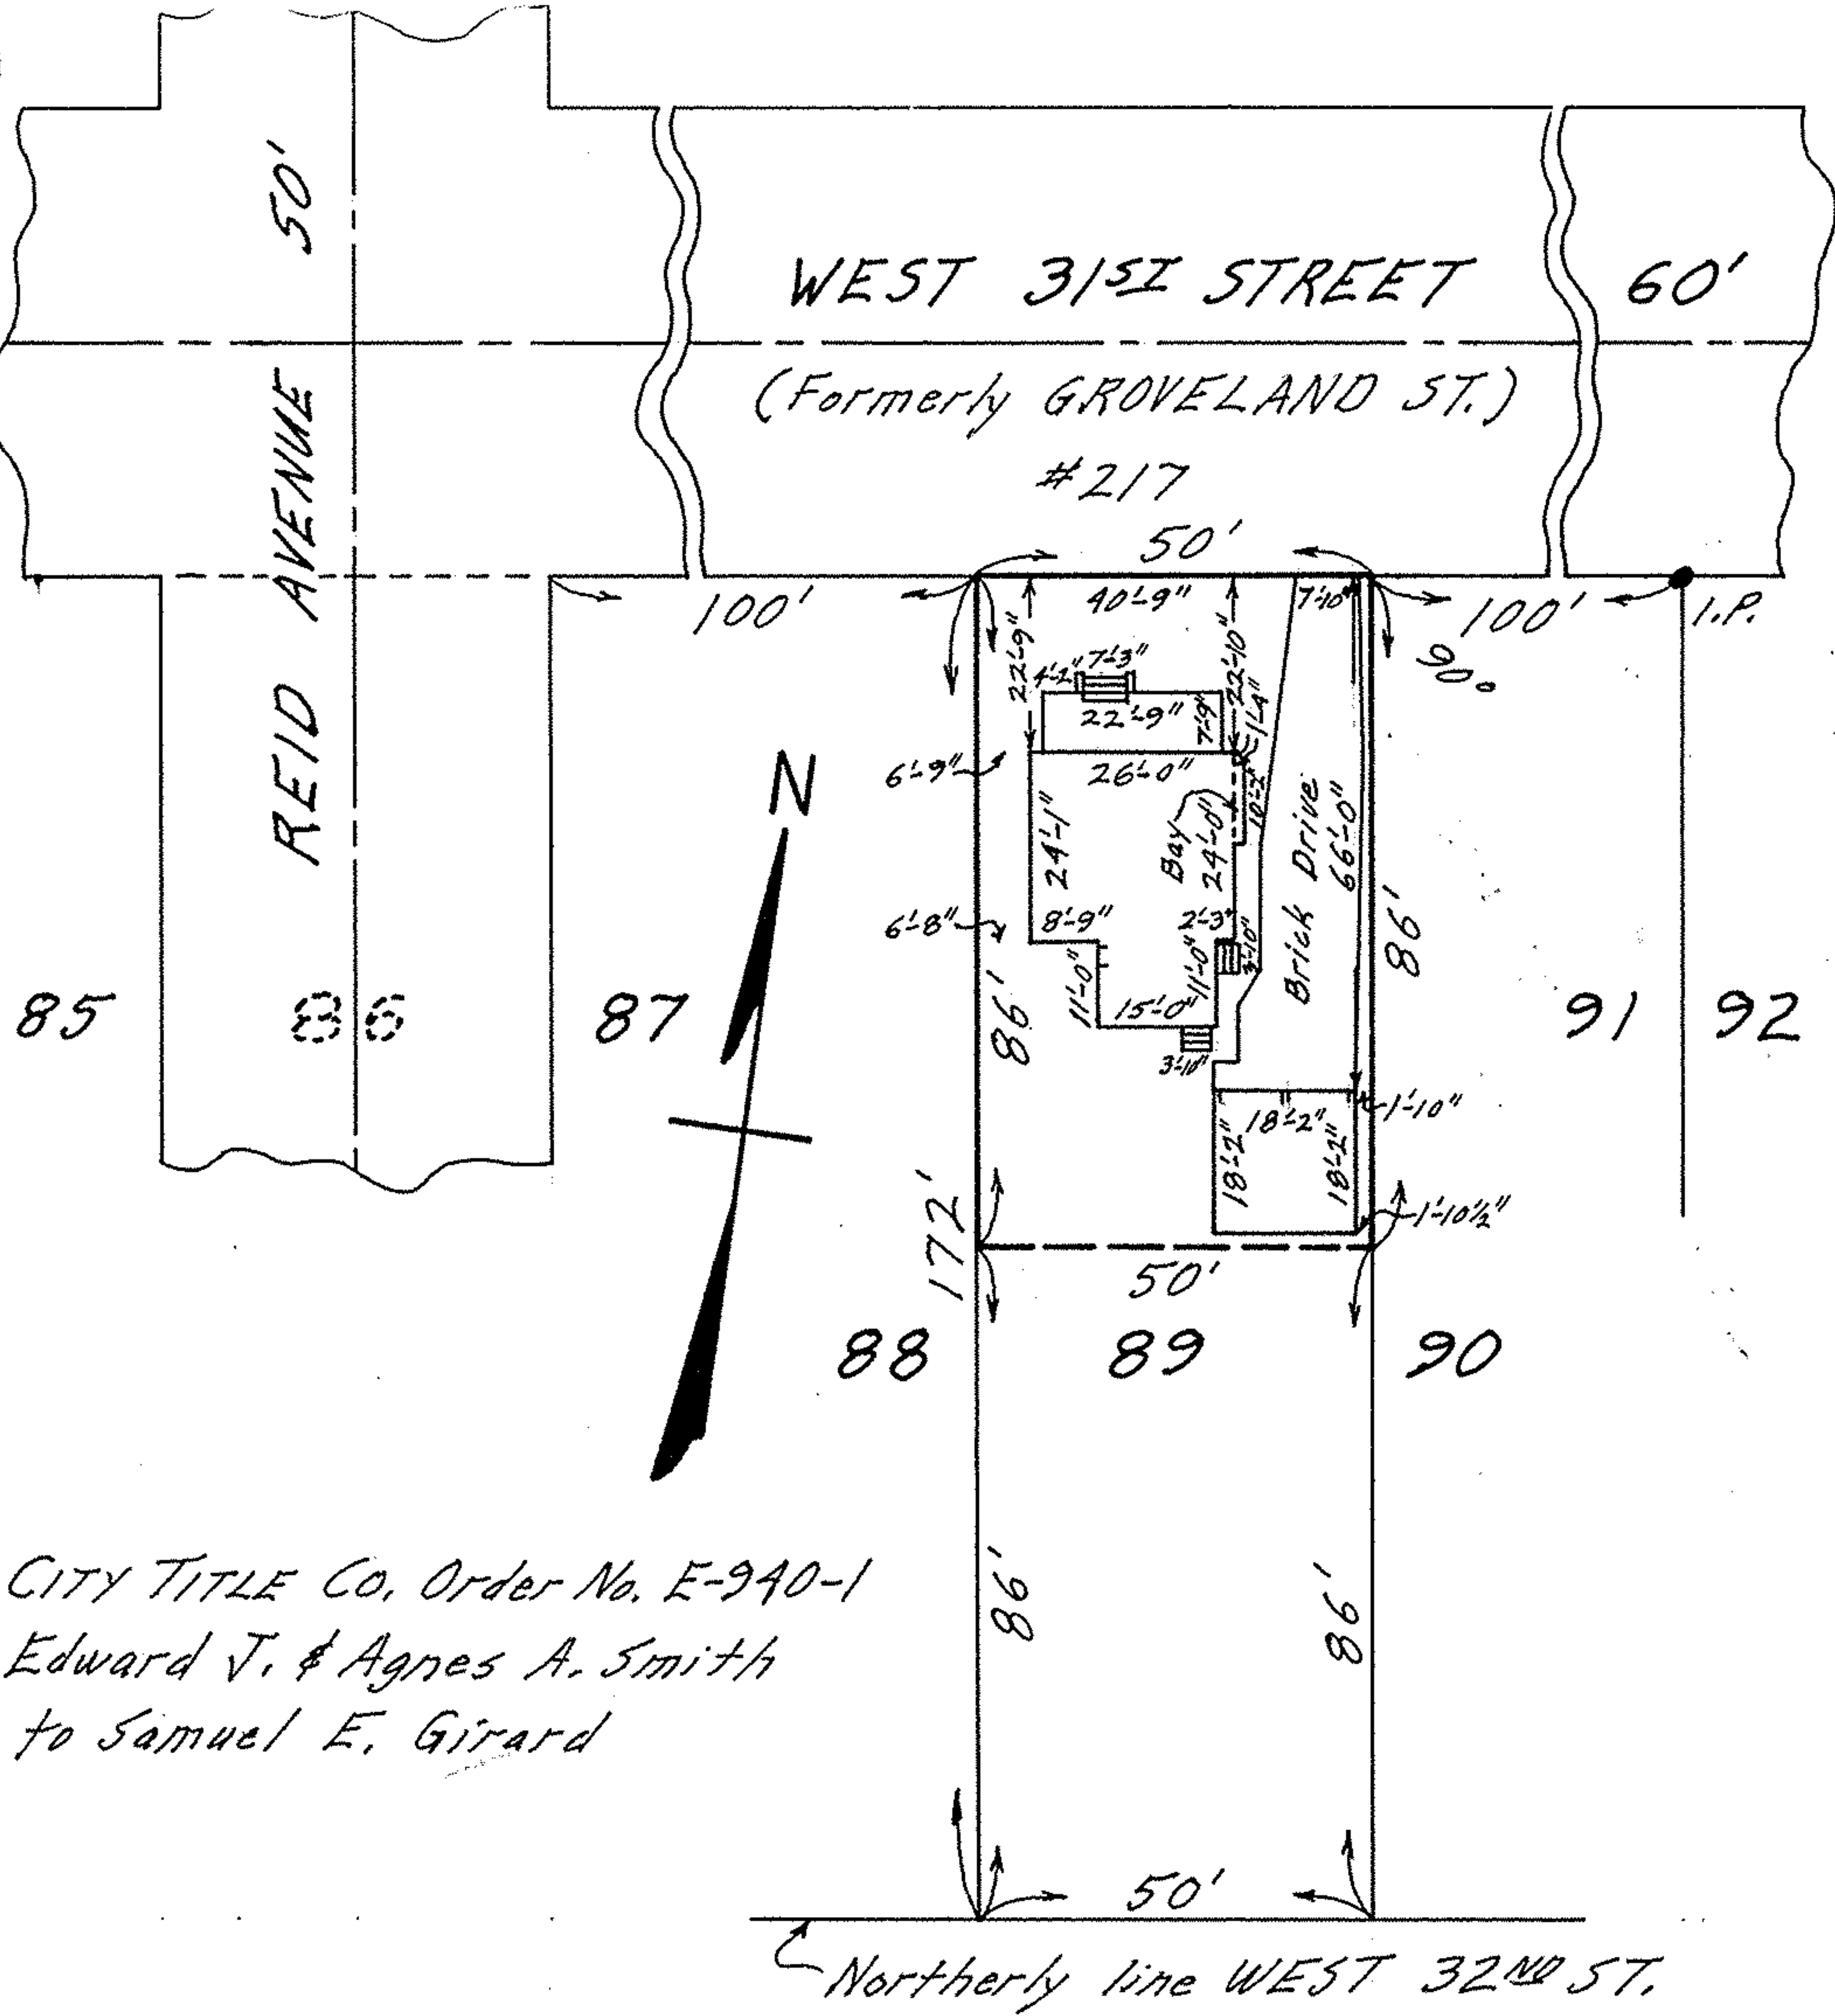

CITY TITLE Co. Order No. E-940-1
Edward J. & Agnes A. Smith
to Samuel E. Girard

MAP OF PART OF SUB-LOT NO. 99
DANIELS AND BRAUN'S ADD'N. Vol. 4 Pg. 41
ORIG. LOT 3 - TRACT NO. 1 - BLACK RIVER TWP.
LORAIN CITY - LORAIN COUNTY - OHIO
SCALE: 1" = 30' NOV. 20-1969 2:00 P.M.
NOTE: There are no encroachments on this property.
Gary E. Penland REG. SURVEYOR NO. 4457