


DIMENSIONS SHOWN ON THIS PLAT ARE EXPRESSED IN FEET AND DECIMAL PARTS THEREOF, ALL BEARINGS ARE TO AN ASSUMED MERIDIAN AND ARE USED TO INDICATE ANGLES ONLY. PERMANENT MONUMENTS WERE FOUND OR SET AT ALL POINTS INDICATED HEREON, ALL OF WHICH I CERTIFY TO BE CORRECT.

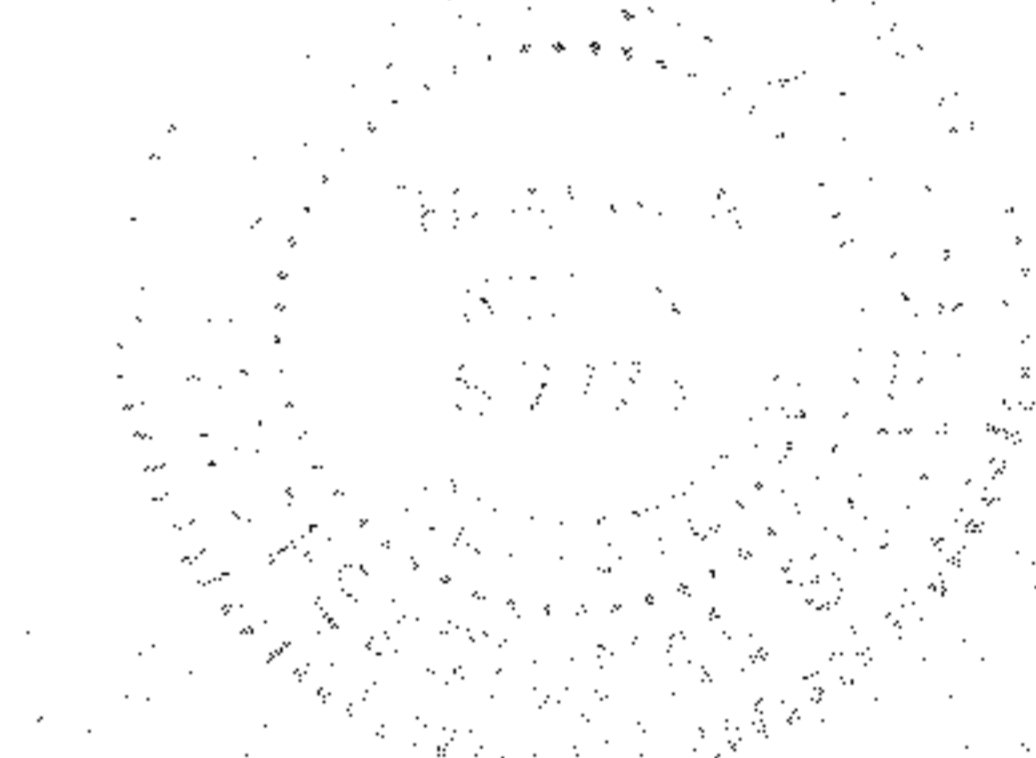

Thomas A. Simon
THOMAS A. SIMON
REG. PROFESSIONAL SURVEYOR
NO. 5-7775

BASIS OF BEARINGS IS THE CENTERLINE OF JERUSALEM ROAD SOUTH 87°43'13" EAST.

4.4506 ACS. TOTAL
EXCEPTING 1.1921 ACS. IN R/W S.R. 2
3.2585 ACS. NET

01-00-031-000-063
Area 326 Ac.

PLAT OF SURVEY FOR
#00 465-A AMELIA J. PRYOR

BEING KNOWN AS PART OF ORIGINAL BROWNHELM TOWNSHIP LOT NO. 31

CITY OF VERMILION COUNTY OF LORAIN STATE OF OHIO

OCTOBER, 2000 SCALE: 1" = 100'

APPROVED
LORAIN CO.
MAP DEPT
DATE 10.30.00
PAGE 1-00-031-B
BY T. Simon
#00465A

1-00-031-B
01-00-031-000-063

THOMAS SIMON & ASSOCIATES, INC.
PROFESSIONAL LAND SURVEYORS
COBBLESTONE CORNER PROFESSIONAL CENTER
39049 CENTER RIDGE ROAD
NORTH RIDGEVILLE, OHIO 44039
(440) 327-2925
FAX 327-2964