



9-00-067-B

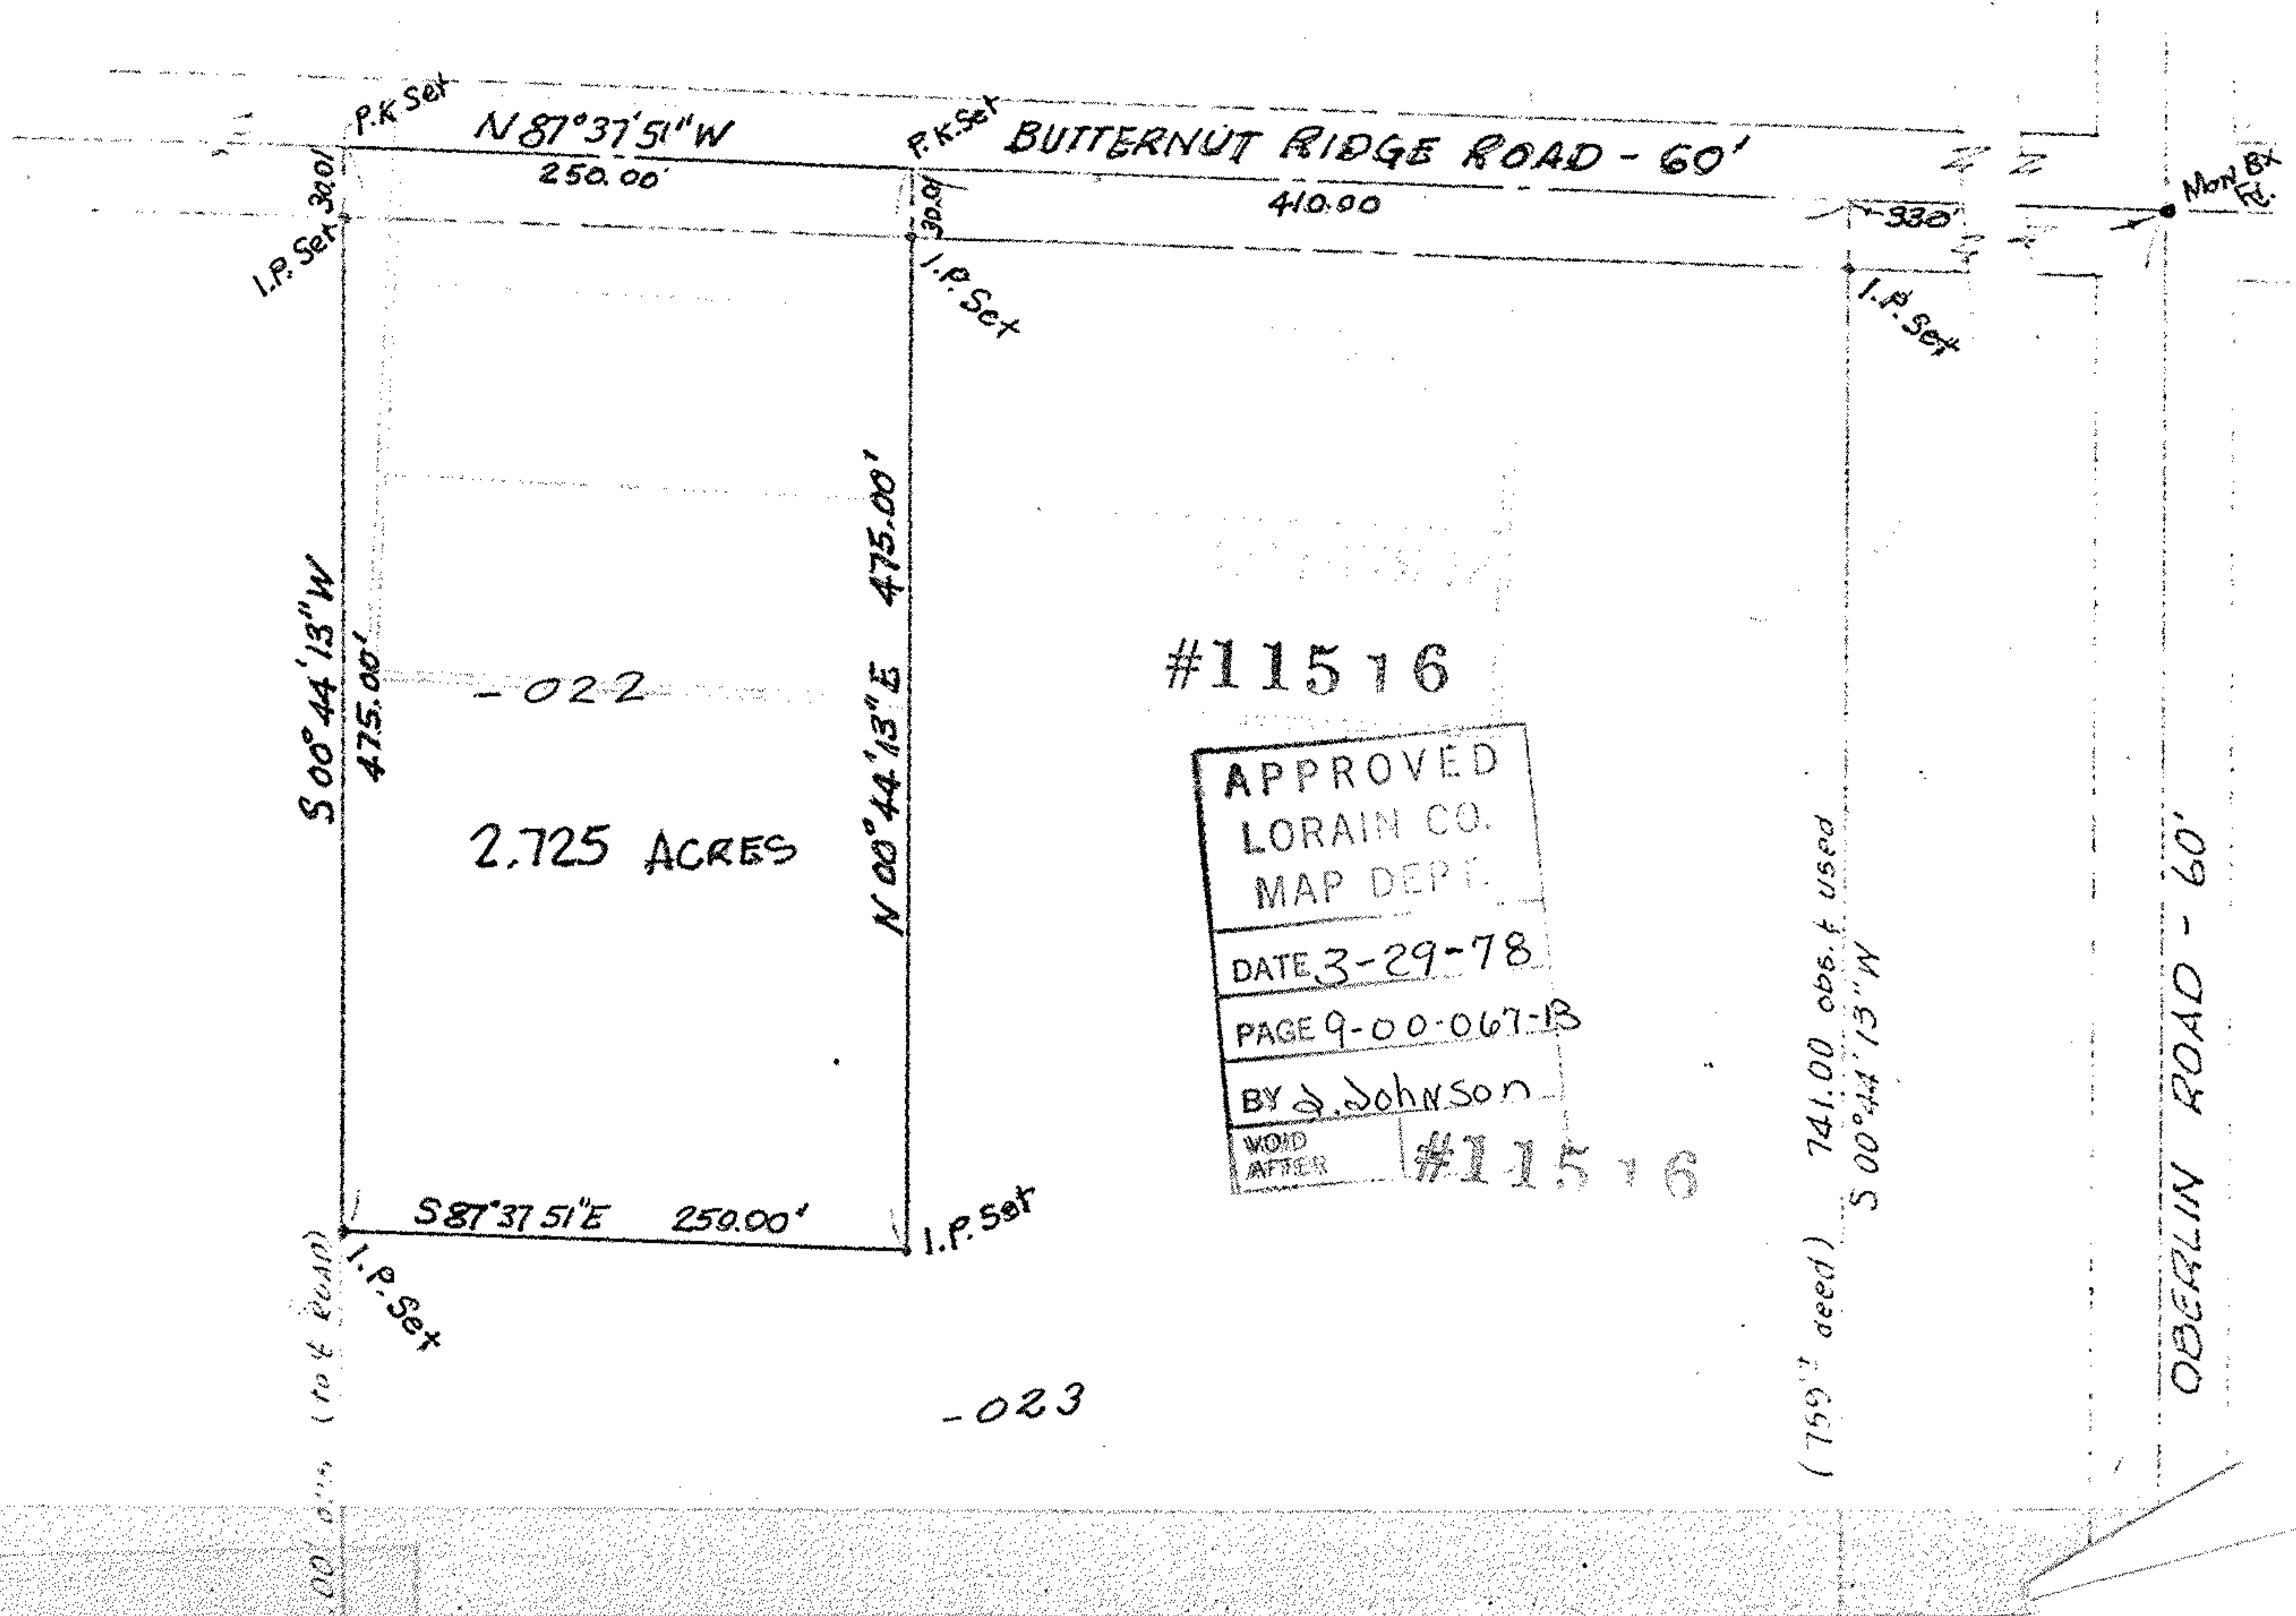

#11516

APPROVED
 LORAIN CO.
 MAP DEPT.
 DATE 3-29-78
 PAGE 9-00-067-13
 BY J. Johnson
 VOID AFTER #11516

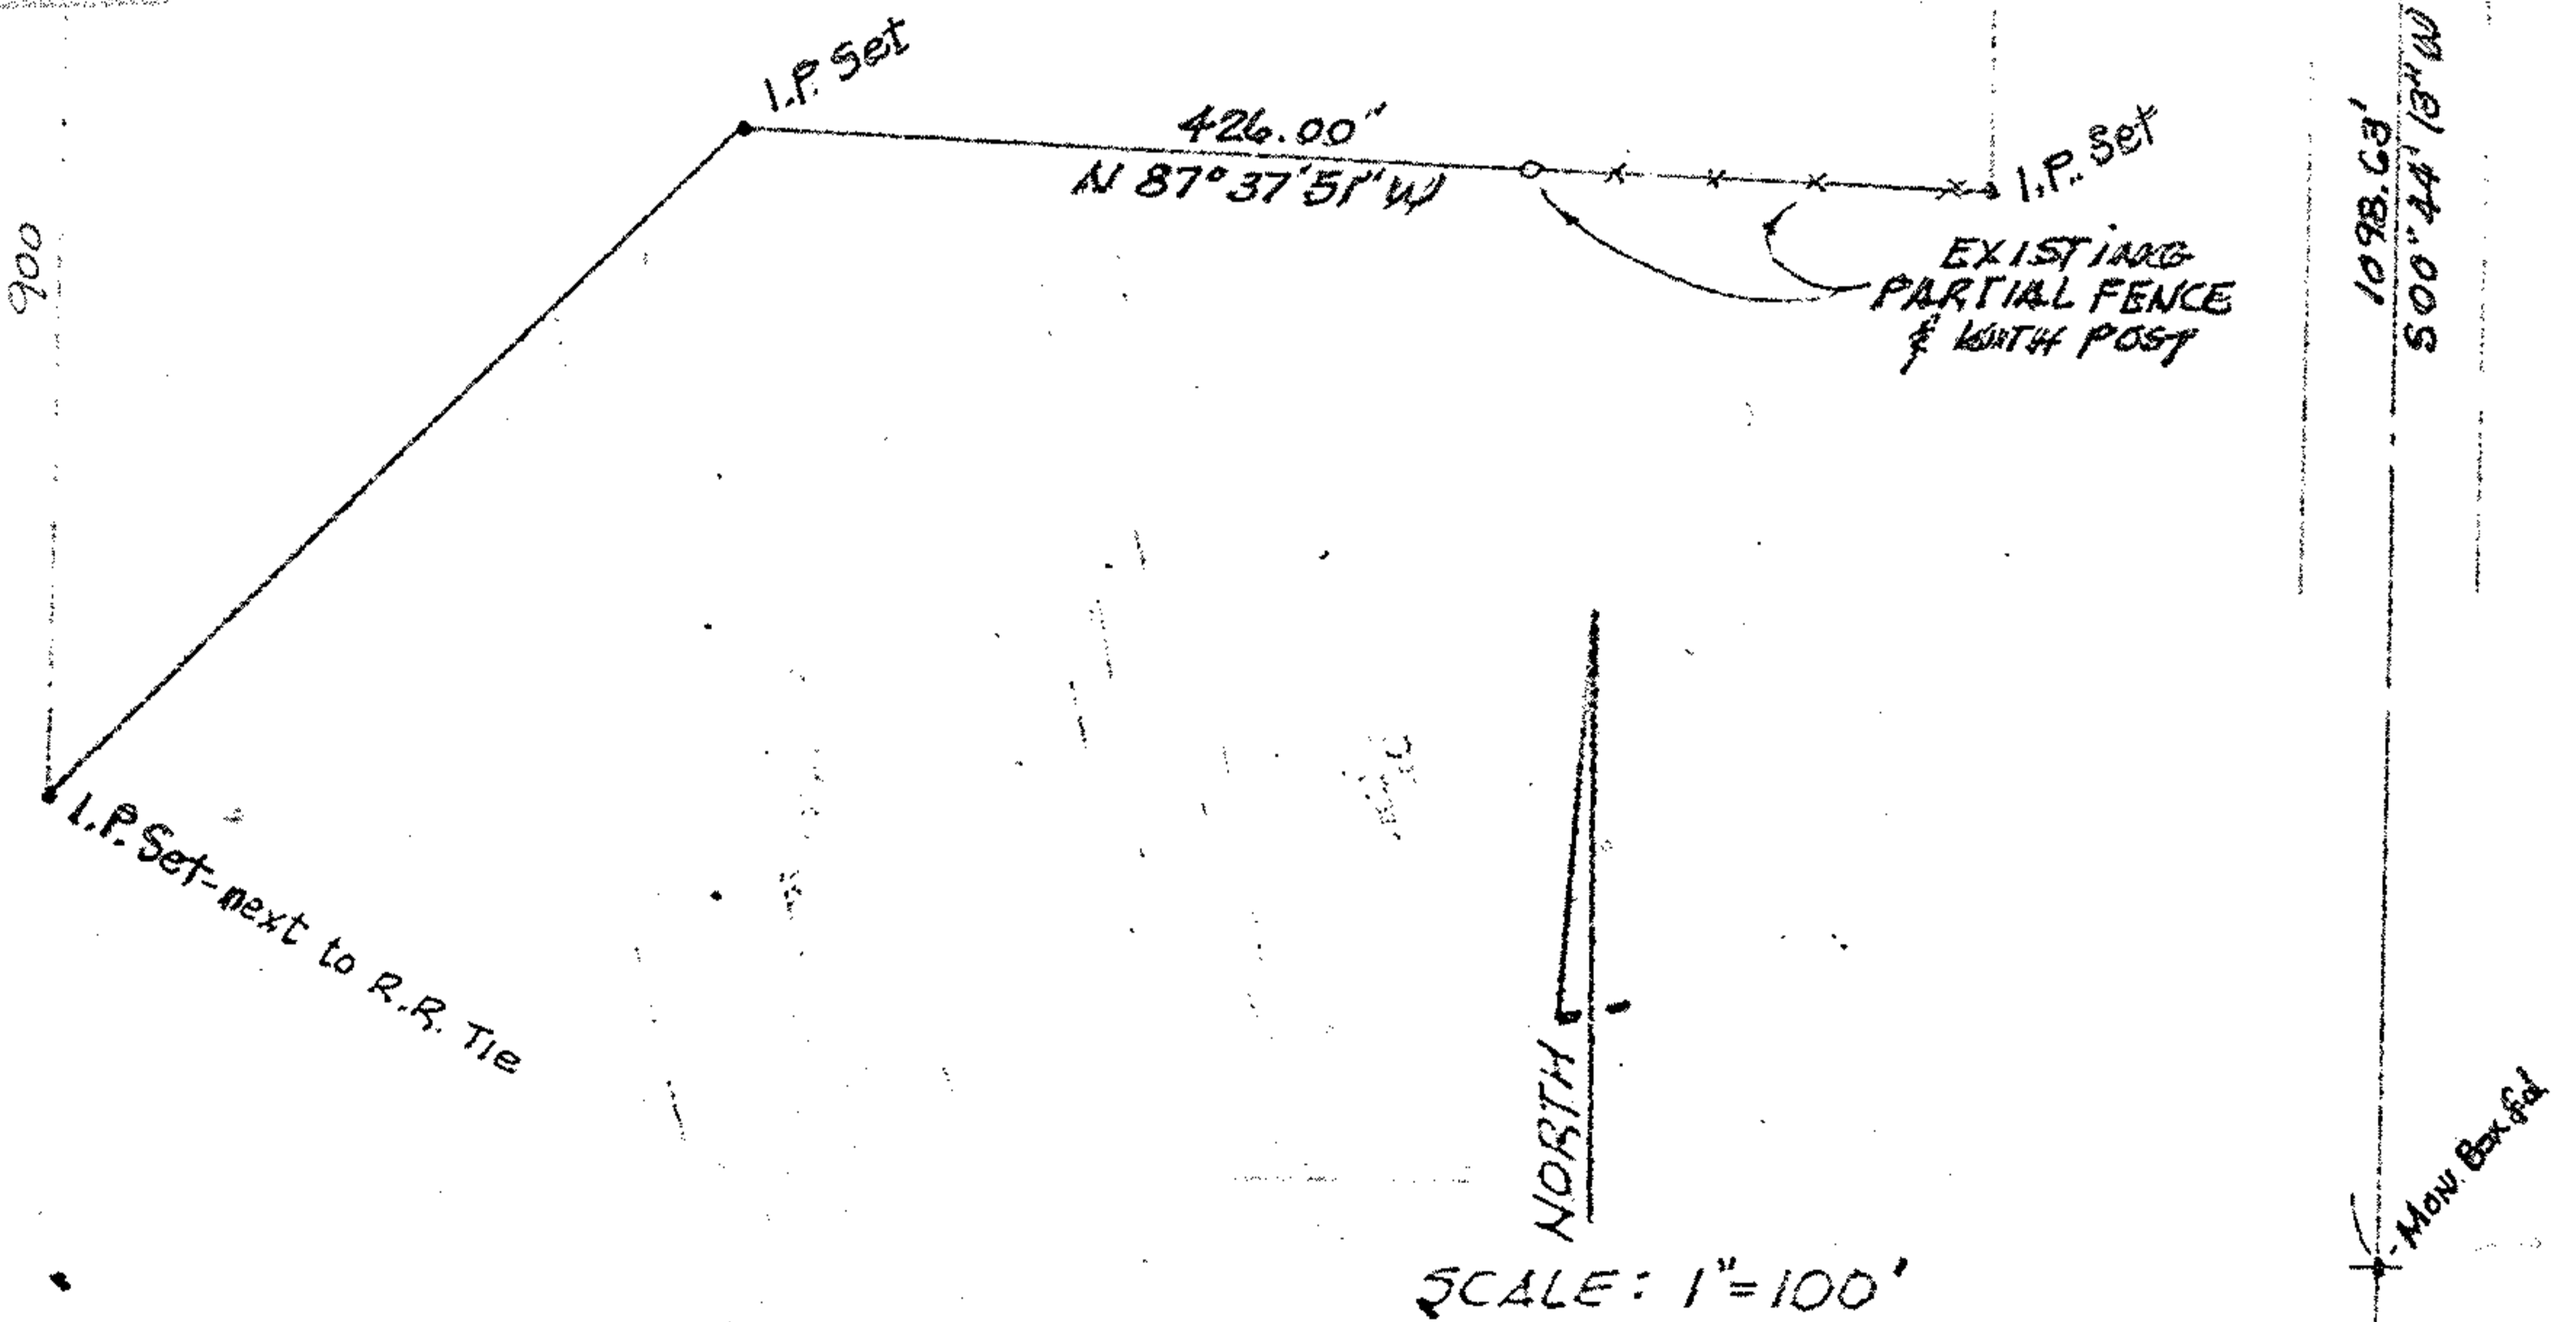

SURVEY MAP of PARCEL SPLIT

for

FRED H WALKER,

PART of ORIGINAL RUSSIA TOWNSHIP LOT 67
RUSSIA TOWNSHIP, LORAIN COUNTY, OHIO

P.P. No. 09-00-067-000-007

McGLINCHY and ASSOCIATES
 PROFESSIONAL ENGINEERS & SURVEYORS
 ELYRIA, OH
 SEPTEMBER, 1977 JOB # 112