


Point	Northing	Easting	Description
6	4990.40280	5263.82550	IRON PIN FOUND
16	5033.64880	5267.10210	IRON PIN FOUND
17	4999.98620	5000.34340	I.P. FD.IN MON.
18	4596.47880	4996.20380	IRON PIN FOUND
19	5042.28440	5033.57210	IRON PIN FOUND
20	4942.61720	5025.17580	REBAR SET
21	4885.88970	5048.27820	house
22	4858.18360	5091.10010	house
23	4868.22140	5125.98060	garage
24	4845.81640	5157.94290	garage
25	4792.06450	5177.52380	nail
26	4864.22840	5160.32640	garage
27	4850.12640	5123.69520	garage
28	4878.99660	5092.65580	house
29	4861.33890	5046.39230	house
30	4677.67820	5237.38920	IRON PIN FOUND
31	4777.32290	5245.81250	POINT
32	4933.95410	5259.05370	POINT
33	4687.27540	4973.56420	POINT
34	4686.18370	5003.57430	POINT
35	4785.70400	5012.06080	POINT
36	4777.32400	5245.80410	REBAR SET
37	4933.94370	5259.05120	REBAR SET
38	4686.05360	5003.70600	IRON PIN FOUND
39	4785.70530	5012.05090	REBAR SET
40	5043.37799	5004.00194	pt
41	4687.12015	4973.96438	pt
42	4943.71405	4995.59886	pt
43	4786.77026	4982.36629	pt

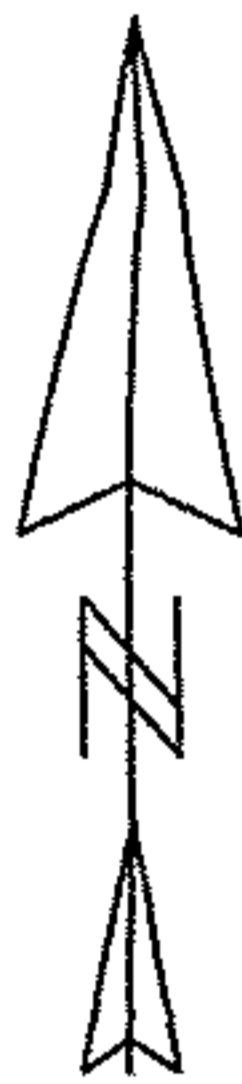

Scale 1" = 40'
July 8, 2006

Note: Only copies signed with Red Ink shall be considered Valid.

Patrick A. McGannon
Patrick A. McGannon P.S. 7154


No 02250
DATE 11-14-06
PAGE 9-00-003-B
BY JHATflew
#06-02250

Note: Bearings shown are to an assumed meridian and are used to describe angles only.

Prepared for Michelle Winiarski
of 324 Fern Street South Amherst,
Ohio, 44001.

Being known as part of
of Original Lot 10, and 11
of Amherst Township and
Part of Original Lot 3 of
Russia Township in
the Village of South Amherst,
County of Lorain, in the
State of Ohio.

Pyle South Amherst Road 60'

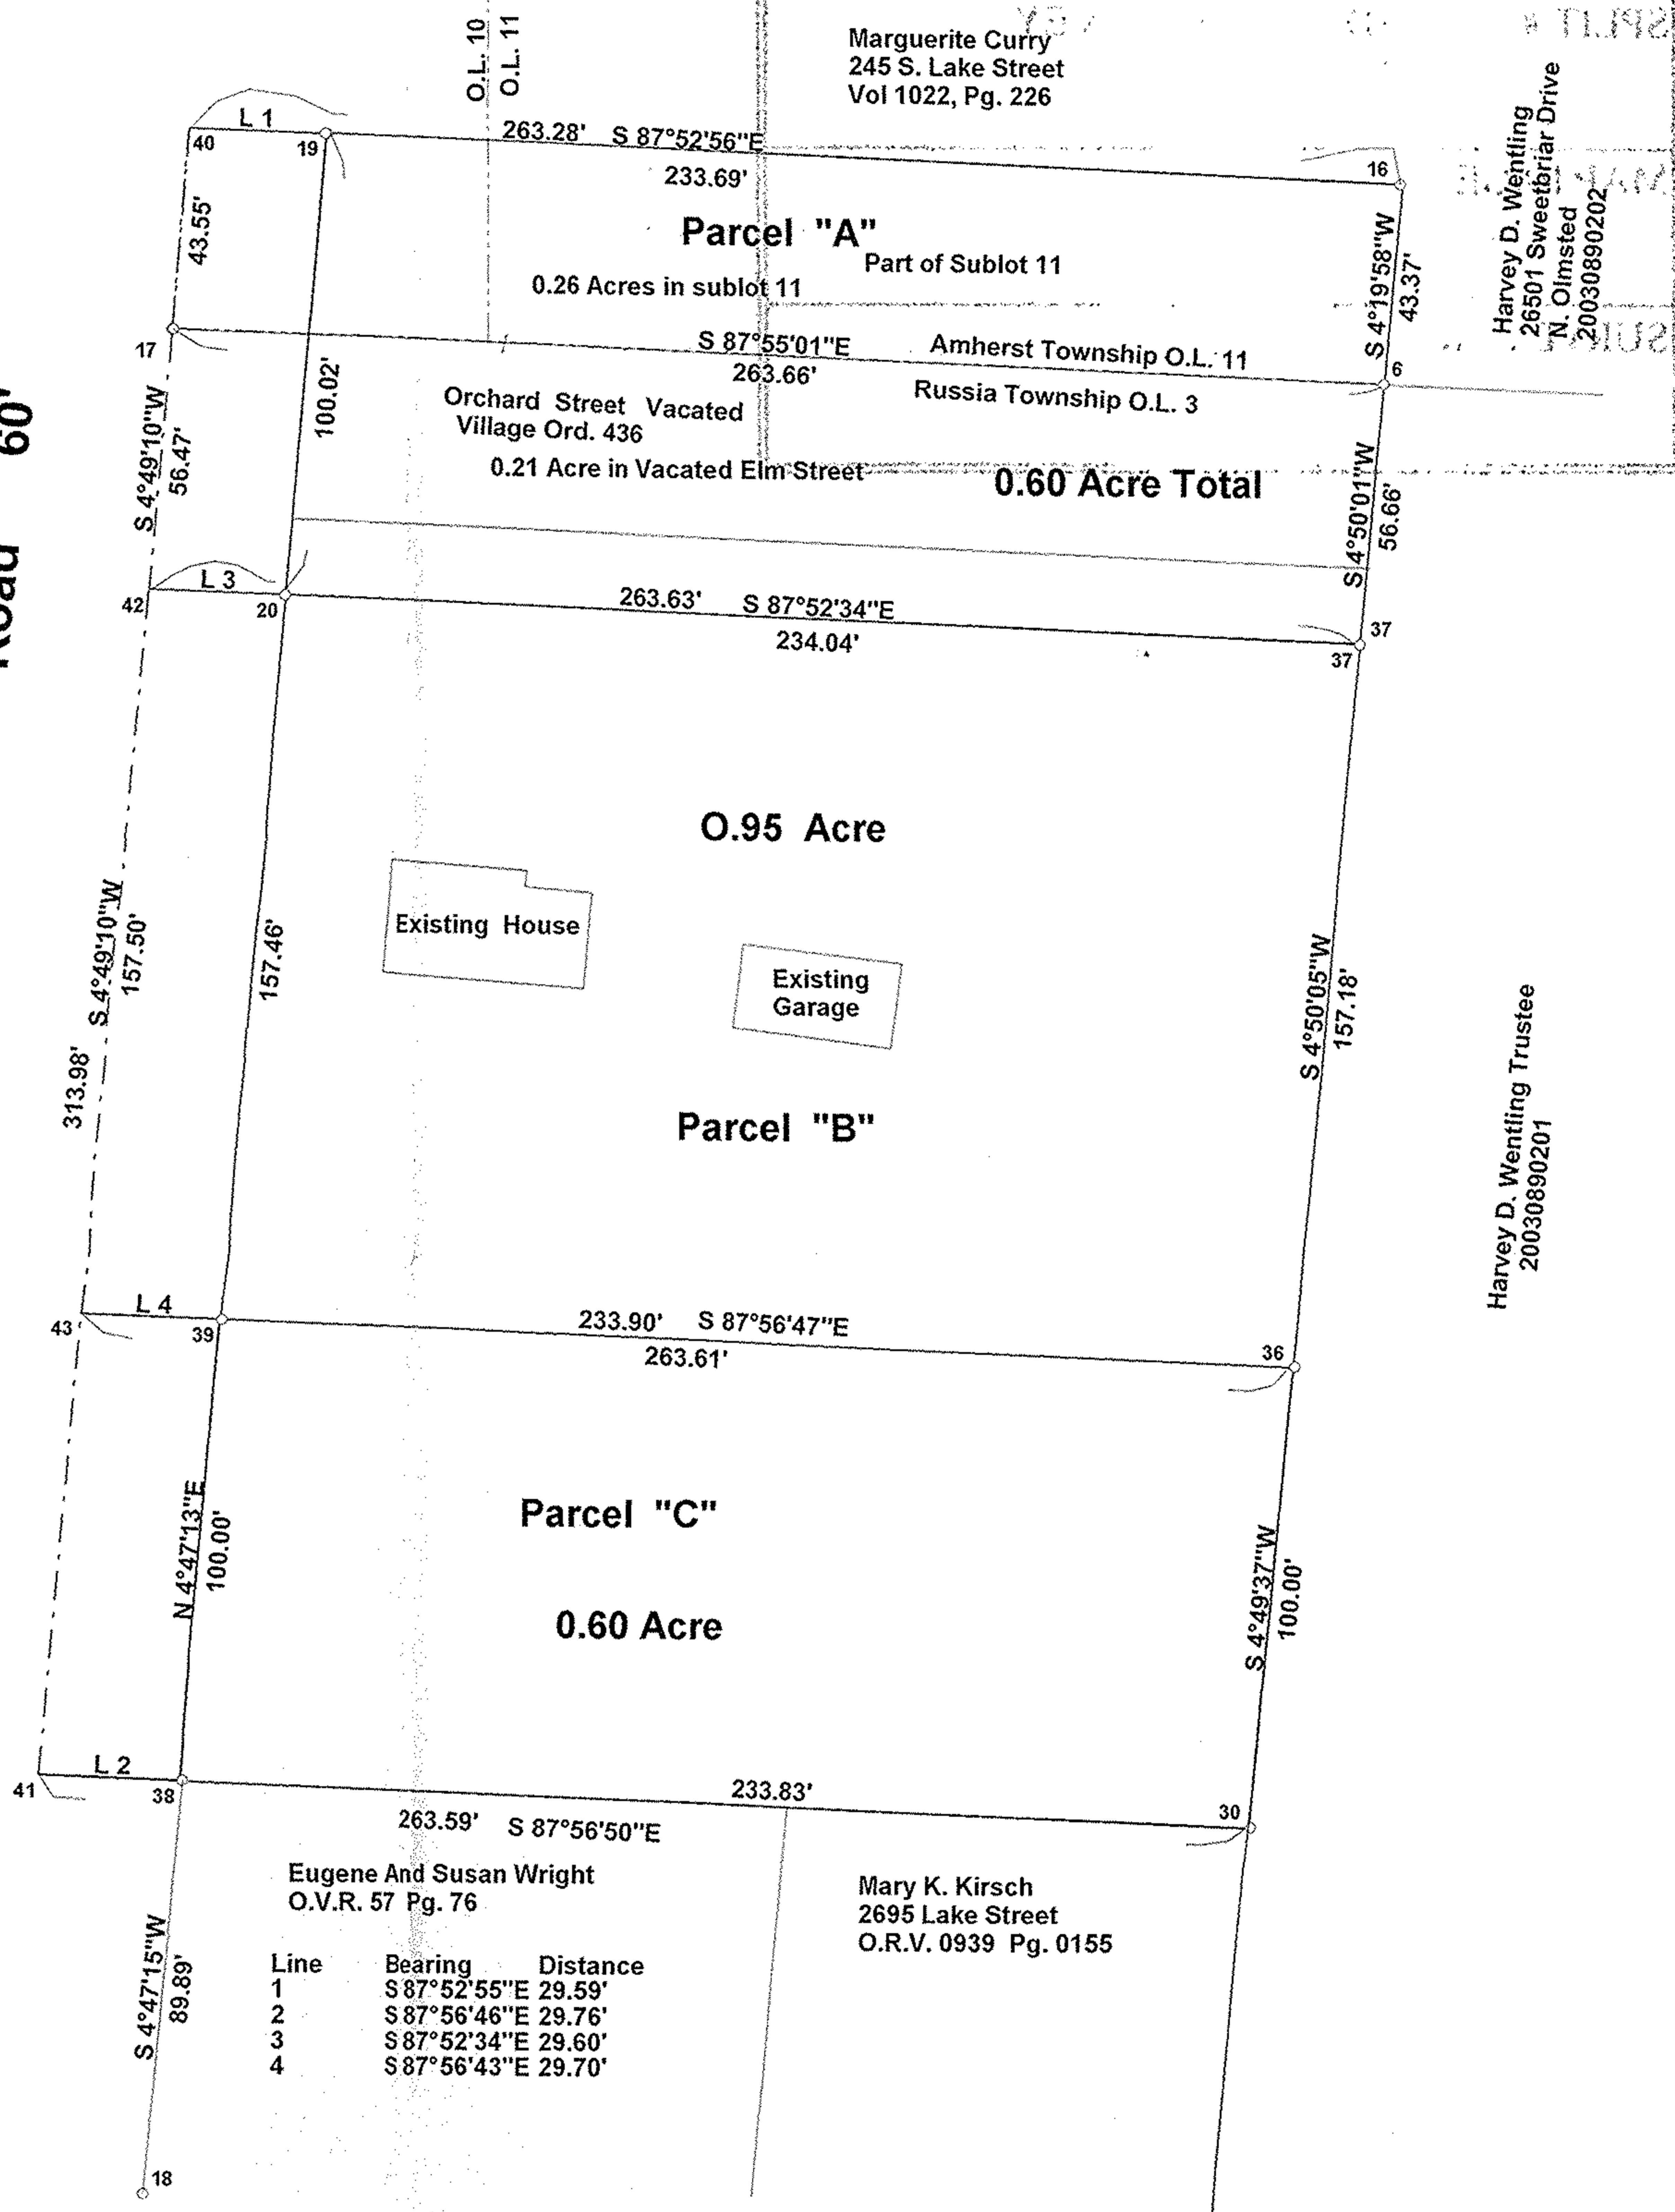

Line	Bearing	Distance
1	S 87° 52' 55" E	29.59'
2	S 87° 56' 46" E	29.76'
3	S 87° 52' 34" E	29.60'
4	S 87° 56' 43" E	29.70'

Boundary Survey
Patrick A. McGannon
Registered Professional Surveyor

1731 Gettysburg Drive, Lorain, Ohio 44053

(440)-2822712

