


West Ridge Rd. 60



- ⊗ = Iron Pin Set
- = Iron Pin Found as noted
- ⊠ = Monument Box

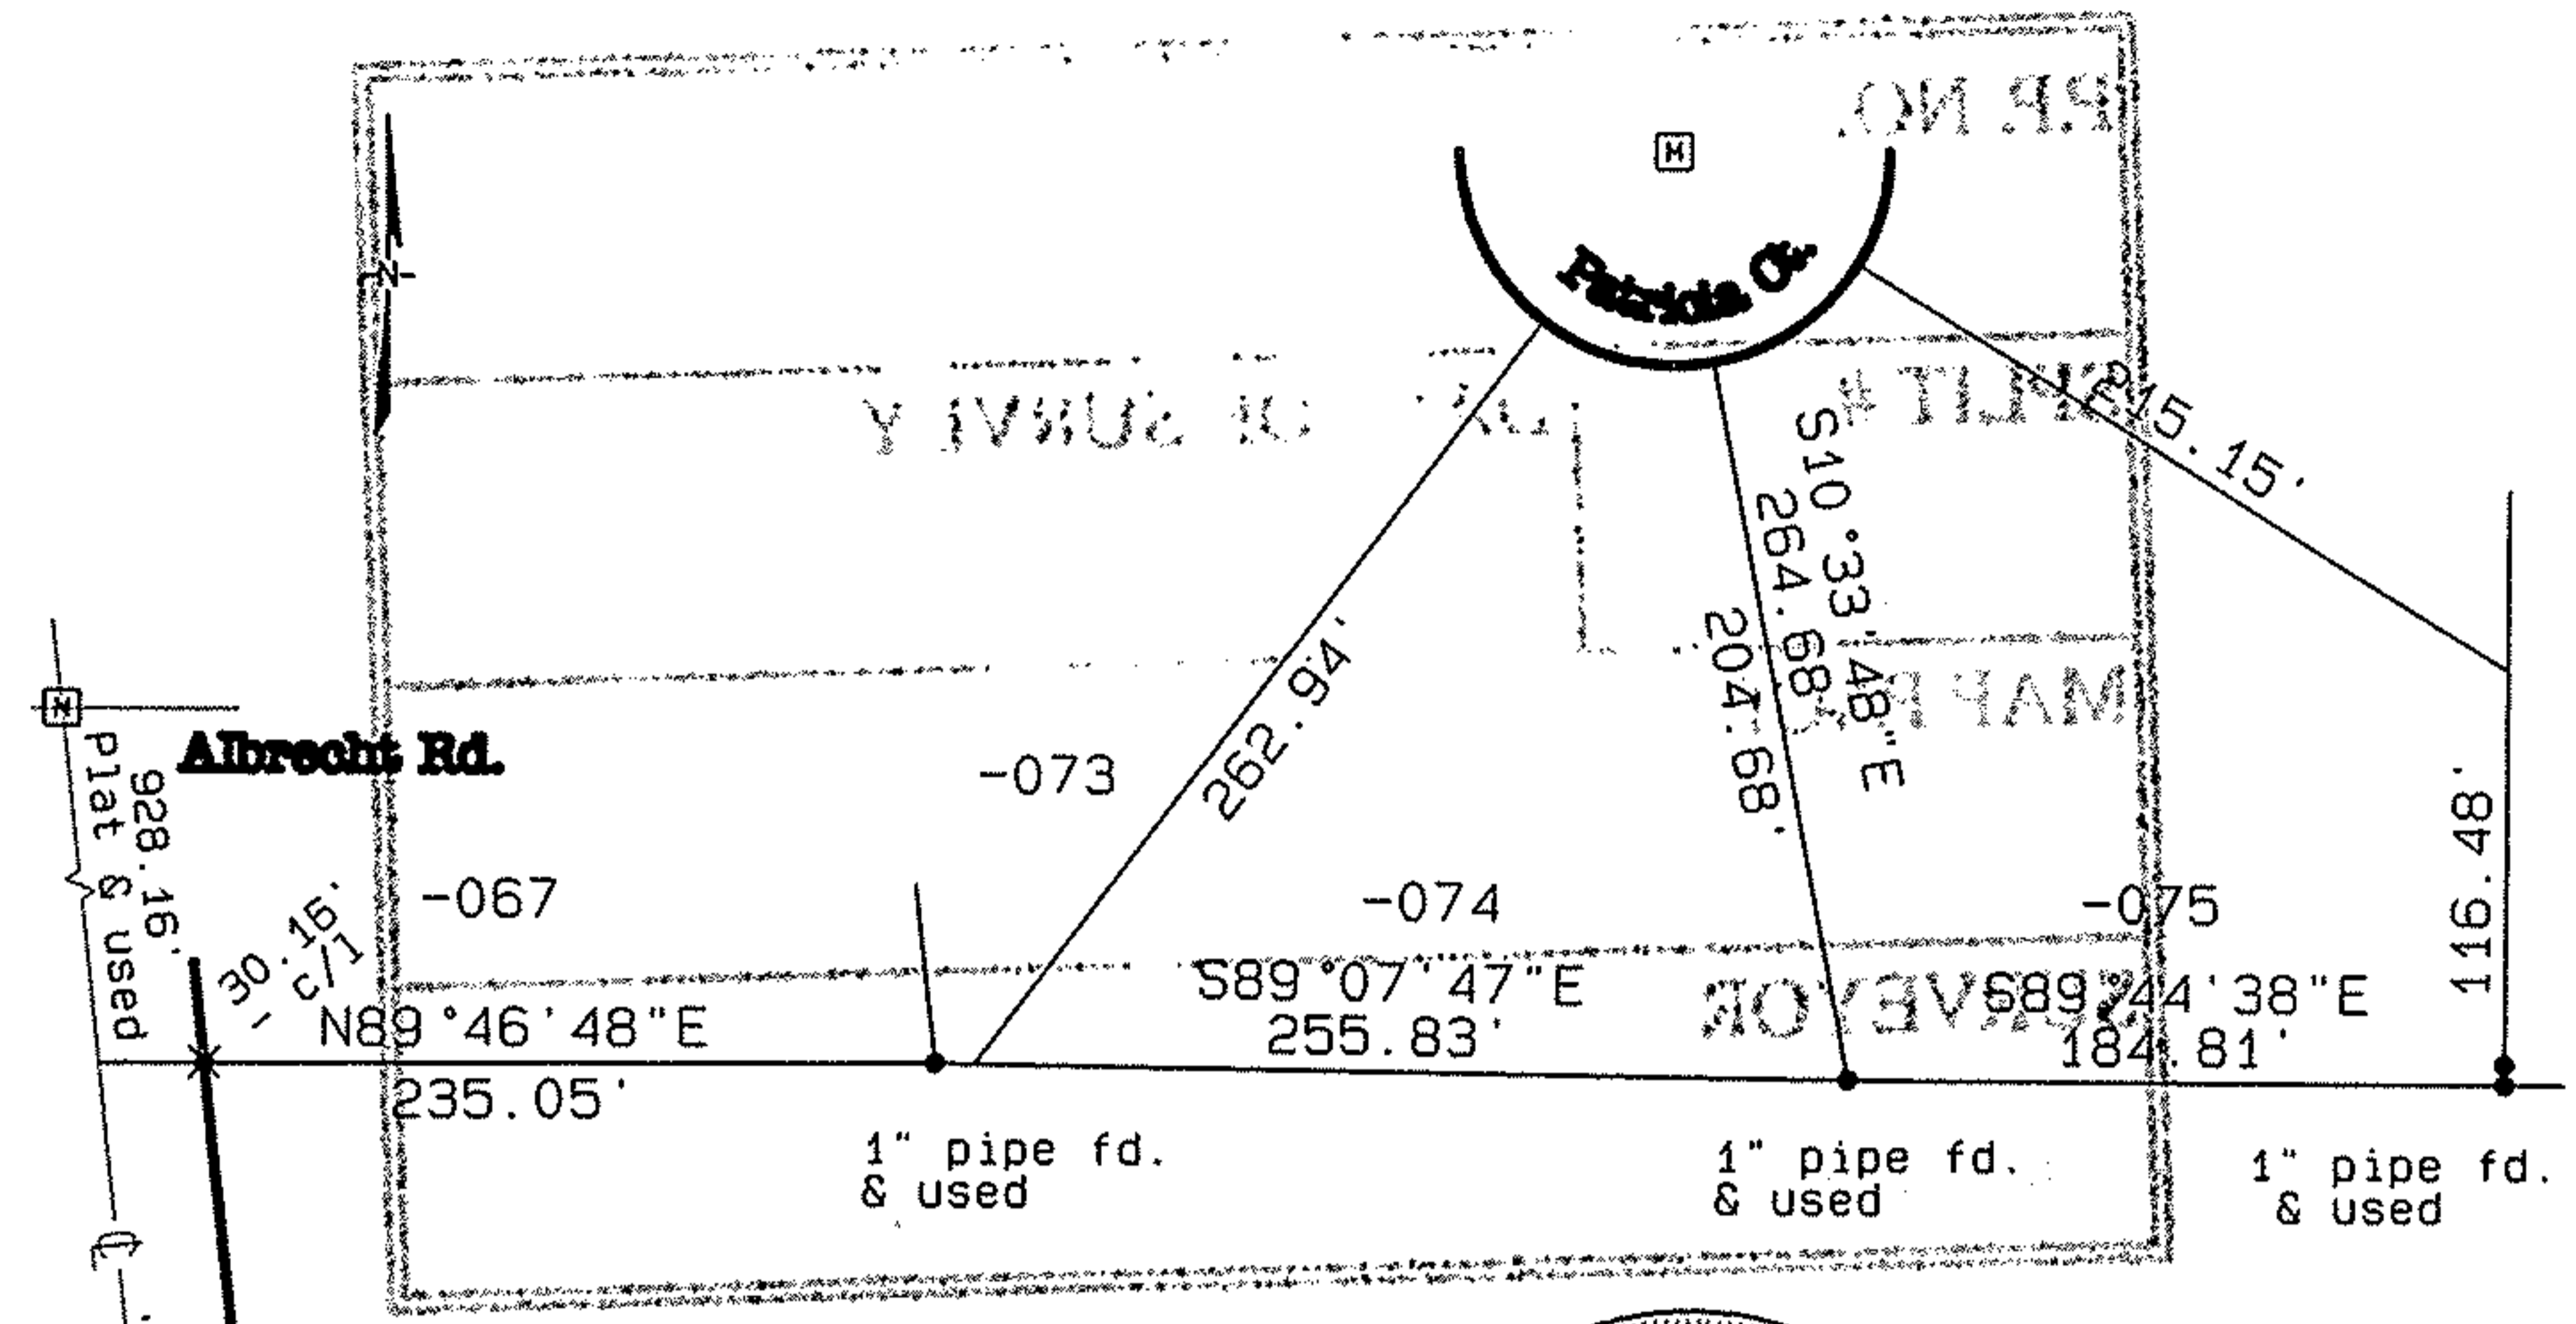

Richard D. Carlson R.S.
 11-4-06
Carlson Surveys

November 2006
 Job: 1002-15R

Rem. -002
 35.77 ac.

No 02283
 11-5-06
 10-00-001-C
 #06-02283

Plat of Survey for **John Forthofer**

Carlsile Twp.
 Lorain Co. Section 1
 Ohio

GRAPHIC SCALE 1"=100'

