

Part of Part of Lot 45 Amberst Twp. Lorain Co. Ohio
Scale 1" = 100'

Dec. 4, 1976
By Arnold P. Koepf Registered Surveyor

05-00-045-000

#10218

05-00-045-

Walter Kramer et al Vol 1120-692

N71°25'W

776.06

Joseph & Irene Miller Vol 644 Pg 386


3.62 Ac ±

William & Augusta Duggan Vol. 432.15

981.20

JAN 21 1977

10218

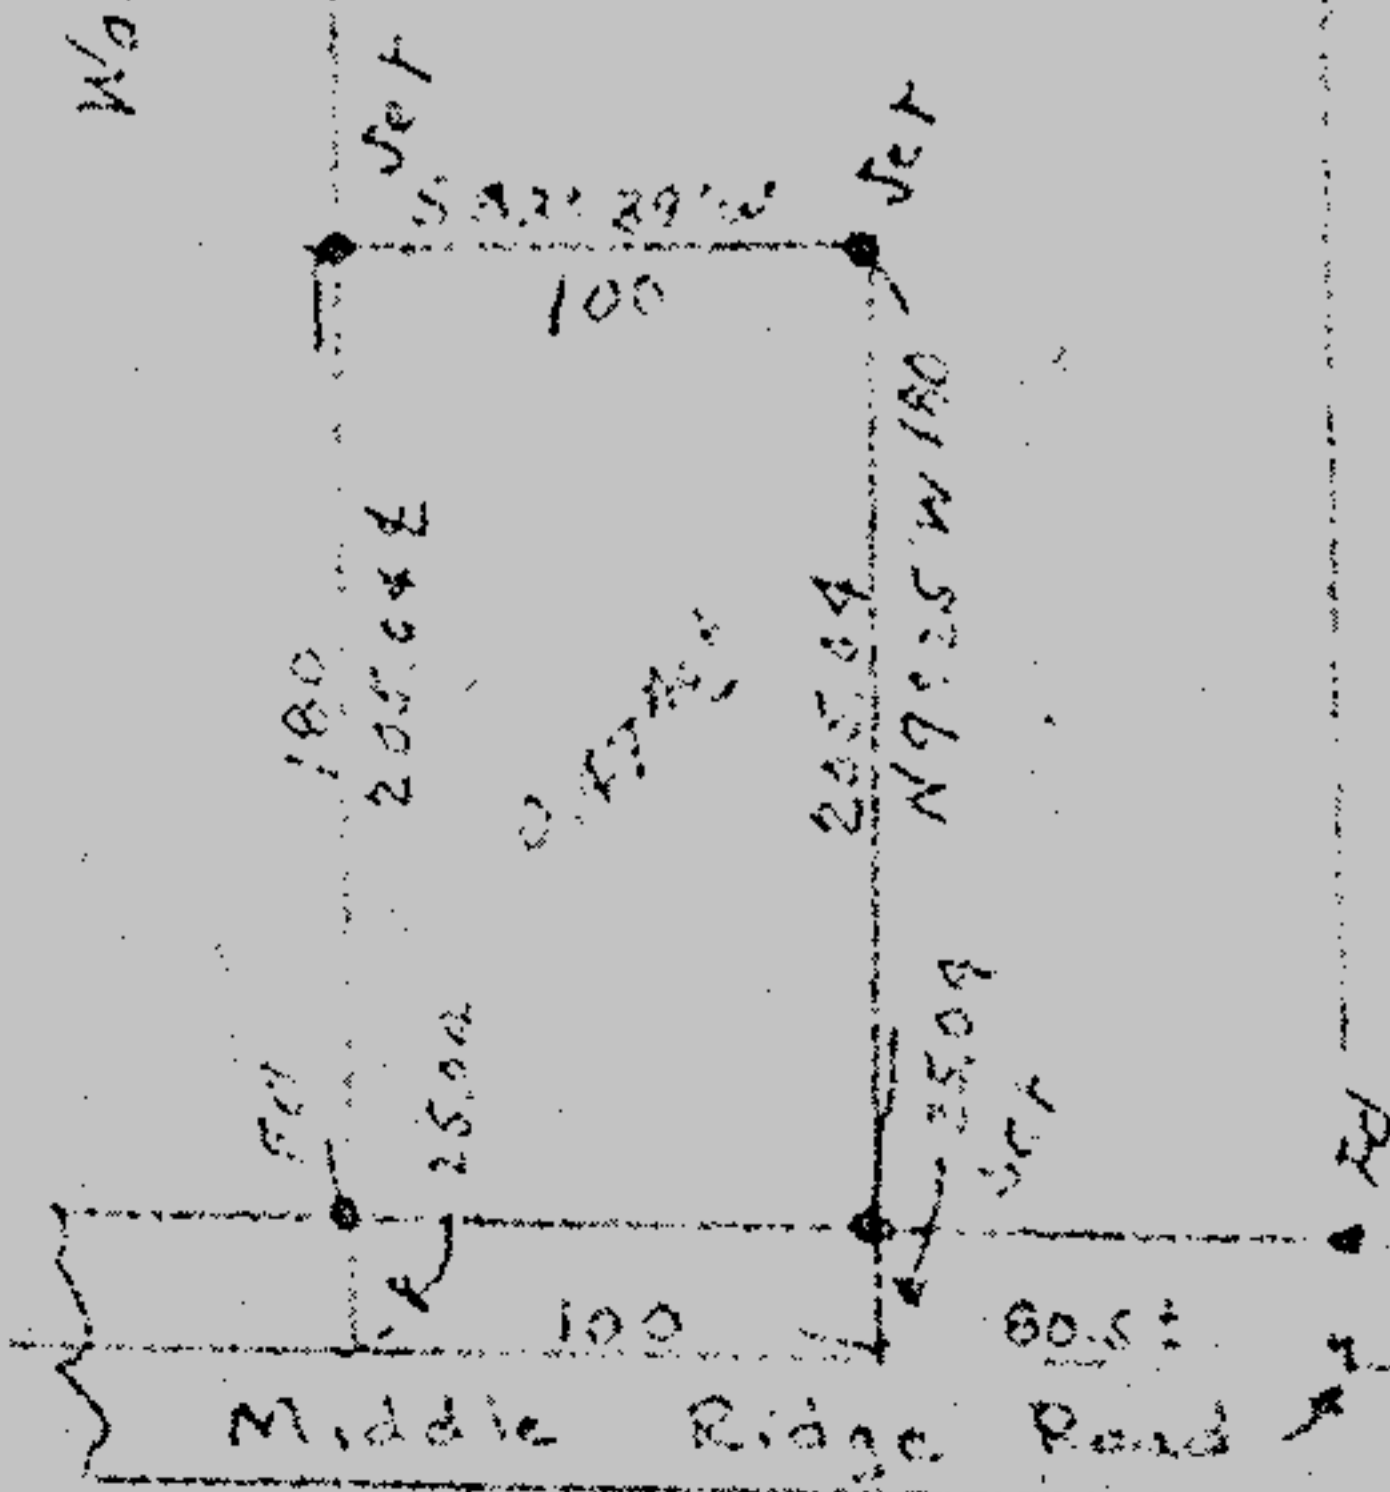

APPROVED
Lowell A. Kneisel - Engr. Dept.

APPROVED BY THE LORAIN CITY PLANNING
COMMISSION NO FLAT REQUIRED

Tom Rodgers
SECRETARY LORAIN CITY PLANNING COMMISSION