


No 02551

APPROVED
LORAIN CO.
MAP DEPT


DATE 4-9-08

PAGE 18-00-018-Ac

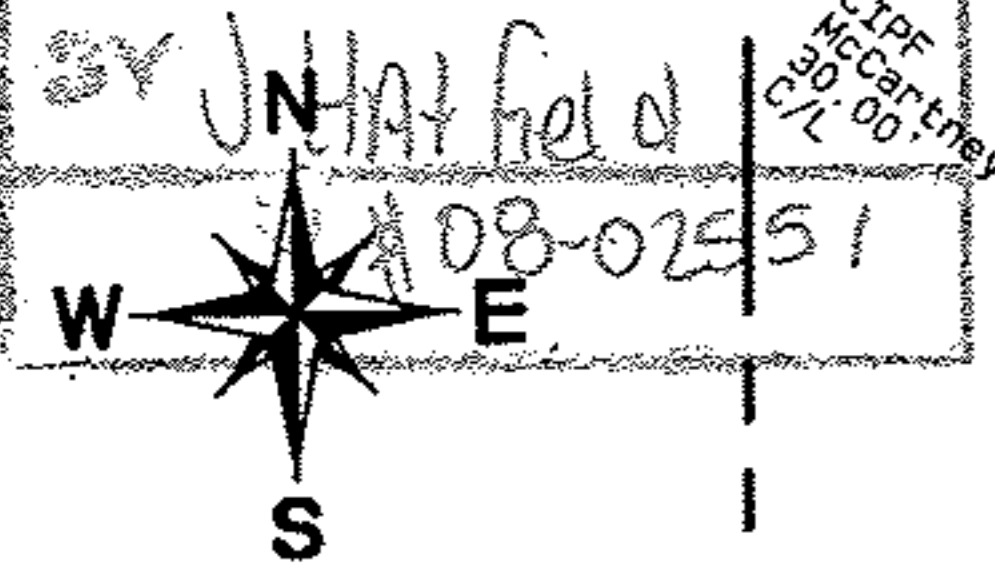

CIPF= Capped Iron Pin Found, as noted.
RRS= Railroad Spike
IPS= Iron Pin Set w/cap stamped Carlson

Webster Rd. 60'

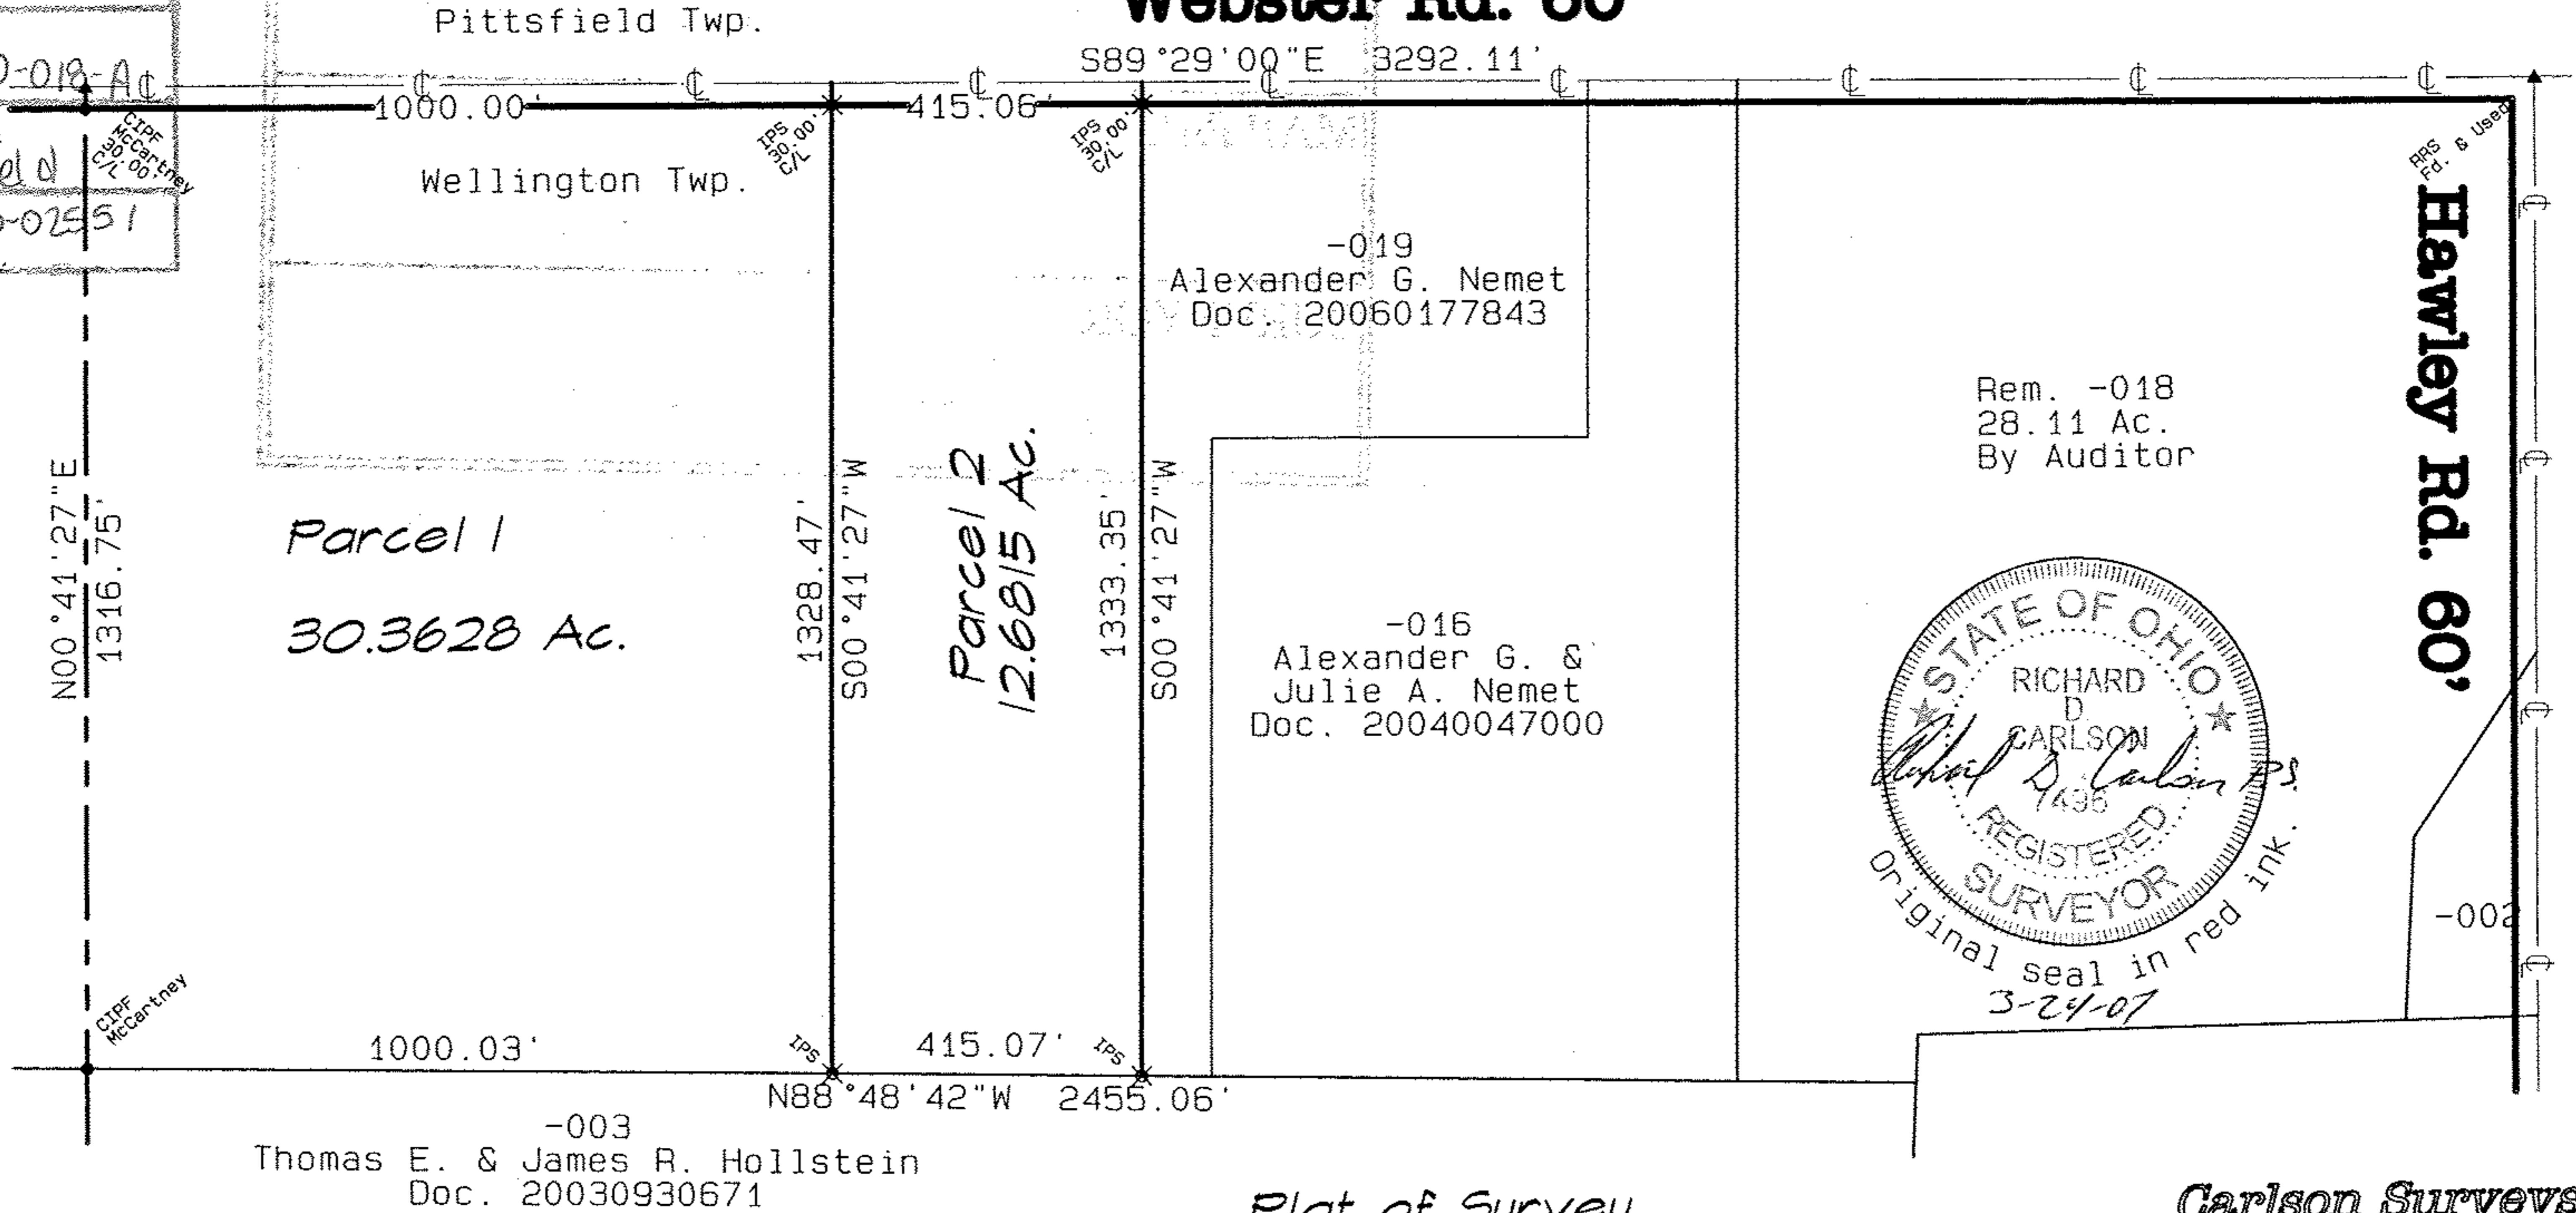

Plat of Survey

Tim & Raeann Pieper

Carlson Surveys

November 2007

Prior survey: McCartney & Assos.
Dec. 2003

GRAPHIC SCALE 1"=300'



Wellington Twp.
Lorain Co.

O.L. 18
Ohio