

Mon. Box Fd.


MILAN-ELYRIA RD. (S.R. 113)

08-00-090-000-041 29.58 A.  
John Gede, John E. Gede,  
Paula A. Kuhn, Trustee  
2007-0208183 1/2" I.R. set

50' WIDE EASEMENT  
GAS TRANSPORT INC.  
1999-0641593

200' WIDE EASEMENT  
OHIO EDISON 75' W, 125' E. of &  
V. 765, P. 272  
Steve Gede 1/8/60

NORTH

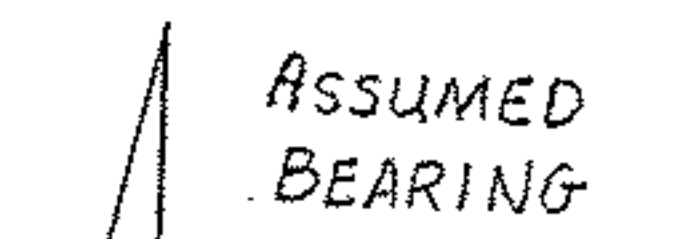

SCALE  
1" = 100'



BAUMHART ROAD (60')

N 3° 47' 05" W

300.00' R., M.

125.00' R., M.

436.20'

501.00'

N 89° 19' 00" E 923.34' R., M.

-040 7.87 A.  
Donald J. Gede  
2007-0217265  
2007-0217267

PARCEL "A" 6.3228 Ac.

S 89° 19' 00" W 915.50'

N 89° 19' 00" E 375.00'

-017 1.07 A.  
Donald J., Patricia A. Gede  
V. 1279, P. 689

N 89° 19' 00" E 540.50'

PARCEL "B" 1.5438 Ac.

S 89° 19' 00" W 375.00'

S 89° 19' 00" W 537.23' Rec., M.

-037 5.01 A.  
Tracy C., Jennifer D. Cairns  
2006-0163294

N 3° 47' 05" W  
125.00'

912.23'

-038 4.00 A.  
Timothy D., Shelly A. Lee  
2003-0914968

436.20'

411.23'

STEFAN ALLOT.  
P.V. 17, P. 22  
Sublot No. 1 2

-007  
Timothy D., Shelly A. Lee  
2003-0914968

0. LOT 90  
0. LOT 89

435.09' Msd.  
435.60' R.

Easement Line

Grasline

High Tension Line

Easement Line

1" I.P.Fd.  
30.04'

0. L. 89  
100'

100'

501.00'

389.00' 0. L. 90

RUSSIA ROAD (60')  
S 89° 19' 00" W

No 02554

APPROVED  
LORAIN CO.  
MAP DEPT

DATE 4-21-08  
08-00-090-000-040  
PAGE 8 00-090-3

BY J Hatfield  
#08-07554

Permanent Parcel No.  
08-00-090-000-017,  
08-00-090-000-040

MAP OF SURVEY  
MADE  
Part of Orig. Lot No. 90  
Henrietta Twp., Lorain Co., Ohio  
For Donald J. Gede Feb. 2008

Charles P. Waryu  
Registered Surveyor  
No. 5029

Mon. Box Fd. used

M.B. Fd. used