


1777

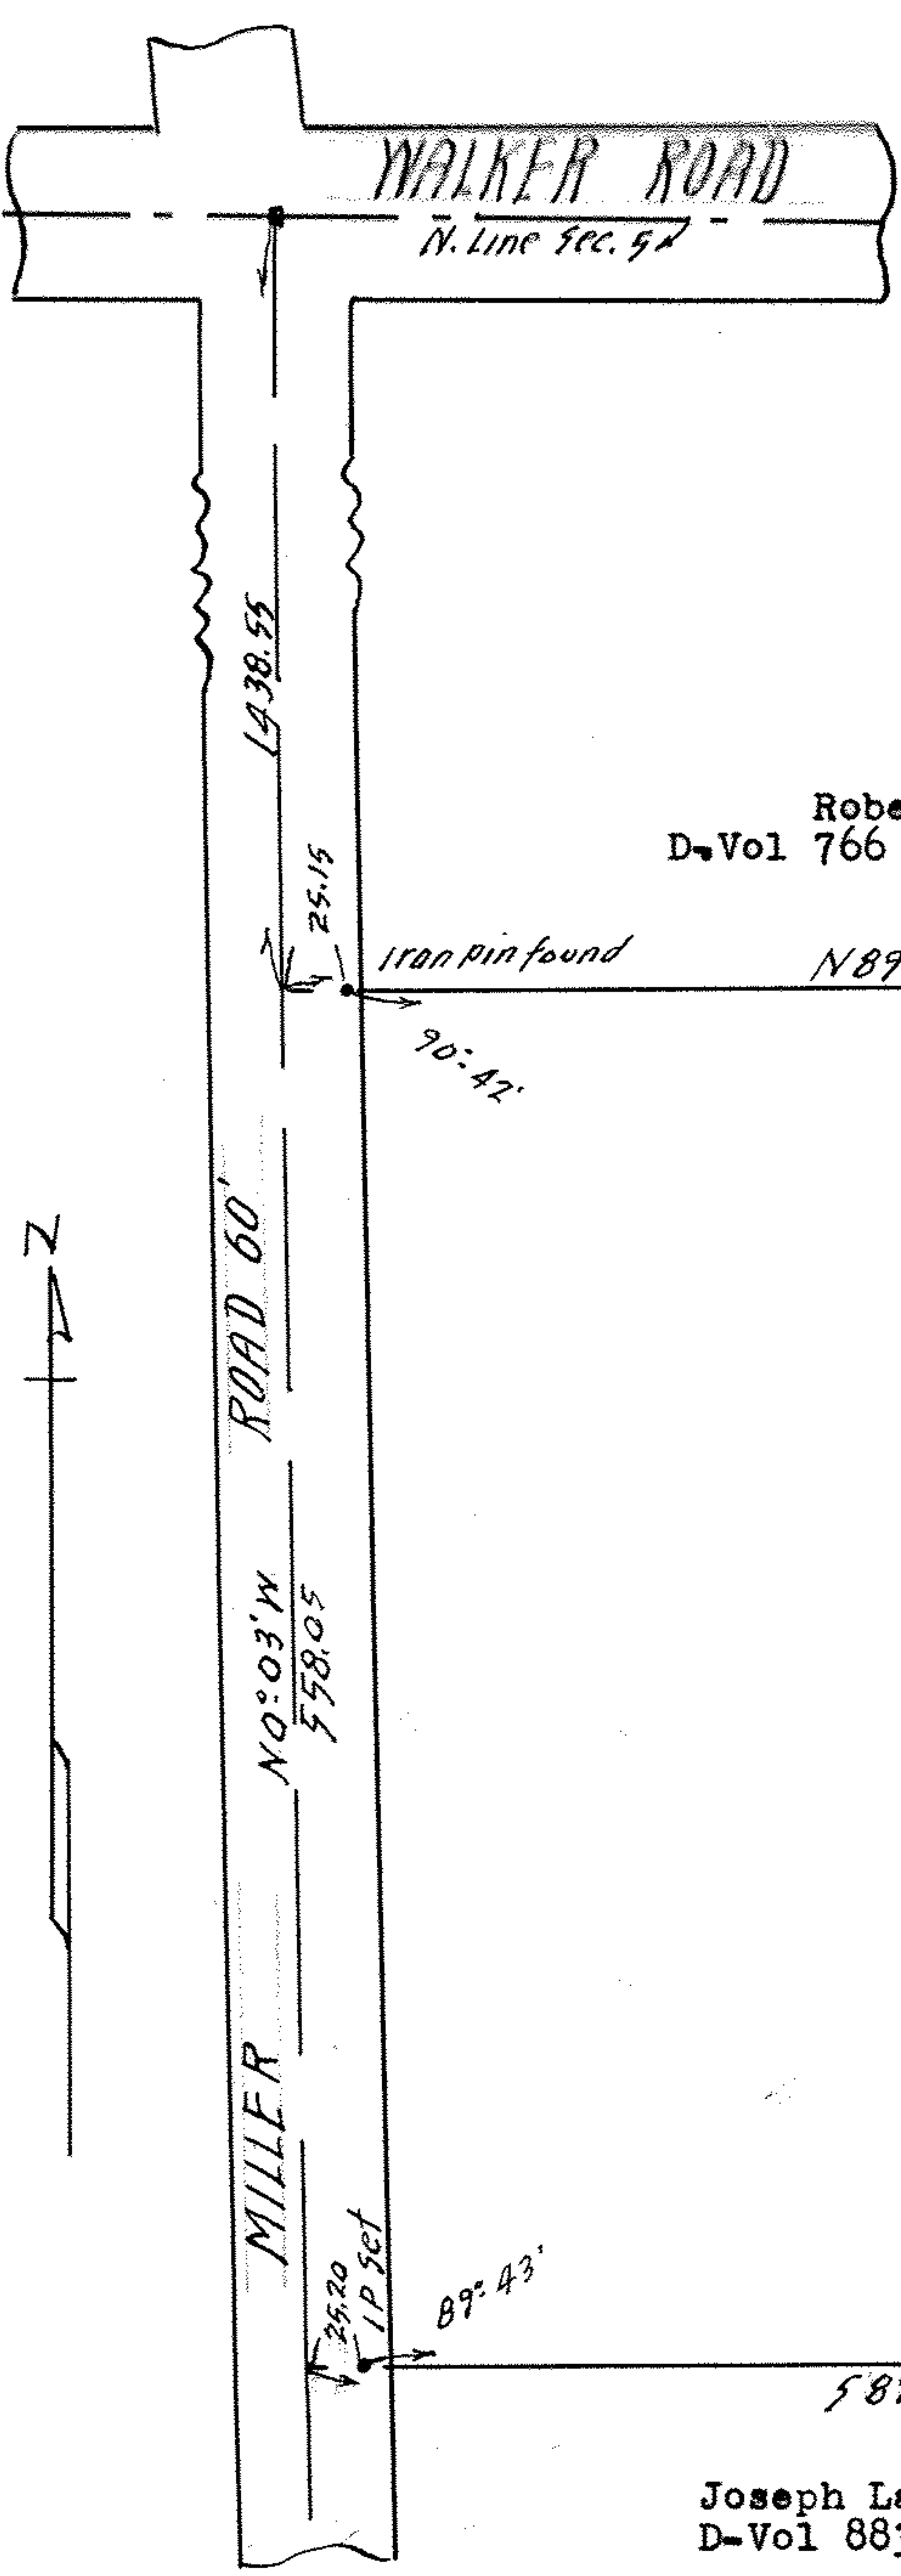

PPN 04-00-005-000-7??

MAP PG 4-00-005-B

Robert Wolf
D-Vol 766 Pg. 714 Feb. 9, 1960

8.585 Ac

Joseph Laeh Construction Co.
D-Vol 883 Pg. 135 July 14, 1964

SURVEY FOR
ELECTRIC CORD SETS INC.
ORIGINAL SECTION 5 AVON TOWNSHIP
CITY OF AVON LAKE LORAIN COUNTY OHIO
SCALE 1" = 100' DEC 29, 1964
J. W. WARDEN AND ASSOCIATES REG SURVEYORS

Survey ordered by Land Title.

401464