

Handwritten: 12-1529

# J. W. WARDEN & ASSOCIATES

STATE OF OHIO


CIVIL ENGINEERS AND SURVEYORS

REGISTERED { PROFESSIONAL ENG.  
SURVEYOR

D. D. ANDRUS, PRESIDENT  
405 ELYRIA BLOCK  
ELYRIA, OHIO

TELEPHONES FA 2-9828  
FA 2-1466

M. W. JACKSON  
SECRETARY

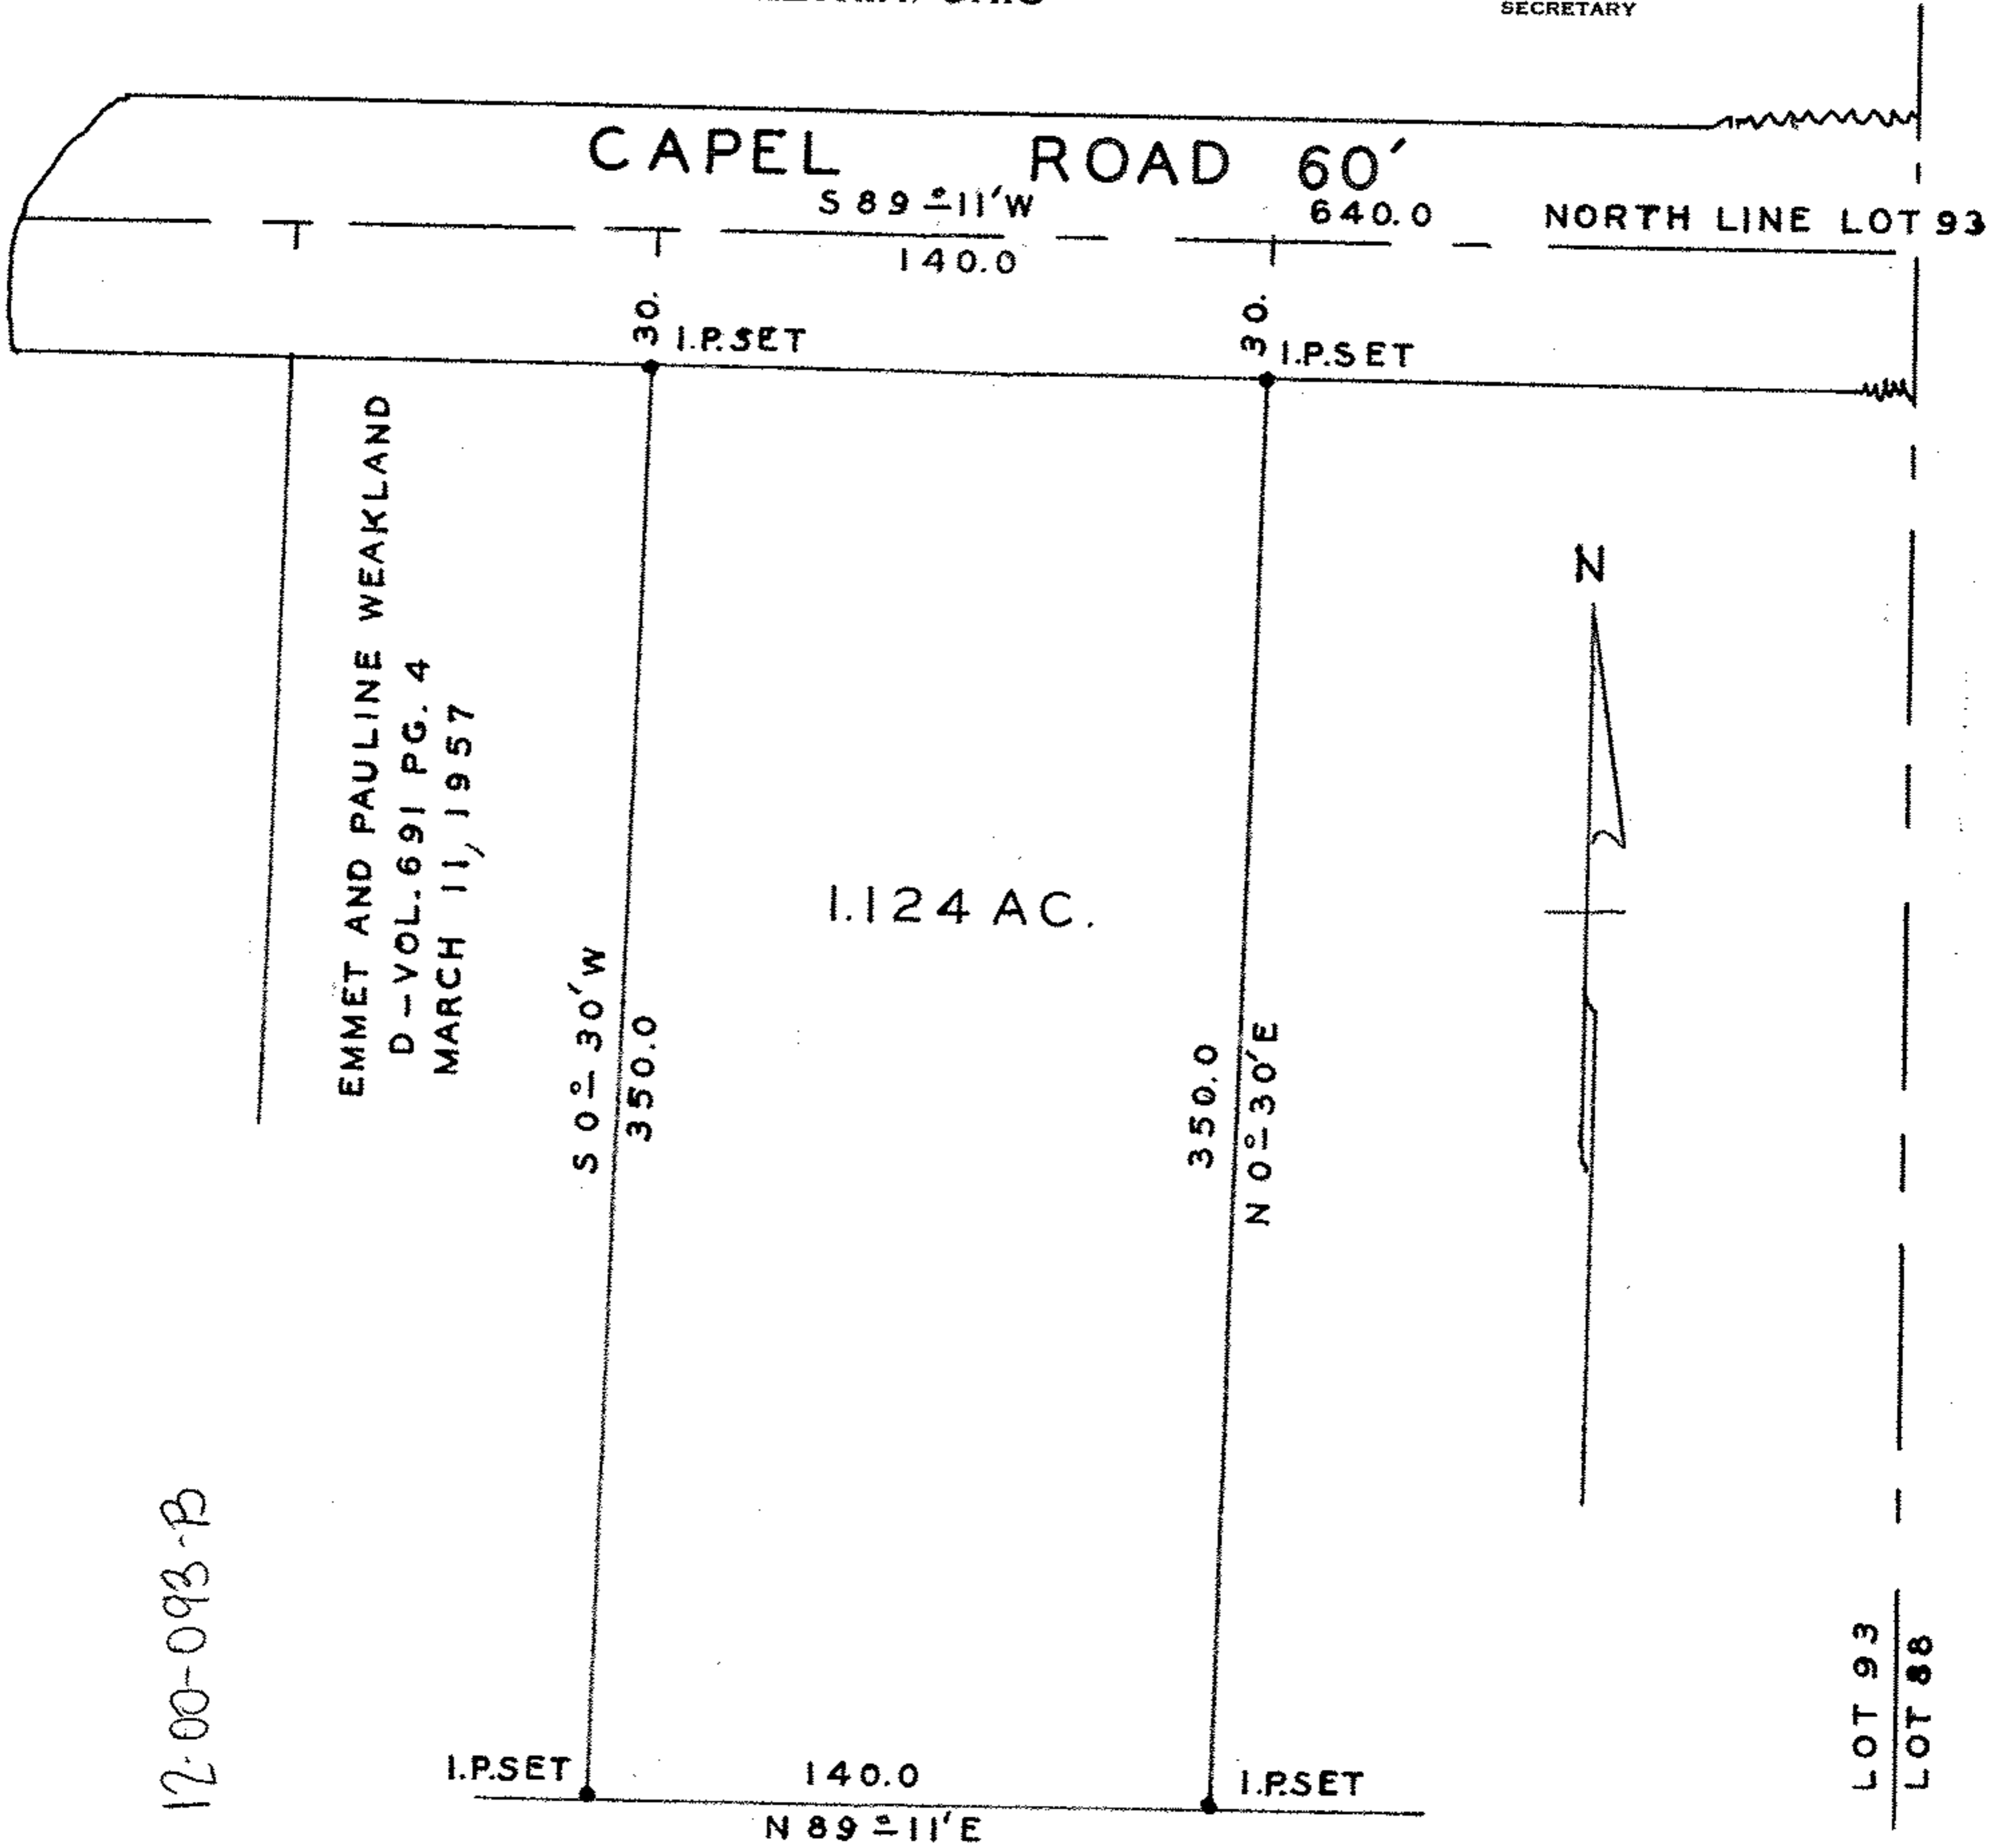

EMMET AND PAULINE WEAKLAND  
D - VOL. 691 PG. 4  
MARCH 11, 1957

1.124 AC.



PPN 12-00-093-000-013

MAP PG 12-00-093-B

SURVEY FOR  
LEON A. AND LOIS M. SMITH  
D-VOL 600 PG. 75 FEB. 24, 1954  
LOT 93 COLUMBIA TOWNSHIP  
LORAIN COUNTY, OHIO  
SCALE 1" = 60' FEB. 21, 1962

LOT 93  
LOT 88

Handwritten: 40 1253 B