

JOHN W. WARDEN

CIVIL ENGINEER AND SURVEYOR

405 ELYRIA BLOCK

ELYRIA, OHIO

STATE OF OHIO


REGISTERED } PROFESSIONAL ENG.
SURVEYOR

PHONES

BUSINESS 3211

RESIDENCE 38633

*Survey of
 Sub. Lots 111-112 Mendelson Allotment
 Map Vol. 7 - Pg 23
 Original Lots 51-52 West of Black River
 Elyria City, Lorain County Ohio.
 Scale 1" = 40' Feb. 3, 1947.*

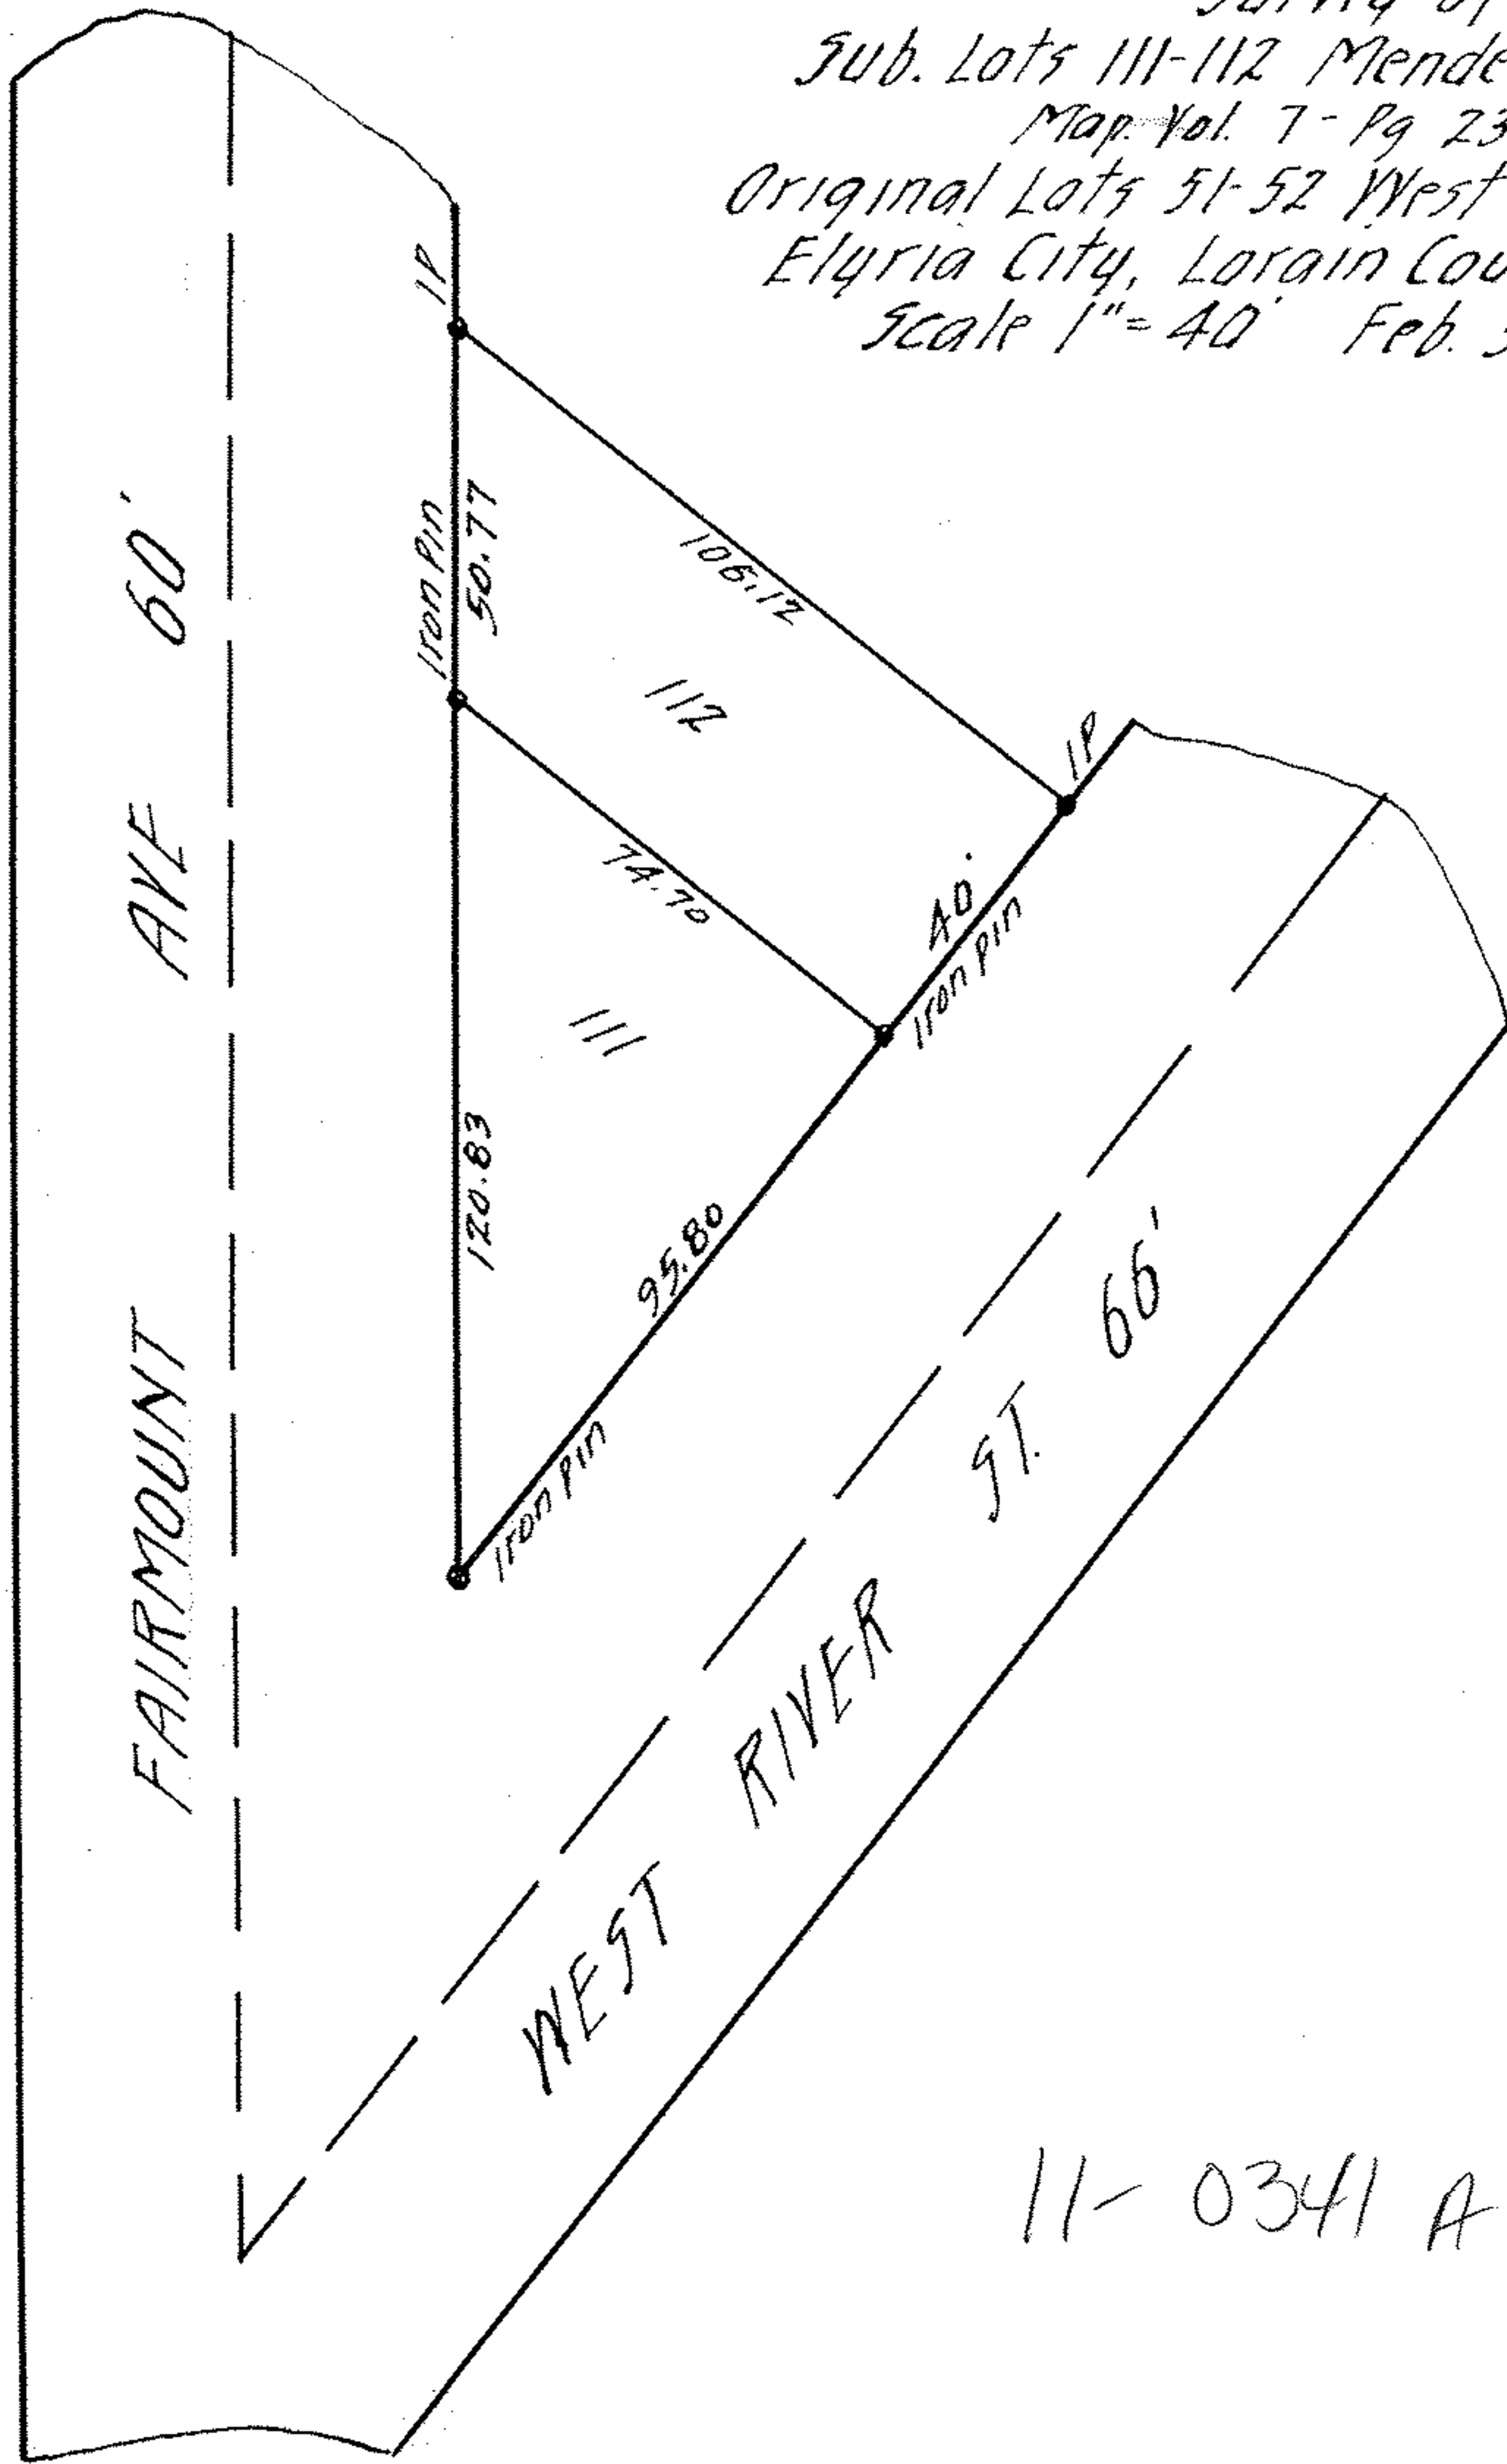

11-0341 A